


Additional Images:

N-229: Experimental Fluid Dynamics Facility

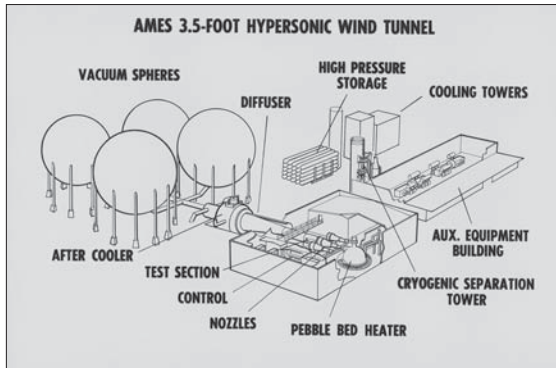

N-229, Drawing of Ames 3.5-Foot Hypersonic Wind Tunnel, 6 November 1961
(Source: NASA Ames Research Center, A-28418)




N-229, Aerial photograph, 5 July 1977
(Source: NASA Ames Research Center, AC77-0846-43)



N-229, south facade, main entry
(Source: Page & Turnbull)




N-229, north facade, vacuum spheres
(Source: Page & Turnbull)

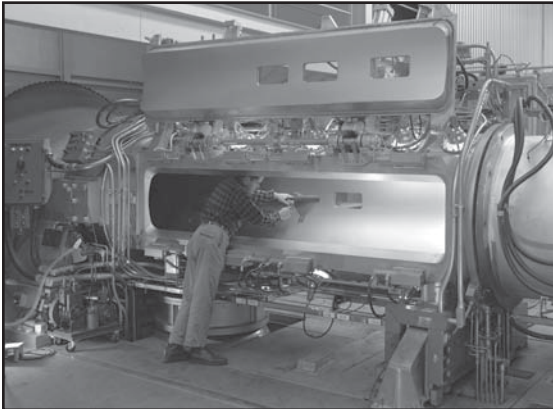

N-229, M-1 Model of Reentry body in 3.5-Foot Hypersonic Wind Tunnel throat,
21 March 1962
(Source: NASA Ames Research Center, A-29007)



N-229, Space Shuttle Orbiter Model 140A/B-0A87 testing in 3.5-Foot Hypersonic Wind Tunnel, 19 October 1973
(Source: NASA Ames Research Center, AC73-5027)

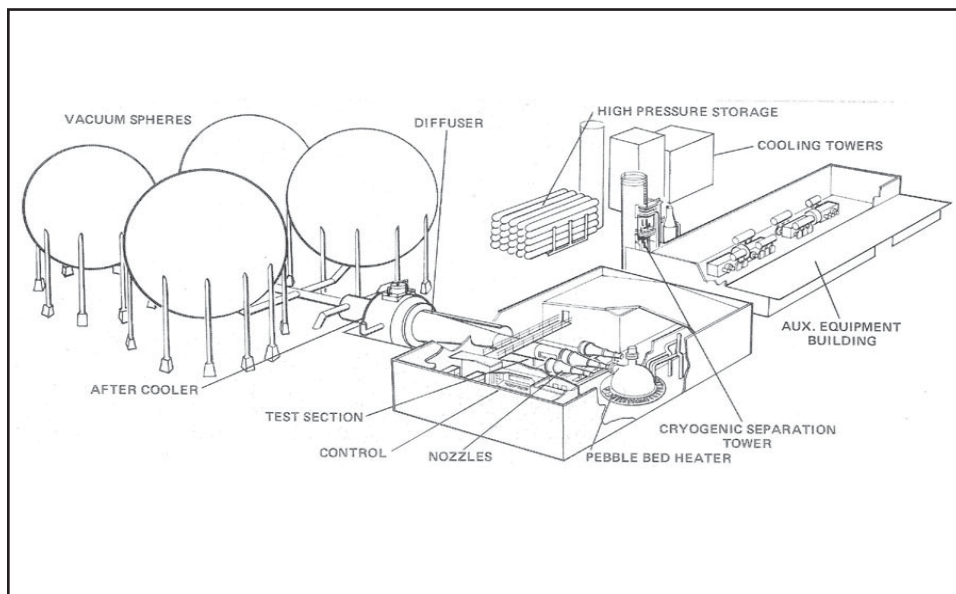

N-229, Diagram of 3.5-Foot Hypersonic Wind Tunnel
(Source: NASA Ames Facilities Summary, 1974)

Architectural Drawings for N-229

3.5-Foot Hypersonic Wind Tunnel, Test Chamber, Perspective

Architect: John Sardis & Associates, Engineers

Date: 30 October 1958

Sheet: A 112 DO

NASA EDC # 229-5901-A1

3.5-Foot Hypersonic Wind Tunnel, Test Chamber, Plot Plan

Architect: John Sardis & Associates, Engineers

Date: 30 October 1958

Sheet: A 112 D1

NASA EDC # 229-5901-A2

3.5-Foot Hypersonic Wind Tunnel, Test Chamber, First Floor Plan and Schedules

Architect: John Sardis & Associates, Engineers

Date: 20 October 1958

Sheet: A 112 D2

NASA EDC # 229-5901-A3

3.5-Foot Hypersonic Wind Tunnel, Test Chamber, Elevations and Sections

Architect: John Sardis & Associates, Engineers

Date: 30 October 1958

Sheet: A 112 D6

NASA EDC # 229-5901-A7

3.5-Foot Hypersonic Tunnel Office Building, Perspective

Architect: Rosener Engineering Incorporated

Date: 12 June 1958

Sheet: A11262-D1

NASA EDC # 229-5902-A1

3.5-Foot Hypersonic Tunnel Office Building, First Floor Plan and Schedule

Architect: Rosener Engineering Incorporated

Date: 2 December 1958

Sheet: A11262-D2

NASA EDC # 229-5902-A2

3.5-Foot Hypersonic Tunnel Office Building, Second Floor & Roof Plans & Schedule

Architect: Rosener Engineering Incorporated

Date: 2 December 1958

Sheet: A11262-D3

NASA EDC # 229-5902-A3



3.5-Foot Hypersonic Tunnel Office Building, Exterior Elevations and Cross Sections

Architect: Rosener Engineering Incorporated

Date: 2 December 1958

Sheet: A11262-D4

NASA EDC # 229-5902-A4

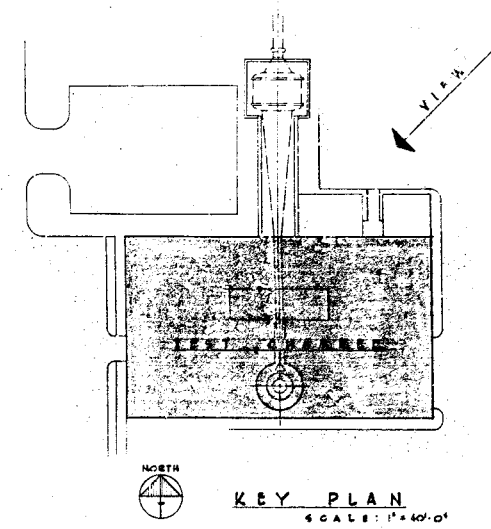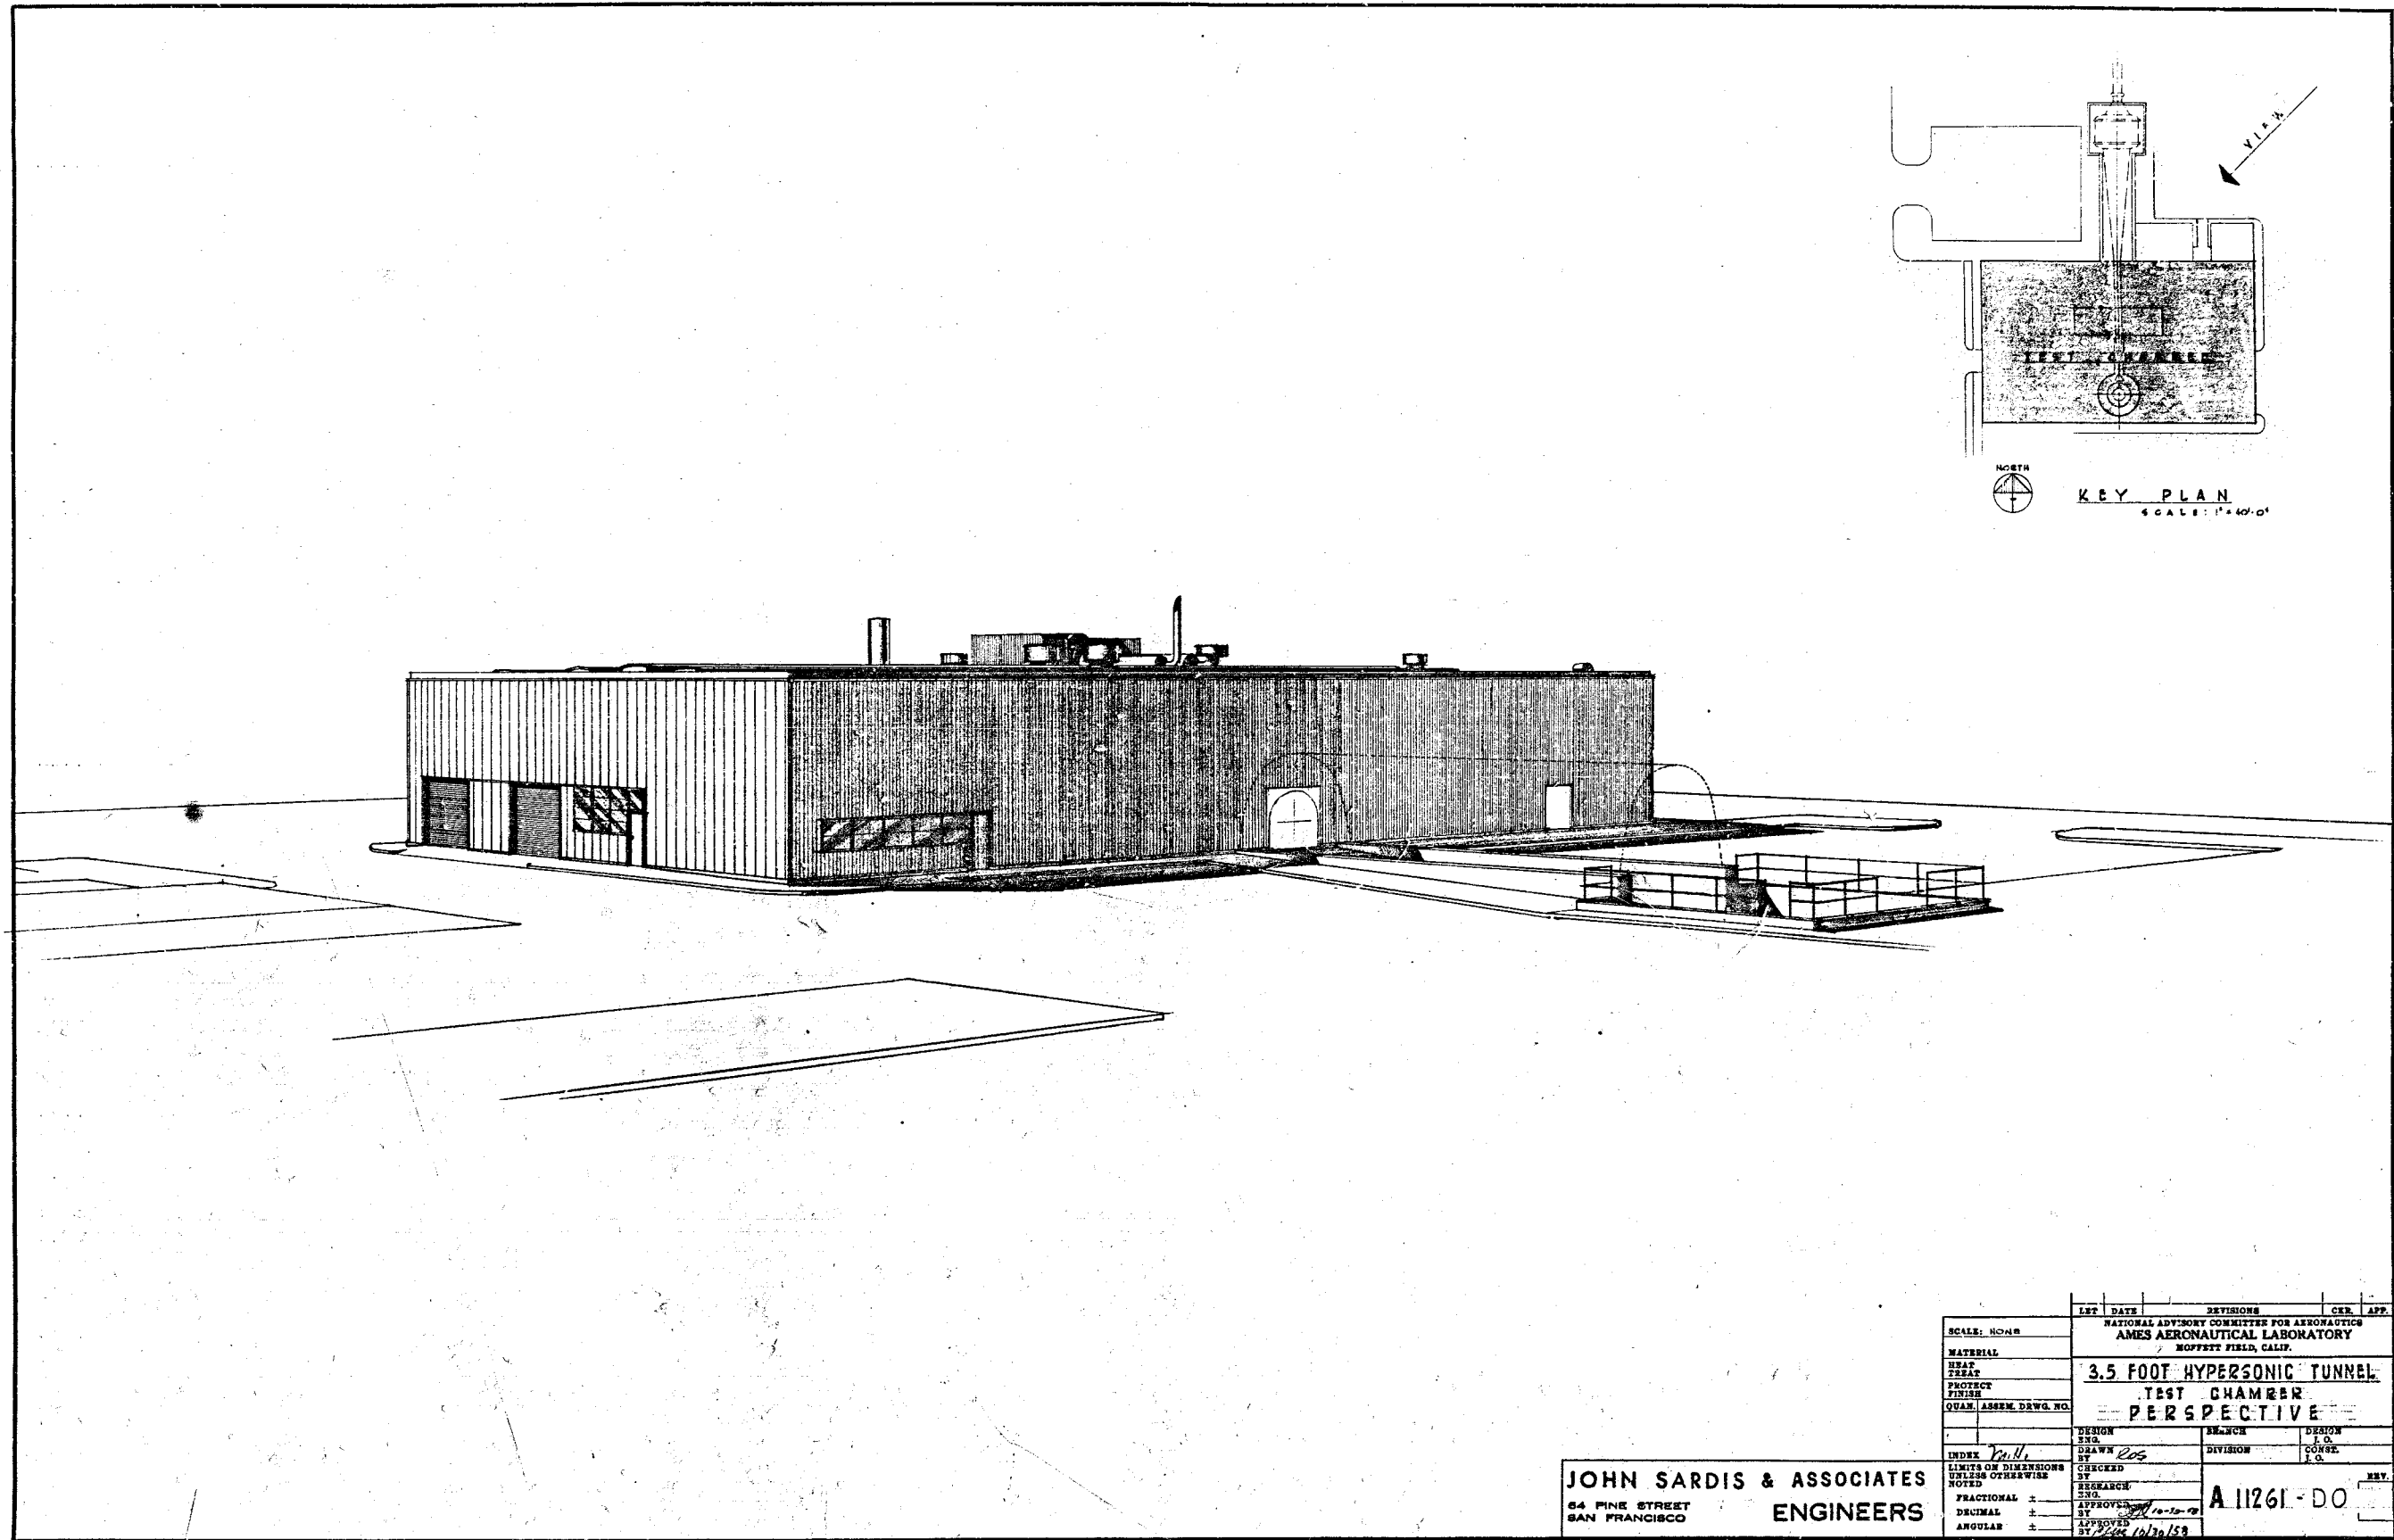

JOHN SARDIS & ASSOCIATES
 64 PINE STREET
 SAN FRANCISCO
ENGINEERS

LET	DATE	REVISIONS	CHK.	APP.
NATIONAL ADVISORY COMMITTEE FOR AERONAUTICS AMES AERONAUTICAL LABORATORY MOFFETT FIELD, CALIF.				
3.5 FOOT HYPERSONIC TUNNEL				
TEST CHAMBER				
PERSPECTIVE				
SCALE: NONE	DESIGN BY	BRANCH	DESIGN I.O.	REV.
MATERIAL	DRAWN BY	DIVISION	CONSTR. I.O.	
HEAT TREAT	CHECKED BY			
PROTECT FINISH	RESEARCH NOTED			
QUAN. ASSEM. DRWG. NO.	FRACTIONAL ±	APPROVED BY		
	DECIMAL ±	DATE		
	ANGULAR ±			


A 11261-DO

229-5701A-1-1


229-5701A-1
 3.5 FT HYPERSONIC TUNNEL TEST CHAMBER PERSPECTIVE

DATE FILED: 10/27/58
 NAME: SP-1

A

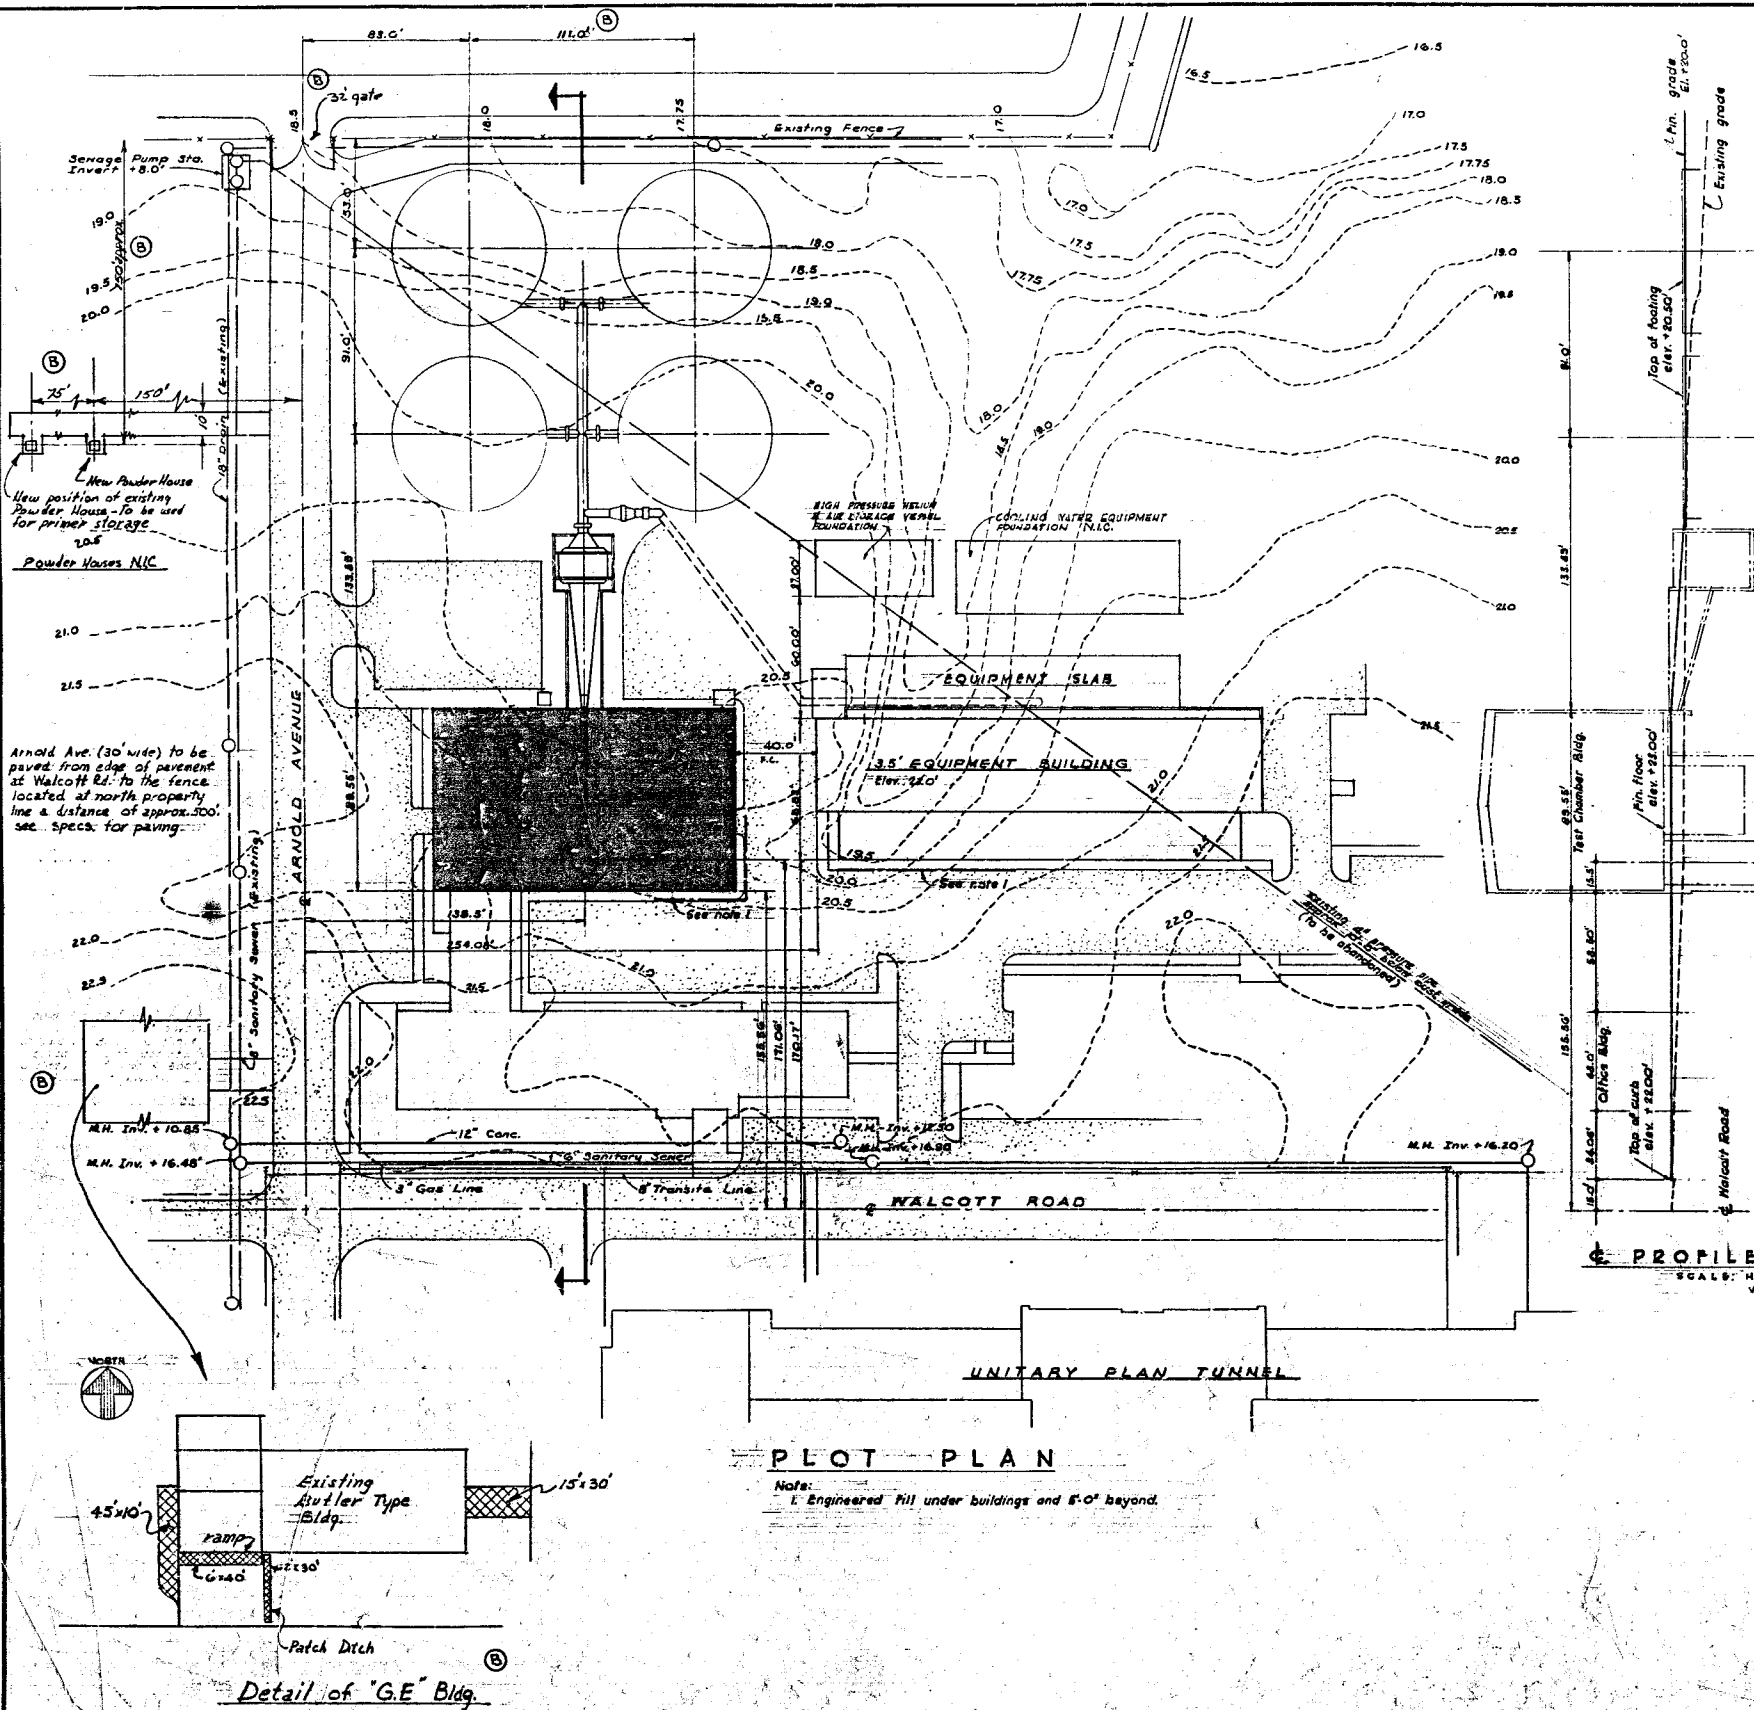

LIST of DRAWINGS		
DRAWING NUMBER	REVISION	DESCRIPTION
11251	D 1	PLOT PLAN
D 2		FIRST FLOOR PLAN AND SCHEDULES
D 3		FOUNDATION PLAN
D 4		MEZZANINE PLAN AND SCHEDULES
D 5		ROOF FRAMING PLAN AND DETAILS
D 6		ELEVATIONS AND SECTIONS
D 7		STRUCTURAL DETAILS
D 8		FOUNDATION AND BASEMENT DETAILS
D 9		HEATER PIT AND TUNNEL - PLAN AND SECTION
D 10		ANCHORAGE DETAILS
D 11		PIT SECTION AND TUNNEL DETAILS
D 12		MISC. CONCRETE DETAILS
D 13		TYPICAL CONCRETE DETAILS
D 14		STAIR DETAILS
D 15		DOOR AND WINDOW DETAILS
D 16		TOILET AND MISC. DETAILS
D 17		MISC. DETAILS
D 18		AIR CONDITIONING, VENTILATING, PLUMBING PLAN & DETAILS
D 19		MEZZ. AIR COND., VENTILATING, PLUMBING PLAN & DETAILS
D 20		MECHANICAL ROOF PLAN AND DETAILS
D 21		MISC. MECHANICAL DETAILS
D 22		MISC. MECHANICAL DETAILS
D 23		FIRST FLOOR ELECTRICAL PLAN
D 24		UNDERGROUND DUCT LAYOUT
D 25		AFTERCOOLER ELECTRICAL PLAN AND DETAILS
D 26		MEZZANINE POWER PLAN
D 27		MEZZANINE AND HEATER PIT LIGHTING
D 28		COMMUNICATION SYSTEM
D 29		AFTERCOOLER FOOTINGS AND PIT - PLAN AND SECTION
D 30		AFTERCOOLER FOOTINGS - SECTIONS AND DETAILS
D 31		SPR-Y PIPING AND CANOPY SUPPORT DETAILS

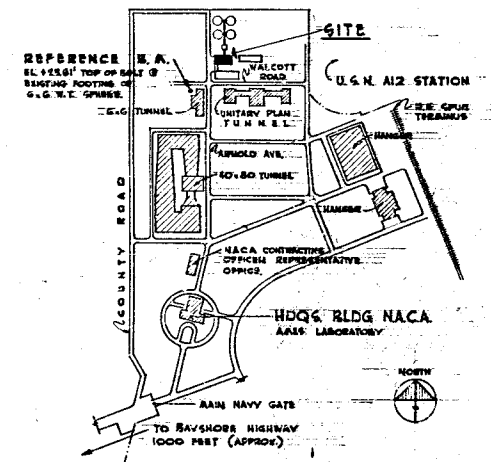

VICINITY MAP

SCALE IN FEET

NOTES:


1. As of October 1, 1956 the National Advisory Committee for Aeronautics, Ames Aeronautical Laboratory is redesignated the National Aeronautics and Space Administration; Ames Research Center, and all reference to the former designation either in these drawings or the accompanying specifications shall be construed to mean the new designation.

E.N.C. - not in contract.


JOHN SARDIS & ASSOCIATES
ENGINEERS
64 PINE STREET
SAN FRANCISCO

SCALE: 1" = 40'	REVISIONS	DATE	BY	CHK.	APP.
NATIONAL ADVISORY COMMITTEE FOR AERONAUTICS AMES AERONAUTICAL LABORATORY MOFFETT FIELD, CALIF.					
3.5 FOOT HYPERSONIC TUNNEL TEST CHAMBER PLOT PLAN					
DESIGN	BRANCH	DESIGN	DATE	REV.	
DESIGNED BY: J.S.	BRANCH: H.S.R.	DESIGN: 5431X	DATE: 10/26/59	REV: 1	
CHECKED BY: J.S.	APPROVED BY: J.S.	DATE: 10/26/59			
AT1261 D1 G					

229-5901 A-2
3.5 FT. H.S. TUNNEL TEST CHAMBER PLOT PLAN

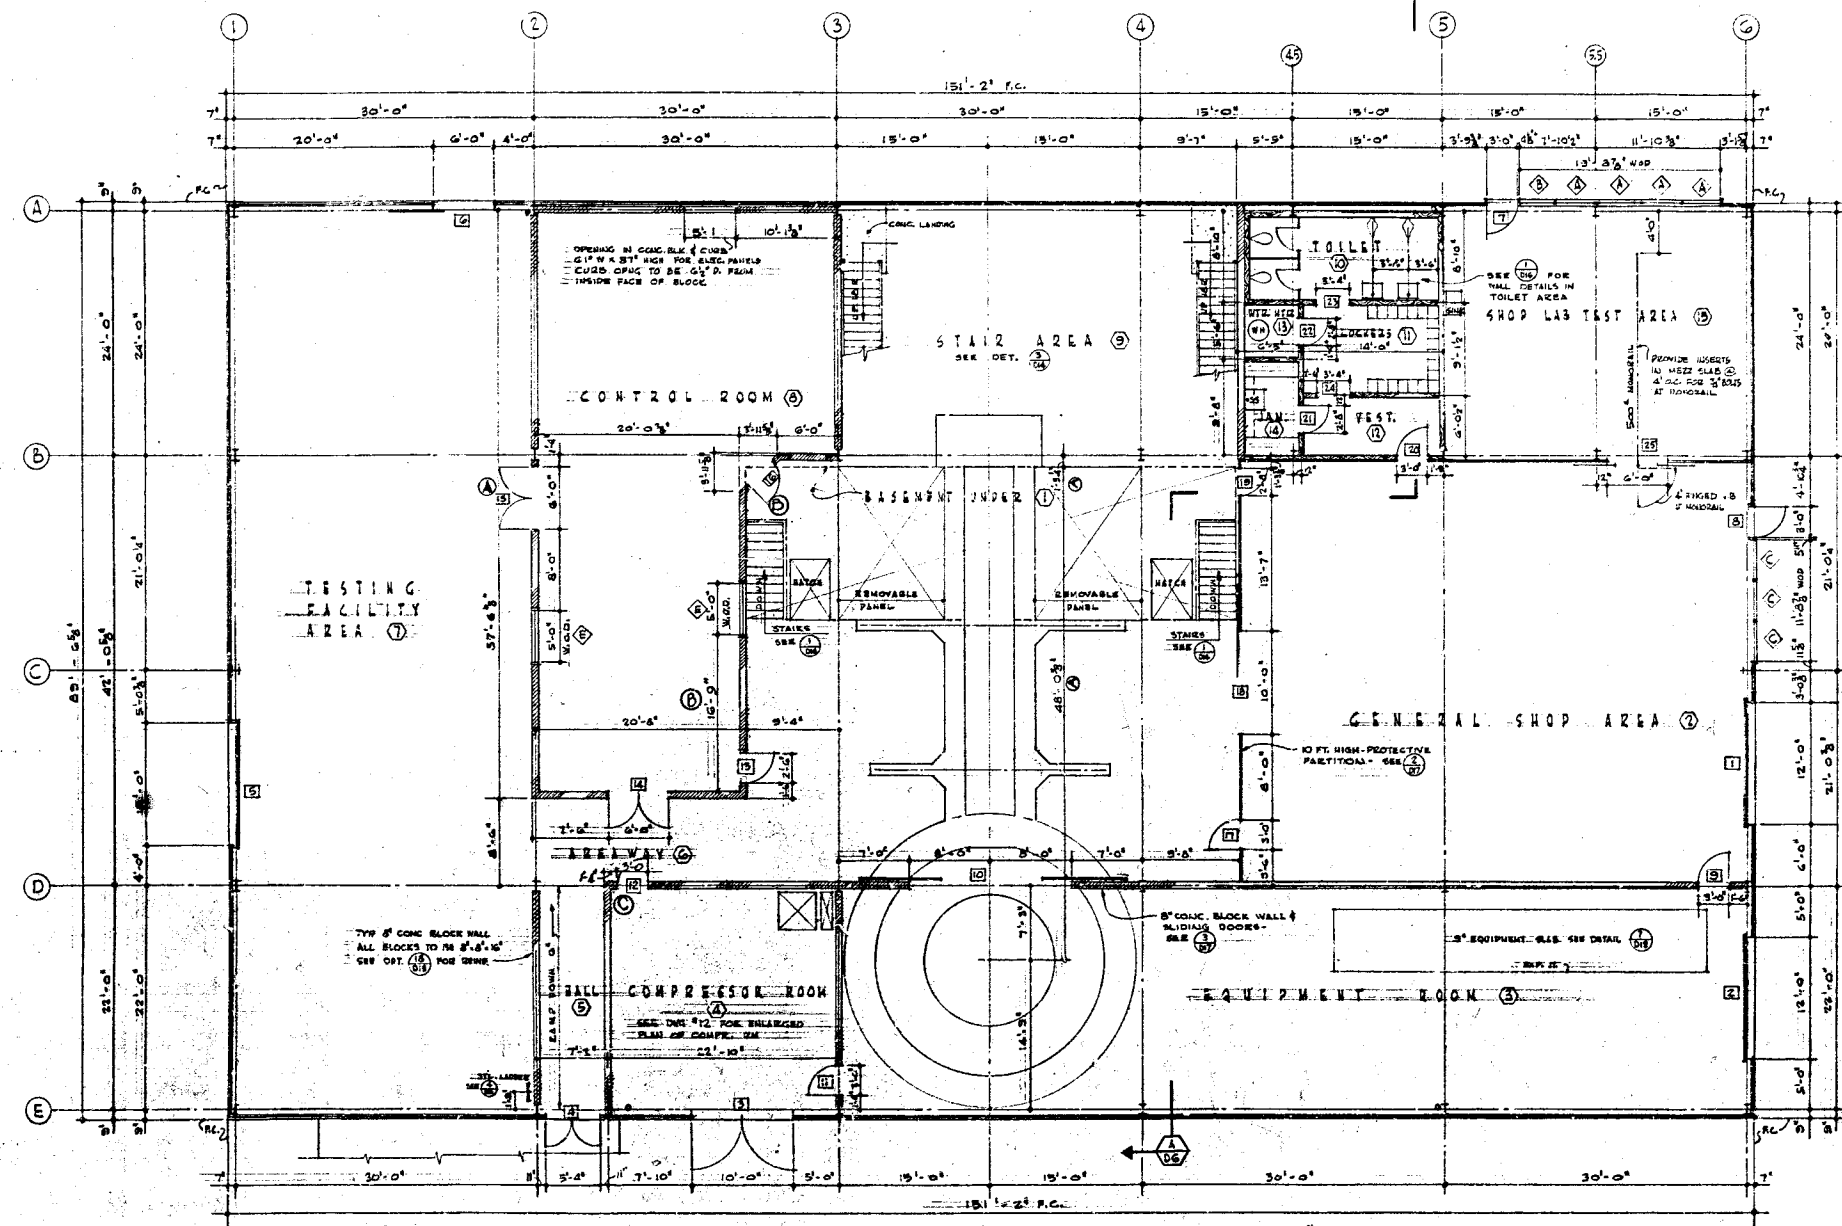

FIRST FLOOR PLAN

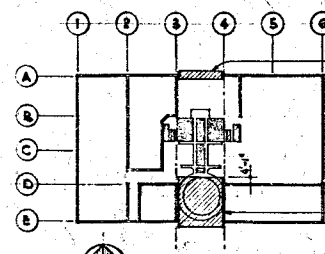

DESIGN LOADS

ROOF LIVE LOAD	20 POUNDS PER SQUARE FOOT
METZANINE FLOOR LIVE LOAD	100 " " " "
OVER CONTROL ROOM	150 " " " "
MAIN FLOOR LIVE LOAD OVER BASEMENT	150 " " " "
BOATING AND CRUISE PLATE AREA, CATHAL	150 " " " "
LATERAL LOADS:	
SEISMIC	50% OF DEAD LOAD
WIND	80 POUNDS PER SQUARE FOOT

F.C. = FACE OF CONCRETE
 DETAIL NUMBER
 DIM. WHERE DIM. IS SHOWN
 SECTION LETTER
 DIM. WHERE DIM. IS SHOWN

OMIT SHOWN BELOW MEZ FLOOR
 AT LINE A BETWEEN LINES 3 AND 4
 OMIT ALL WALLS AND PARTITIONS
 BETWEEN LINES 3 AND 4 FROM
 LINE 3 TO BEYOND LINE 4 AS
 DIMENSIONED.
 DELAYED CONSTRUCTION
 FOR HEATER SECTION
 DELAYED CONSTRUCTION PROCEDURE TO BE USED
 ONLY IF BUILDING IS RUPF BEFORE HEATER IS ERECTED.

JOHN SARDIS & ASSOCIATES
 ENGINEERS
 64 PINE STREET
 SAN FRANCISCO

DOOR SCHEDULE

TYPE	TYPE	SIZE	DETAIL	ALLOVANCE GROUP	REMARKS
1	A	12' x 10'	1	1	
2	A	12' x 10'	2	1	
3	B	10' x 10' x 1 1/2"	3	9	
4	C	5' x 7' x 1 1/2"	4	3	
5	A	17' x 10'	5	1	
6	D	6' x 7' x 1 1/2"	6	11	
7	D	3' x 7' x 1 1/2"	7	4	
8	D	3' x 7' x 1 1/2"	8	1	
9	E	3' x 7' x 1 1/2"	9	1	
10	F	16' x 3' x 1 1/2"	10	1	SEE DET. FOR EQUIPMENT PROFILE
11	D	3' x 7' x 1 1/2"	11	1	
12	D	3' x 7' x 1 1/2"	12	1	
13	D	3' x 7' x 1 1/2"	13	5	
14	C	6' x 7' x 1 1/2"	14	7	1 1/2" HIGH GL. MINIMUM 1/2" GLASS THICKNESS, 24" WIDE
15	C	6' x 7' x 1 1/2"	15	7	1 1/2" HIGH GL. MINIMUM 1/2" GLASS THICKNESS, 24" WIDE
16	E	3' x 7' x 1 1/2"	16	2	1 1/2" HIGH GL. MINIMUM 1/2" GLASS THICKNESS, 24" WIDE
17	E	3' x 7' x 1 1/2"	17	1	1 1/2" HIGH GL. MINIMUM 1/2" GLASS THICKNESS, 24" WIDE
18	D	10' x 3' x 1 1/2"	18	1	SEE DET.
19	E	2' x 7' x 1 1/2"	19	1	
20	D	3' x 7' x 1 1/2"	20	1	
21	D	2' x 7' x 1 1/2"	21	5	LOUVER
22	D	2' x 7' x 1 1/2"	22	5	LOUVER
23	A	3' x 7'	23	1	NO DOOR - FRAME ONLY
24	A	3' x 7'	24	1	NO DOOR - FRAME ONLY
25	B	6' x 7' x 1 1/2"	25	11	NOTCH DOORS FOR MONORAIL
26	E	4' x 7' x 1 1/2"	26	2	1 1/2" HIGH GL. MINIMUM 1/2" GLASS THICKNESS, 24" WIDE
27	E	3' x 7' x 1 1/2"	27	2	1 1/2" HIGH GL. MINIMUM 1/2" GLASS THICKNESS, 24" WIDE
28	E	3' x 7' x 1 1/2"	28	2	1 1/2" HIGH GL. MINIMUM 1/2" GLASS THICKNESS, 24" WIDE
29	D	5' x 7' x 1 1/2"	29	2	1 1/2" HIGH GL. MINIMUM 1/2" GLASS THICKNESS, 24" WIDE
30	D	3' x 7' x 1 1/2"	30	1	
31	D	3' x 7' x 1 1/2"	31	1	
32	D	3' x 7' x 1 1/2"	32	1	
33	B	6' x 7' x 1 1/2"	33	12	NOTCH DOORS FOR MONORAIL, PROVIDE CHAIN GUARD

WINDOW SCHEDULE

TYPE	TYPE	SIZE	DETAIL	ALLOVANCE GROUP	REMARKS
1	A	12' x 10'	1	1	
2	A	12' x 10'	2	1	
3	B	10' x 10' x 1 1/2"	3	9	
4	C	5' x 7' x 1 1/2"	4	3	
5	A	17' x 10'	5	1	
6	D	6' x 7' x 1 1/2"	6	11	
7	D	3' x 7' x 1 1/2"	7	4	
8	D	3' x 7' x 1 1/2"	8	1	
9	E	3' x 7' x 1 1/2"	9	1	
10	F	16' x 3' x 1 1/2"	10	1	SEE DET. FOR EQUIPMENT PROFILE
11	D	3' x 7' x 1 1/2"	11	1	
12	D	3' x 7' x 1 1/2"	12	1	
13	D	3' x 7' x 1 1/2"	13	5	
14	C	6' x 7' x 1 1/2"	14	7	1 1/2" HIGH GL. MINIMUM 1/2" GLASS THICKNESS, 24" WIDE
15	C	6' x 7' x 1 1/2"	15	7	1 1/2" HIGH GL. MINIMUM 1/2" GLASS THICKNESS, 24" WIDE
16	E	3' x 7' x 1 1/2"	16	2	1 1/2" HIGH GL. MINIMUM 1/2" GLASS THICKNESS, 24" WIDE
17	E	3' x 7' x 1 1/2"	17	1	1 1/2" HIGH GL. MINIMUM 1/2" GLASS THICKNESS, 24" WIDE
18	D	10' x 3' x 1 1/2"	18	1	SEE DET.
19	E	2' x 7' x 1 1/2"	19	1	
20	D	3' x 7' x 1 1/2"	20	1	
21	D	2' x 7' x 1 1/2"	21	5	LOUVER
22	D	2' x 7' x 1 1/2"	22	5	LOUVER
23	A	3' x 7'	23	1	NO DOOR - FRAME ONLY
24	A	3' x 7'	24	1	NO DOOR - FRAME ONLY
25	B	6' x 7' x 1 1/2"	25	11	NOTCH DOORS FOR MONORAIL
26	E	4' x 7' x 1 1/2"	26	2	1 1/2" HIGH GL. MINIMUM 1/2" GLASS THICKNESS, 24" WIDE
27	E	3' x 7' x 1 1/2"	27	2	1 1/2" HIGH GL. MINIMUM 1/2" GLASS THICKNESS, 24" WIDE
28	E	3' x 7' x 1 1/2"	28	2	1 1/2" HIGH GL. MINIMUM 1/2" GLASS THICKNESS, 24" WIDE
29	D	5' x 7' x 1 1/2"	29	2	1 1/2" HIGH GL. MINIMUM 1/2" GLASS THICKNESS, 24" WIDE
30	D	3' x 7' x 1 1/2"	30	1	
31	D	3' x 7' x 1 1/2"	31	1	
32	D	3' x 7' x 1 1/2"	32	1	
33	B	6' x 7' x 1 1/2"	33	12	NOTCH DOORS FOR MONORAIL, PROVIDE CHAIN GUARD


SCALE: 1/4" = 1'-0"	DOOR (12) RELOCATED 1'-6" W/ 3'-3" (11)
MATERIAL	DOOR (12) RELOCATED, 3'-6" W/ 3'-3" (11)
TEXT	DOOR (12) RELOCATED, 3'-6" W/ 3'-3" (11)
PHOTOGRAPH	DOOR (12) RELOCATED, 3'-6" W/ 3'-3" (11)
QUANTITY	DOOR (12) RELOCATED, 3'-6" W/ 3'-3" (11)
INDEX	DOOR (12) RELOCATED, 3'-6" W/ 3'-3" (11)
LIMITS ON DIMENSIONS	DOOR (12) RELOCATED, 3'-6" W/ 3'-3" (11)
FRACTIONAL	DOOR (12) RELOCATED, 3'-6" W/ 3'-3" (11)
DECIMAL	DOOR (12) RELOCATED, 3'-6" W/ 3'-3" (11)
ANGULAR	DOOR (12) RELOCATED, 3'-6" W/ 3'-3" (11)

229-9901A-3
 3.5 FT. H.S. TUNNEL TEST CHAMBER FIRST FLOOR PLAN


REVISIONS

A11261-D2


229 5790/1A 113

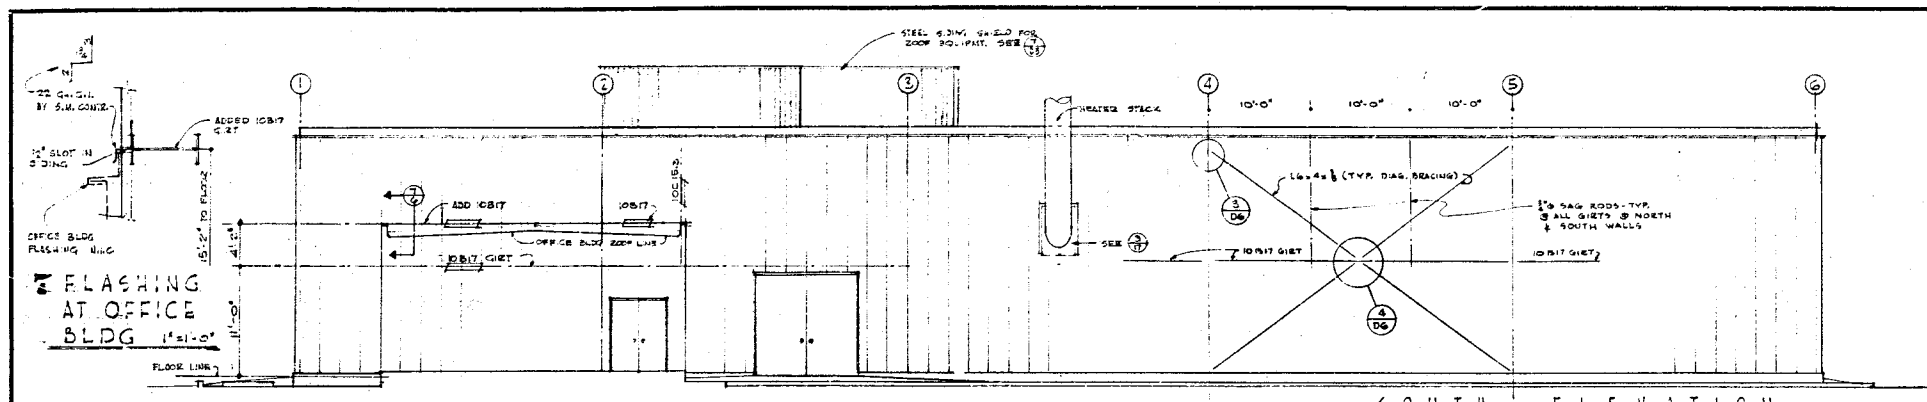


SOUTH ELEVATION

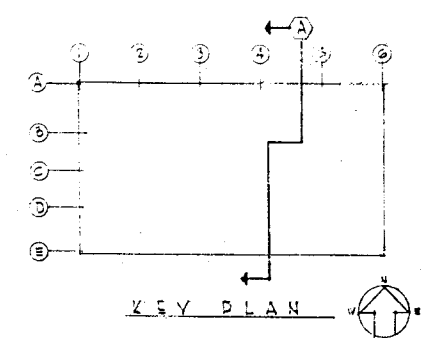

KEY PLAN

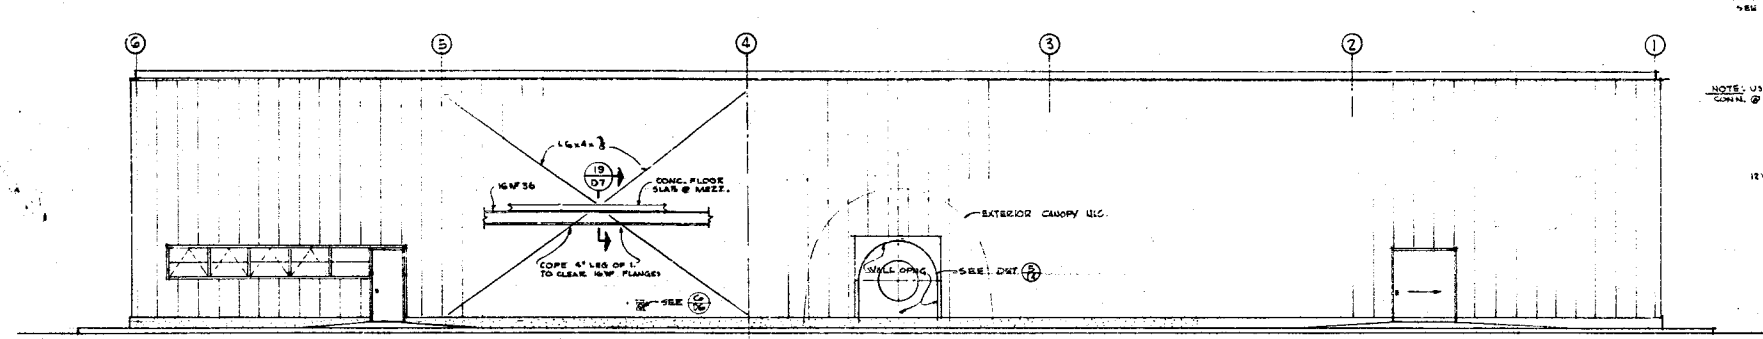


NORTH ELEVATION

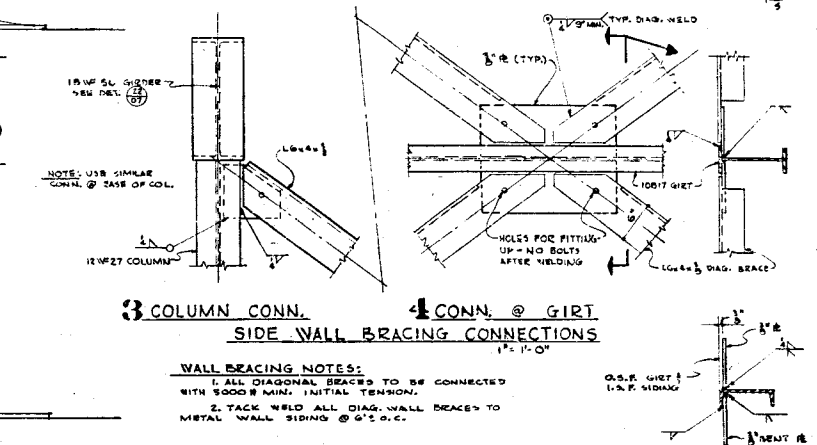


3 COLUMN CONN. 4 CONN. @ GIRT
SIDE WALL BRACING CONNECTIONS


WALL BRACING NOTES:
1. ALL DIAGONAL BRACES TO BE CONNECTED WITH 5000 R MIN. INITIAL TENSION.
2. TACK WELD ALL DIAG. WALL BRACES TO METAL WALL SIDING @ 6" S.P.C.

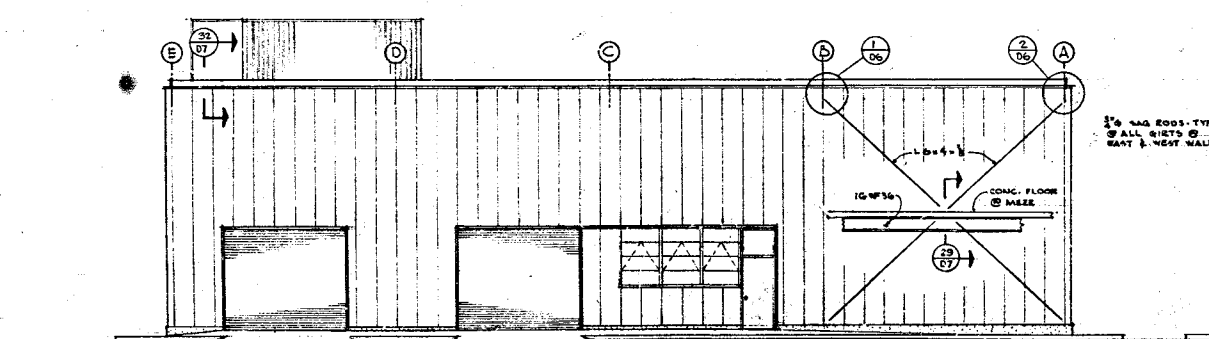


EAST ELEVATION

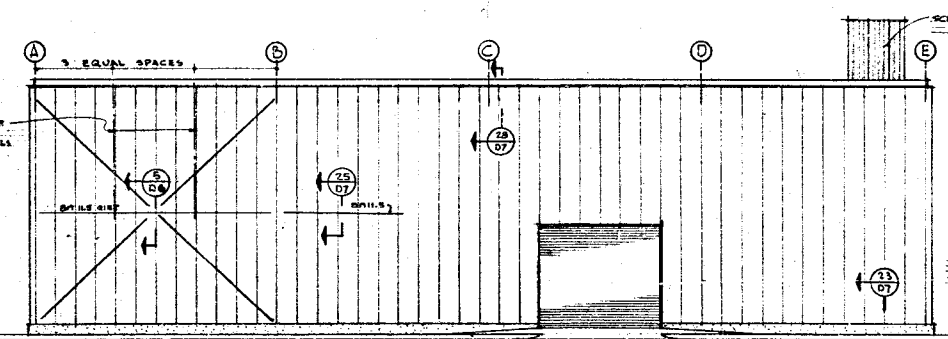


WEST ELEVATION

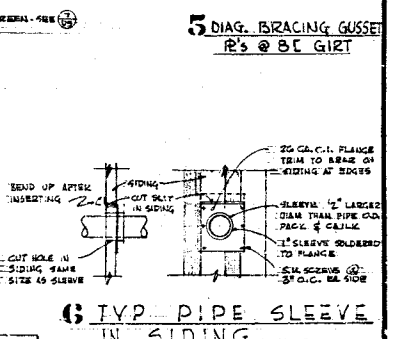

5 DIAG. BRACING GUSSET
6 TYP PIPE SLEEVE IN SIDING

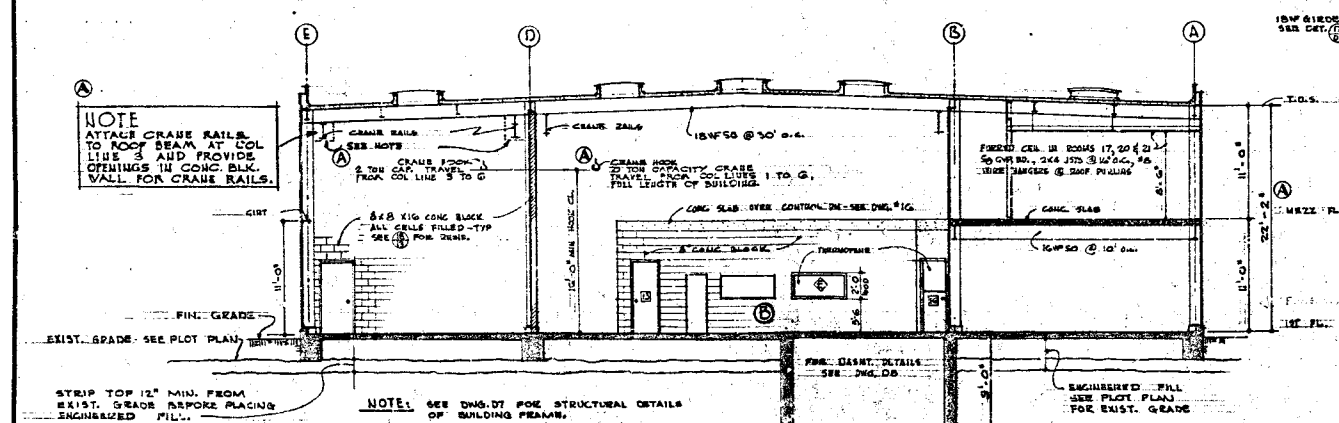

SECTION

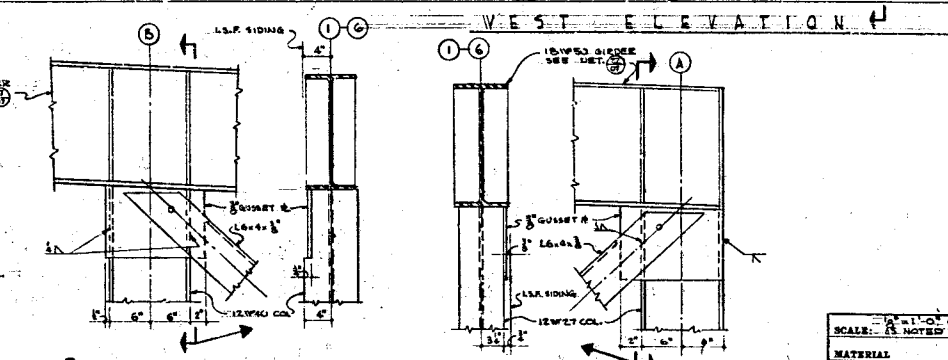

1 INTERIOR COLUMN CONN. 2 CORNER COLUMN CONN.

END WALL BRACING CONNECTIONS


NOTE: SIMILAR CONNECTIONS TO BE USED @ BASE OF WALL COLUMNS.

B		WALL OPENINGS REVISED TO SUIT FOUND. PUBLISHED	REV	1
A		CRANE RAIL NOTE ADDED CONC. BLK. WALL COPS. PROVIDED	A.D.	1
REV	DATE	REVISIONS	CER	APP
NATIONAL ADVISORY COMMITTEE FOR AERONAUTICS AMES AERONAUTICAL LABORATORY MOFFETT FIELD, CALIF.				
3.5 FOOT HYPERSONIC TUNNEL TEST CHAMBER ELEVATIONS & SECTIONS				
DESIGN	ENG.	SEARCH	DESIGN	REV.
DRAWN	BY	DIVISION	CONC.	REV.
INDEX	BY	APPROVED	BY	DATE
LIMITS OF DIMENSIONS	CHECKED	BY	BY	DATE
UNLESS OTHERWISE	BY	BY	BY	DATE
NOTED	BY	BY	BY	DATE
FRACTIONAL	BY	BY	BY	DATE
DECIMAL	BY	BY	BY	DATE
ANGULAR	BY	BY	BY	DATE

JOHN SARDIS & ASSOCIATES
ENGINEERS
24 PINE STREET
SAN FRANCISCO


A11261 D6 B

229-5901 A-7
7.5 FT. H.S. TUNNEL TEST CHAMBER ELEVATIONS & SECTIONS

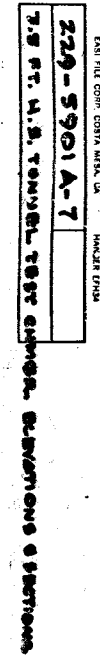

JOHN SARDIS & ASSOCIATES
64 PINE STREET
SAN FRANCISCO **ENGINEERS**

B <i>10/19/58</i> ③ HALL OPERINGS REVISED TO SPLIT EQUIP. FURNISHED SET A. 22'S WAS 22-8 CRANE RAIL NOT ADDED CONC. WALL CRG. PROVIDED	④ <i>11/25/58</i> CRANE RAIL NOT ADDED CONC. WALL CRG. PROVIDED	A.D. <i>11/25/58</i>	⑤ <i>11/25/58</i>
① <i>11/25/58</i> CATS	DIVISIONS	CEE	APP.
NATIONAL ADVISORY COMMITTEE FOR AERONAUTICS AMES AERONAUTICAL LABORATORY MOFFETT FIELD, CALIF.			
3.5 FOOT HYPERSONIC TUNNEL TEST CHAMBER ELEVATIONS & SECTIONS			
DESIGN ENG. DRAWN BY CHECKED BY RESEARCH ENG.	BRANCH DIVISION HSR	DESIGN I.O. CORSE I.O.	REV.
INDEX <i>10/19/58</i> LIMITS ON DIMENSIONS OTHERWISE NOTED	QUAN. <i>10/19/58</i>	A 1126	D6
FRACTIONAL ± DECIMAL ± ANGULAR ±	APPROVED BY <i>10/20/58</i> APPROVED BY <i>10/20/58</i>	B	B

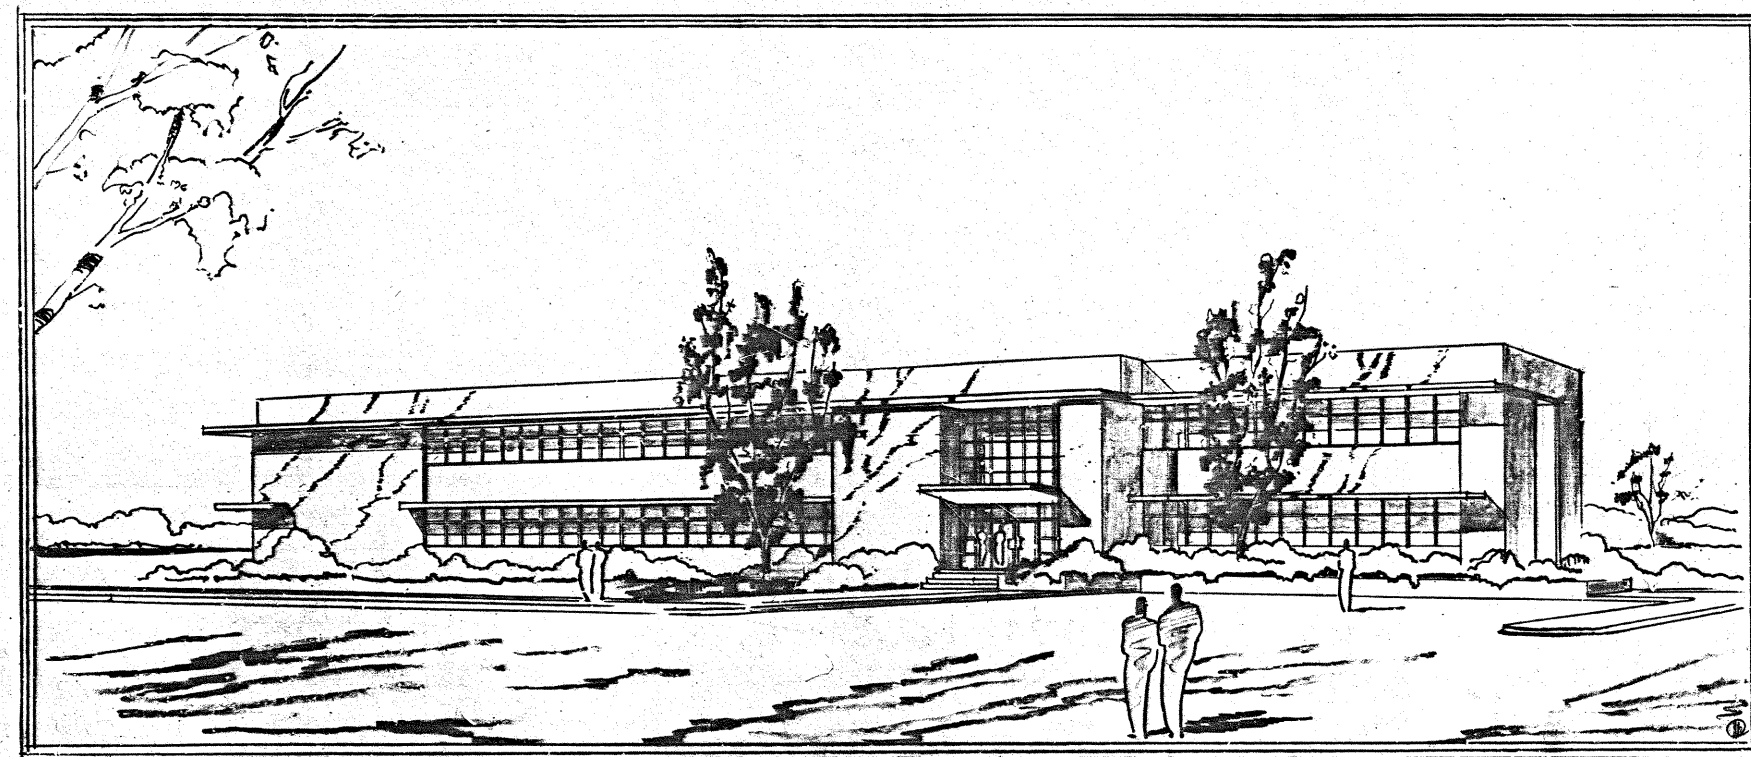

229 5902A 11

JUNE 12, 1958


SCALE:	LET	DATE	REVISIONS	CHK.	APP.
MATERIAL:	NATIONAL ADVISORY COMMITTEE FOR AERONAUTICS				
PROJECT:	AMES AERONAUTICAL LABORATORY				
PROJECT:	MOFFETT FIELD, CALIF.				
QUAN. ASSEM. DRWG. NO.	3.5 FOOT HYPERSONIC TUNNEL				
	OFFICE BUILDING				
	PERSPECTIVE				
	DESIGN	BRANCH	DESIGN	CONST.	REV.
	DRAWN	DIVISION 15A	15A		
LIMITS ON DIMENSIONS UNLESS OTHERWISE NOTED	CHECKED				
FRACTIONAL	RESEARCH				
DECIMAL	APPROVED				
ANGULAR	APPROVED				

A11262 DI A

229-5902A-1
3.5 FT. H.S. TUNNEL OFFICE BLDG. PERSPECTIVE

ES&I FILE CORP. COSTA MESA, CA HANGER 17/18A

229-5902 A-3
3.5 FT. H.S. TUNNEL OFFICE BLDG., 2ND FLOOR & ROOF PLANS

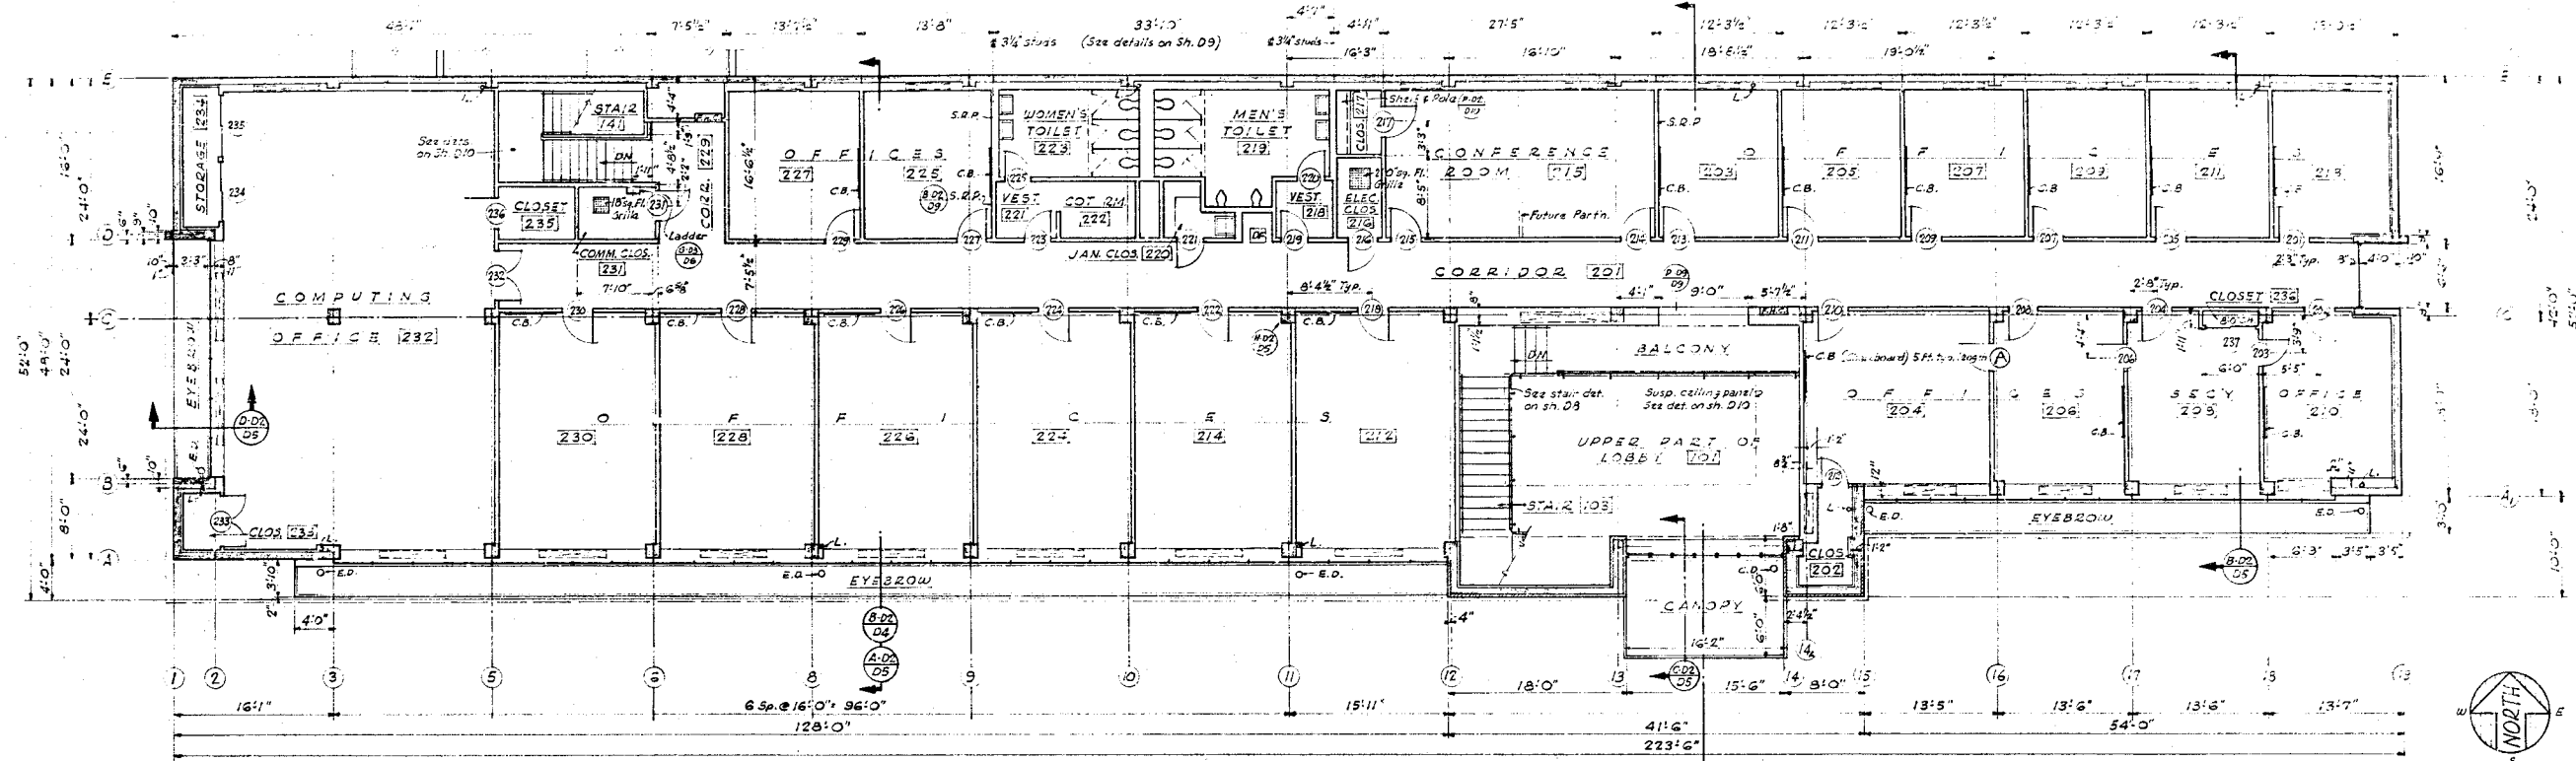


SECOND FLOOR PLAN
Scale: 1/8" = 1'-0"

C.D. = Canopy Drain
E.D. = Eyebrow Drain
L. = Leader

INTERIOR FINISH AND PAINT SCHEDULE									
NUMBER	ROOM	FLOOR	BASE	WAINSCOT	WALL MATERIAL	CEILING MATERIAL	DOOR AND FRAME PAINT	REMARKS	
201, 223	CORRIDOR	Asphalt Tile	Rubber	-	Plaster	SGE Acous. Tile	SGE		
202, 216, 217, 231, 233, 234, 235, 236	CLOSET; STORAGE	-	-	-	-	F Plaster	F	2ms. 216 & 231: ceilings exposed. Shelf & pole in Rm. 217 & 237; paint SGE	
203, 204, 205, 206, 207, 208, 209, 210, 211, 212, 213, 214, 224, 225, 226, 227, 228, 230, 232	OFFICE	-	-	-	-	F Acous. Tile	-		
215	CONFERENCE ROOM	-	-	-	-	-	-		
218, 221, 222	VESTIBULE; COT. ROOM	-	-	-	-	SGE	-		
219, 223	TOILET	Terrazzo	Terrazzo	Tile - 4" x 8"	K.C. Plaster GE	K.C. Plaster GE	GE	See elevations on sh. D9	
220	JANITOR'S CLOSET	Asphalt Tile	Rubber	-	K.C. Plaster GE	K.C. Plaster GE	GE	See shelf details on sh. D9	

F = Flat paint G.E. = Gloss Enamel S.G.E. = Semi Gloss Enamel

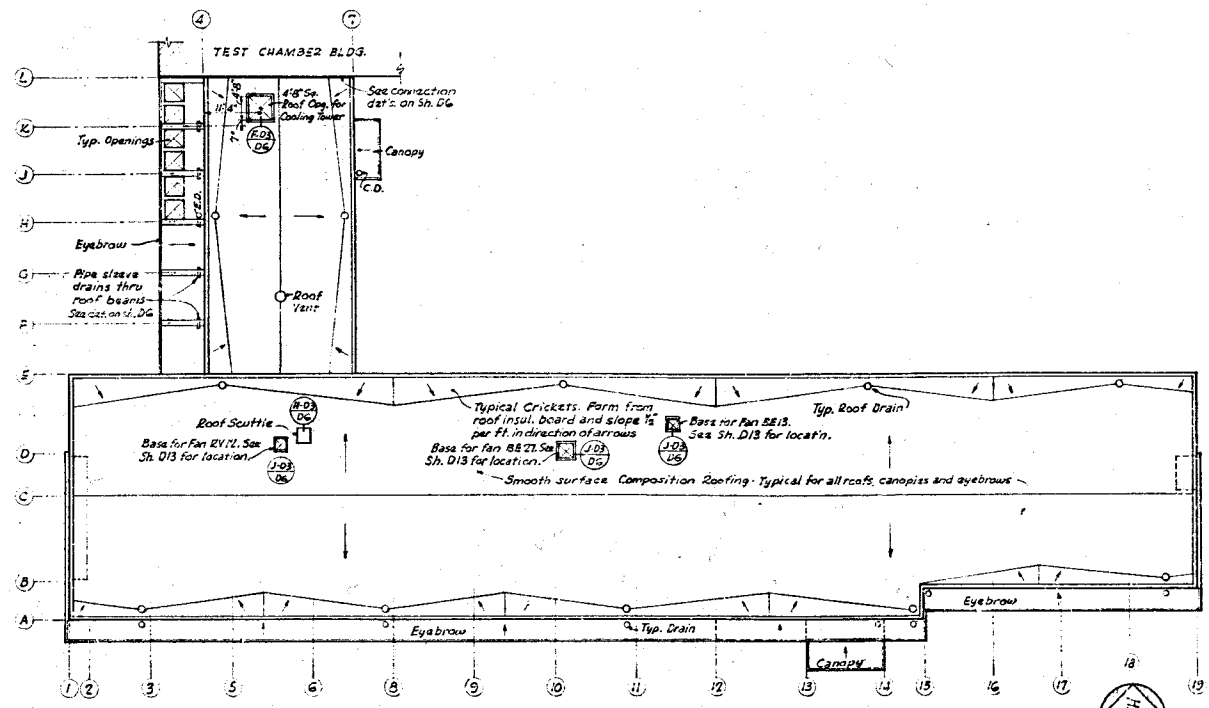

ROOF PLAN
Scale: 1/16" = 1'-0"


NOTE: All roof drains are 3"
All eyebrow and canopy drains are 2"

229-5902A--3
ROSENER ENGINEERING
INCORPORATED
ENGINEERS AND ARCHITECTS
SAN FRANCISCO, CALIFORNIA

SCALE: AS NOTED	REVISIONS	CHK. APP.
MATERIAL	DATE	
PROJECT		
QUANT. ASSEM. DRWG. NO.		
DESIGN	BRANCH	DESIGN
DRAWN	DIVISION	CONST.
CHECKED		
RESEARCH		
APPROVED		
DATE		
BY		

NATIONAL ADVISORY COMMITTEE FOR AERONAUTICS
AMES AERONAUTICAL LABORATORY
MOFFETT FIELD, CALIF.
3.5 FOOT HYPERSONIC TUNNEL
OFFICE BUILDING
2ND FLOOR & ROOF PLANS & SCHEDULE
A11262-D3

229-5902 A-3
3.5 FT. H.S. TUNNEL OFFICE BLDG., 2ND FLOOR & ROOF PLANS

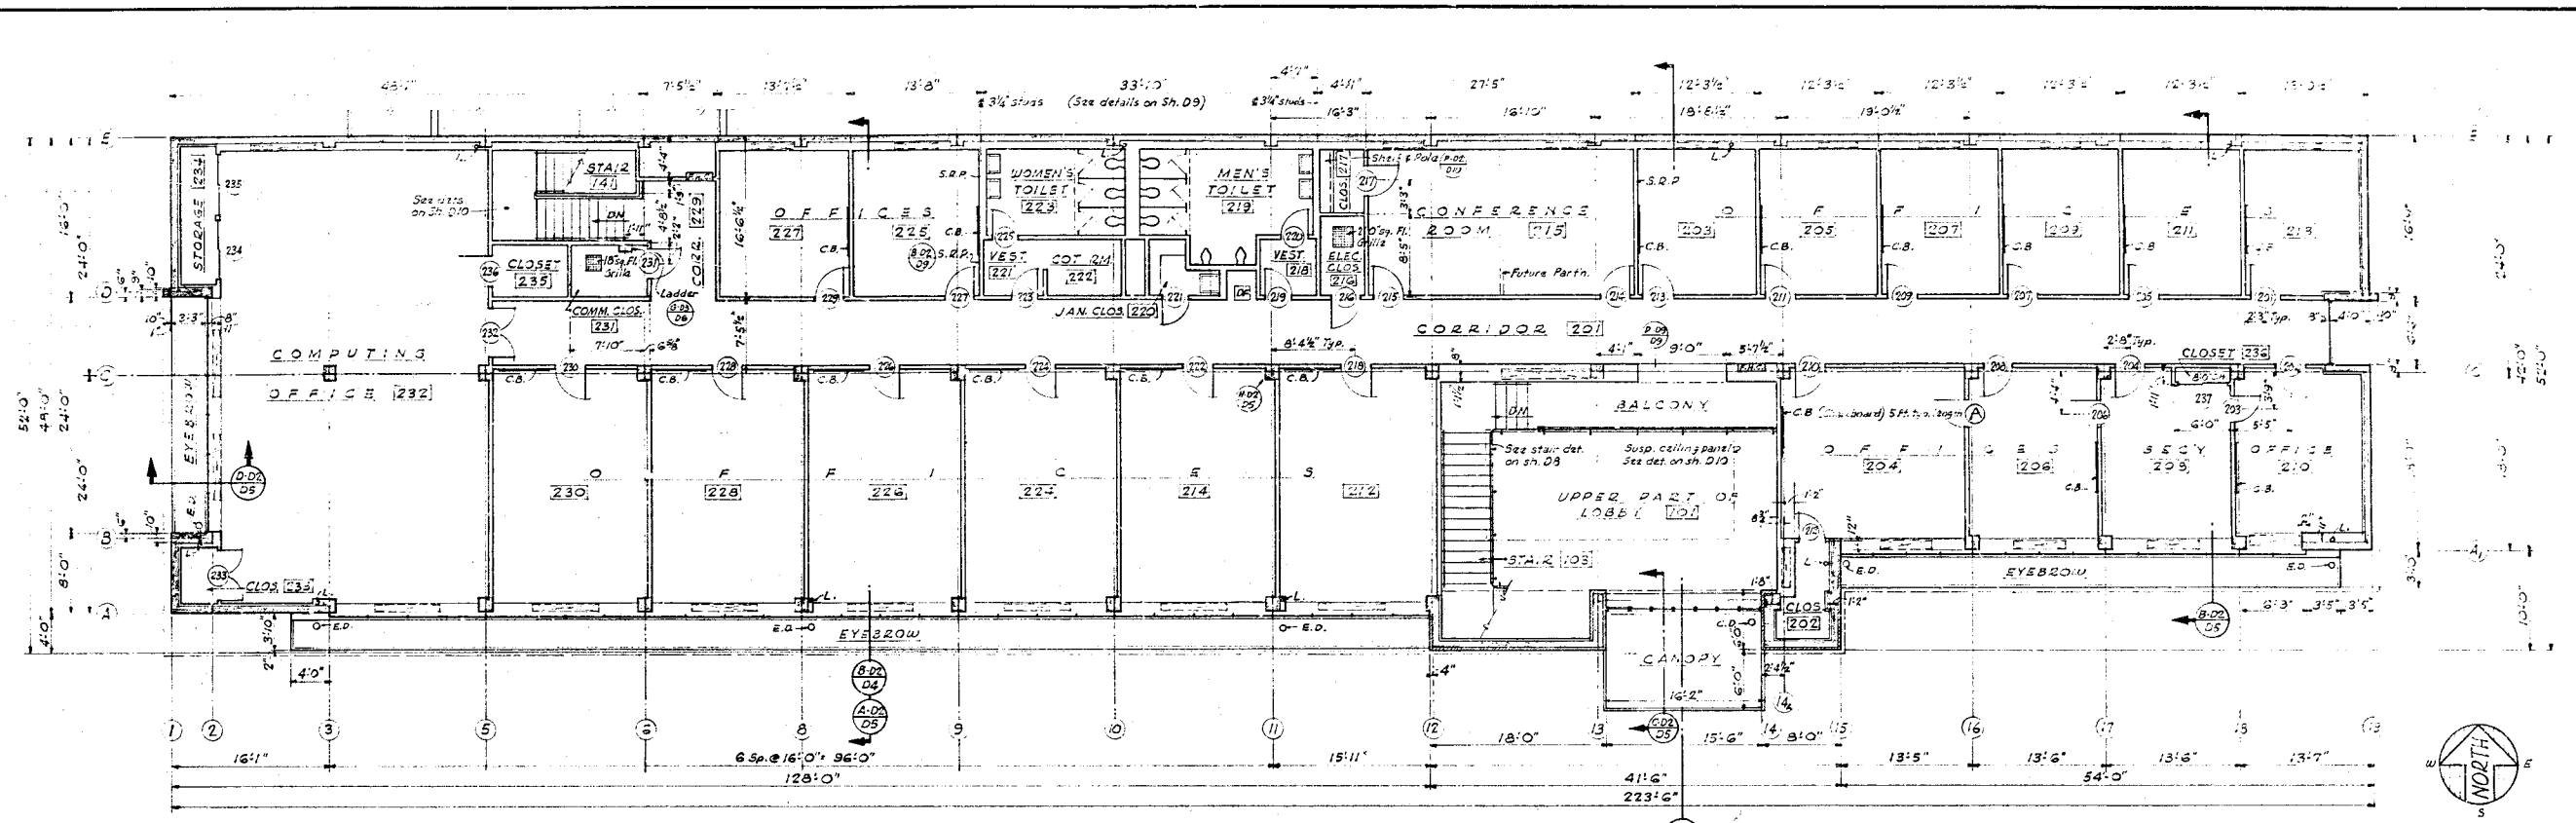


SECOND FLOOR PLAN
Scale: 1/8" = 1'-0"

C.D. = Canopy Drain
E.D. = Eyebrow Drain
L. = Leader

INTERIOR FINISH AND PAINT SCHEDULE									
NUMBER	ROOM	FLOOR	BASE	WAINSCOT	WALL MATERIAL	CEILING MATERIAL	DOOR AND FRAME PAINT	REMARKS	
201, 223	CORRIDOR	Asphalt Tile	Rubber	-	Plaster	SGE Acous. Tile	SGE		
202, 216, 217, 231, 233, 234, 235, 236	CLOSET; STORAGE	-	-	-	-	F Plaster	F	2ms. 216 & 231 ceilings exposed. Shelf & pole in Rm. 217 & 237; paint SGE	
203, 204, 205, 206, 207, 208, 209, 210, 211, 212, 213, 214, 224, 225, 226, 227, 228, 230, 232	OFFICE	-	-	-	-	F Acous. Tile	-		
215	CONFERENCE ROOM	-	-	-	-	F	-		
218, 221, 222	VESTIBULE; COT. ROOM	-	-	-	-	SGE	-		
219, 223	TOILET	Terrazzo	Terrazzo	Tile 4'x10'	K.C. Plaster GE	K.C. Plaster GE	GE	See elevations on sh. D9	
220	JANITOR'S CLOSET	Asphalt Tile	Rubber	-	K.C. Plaster GE	K.C. Plaster GE	GE	See shelf details on sh. D9	

F = Flat paint G.E. = Gloss Enamel S.G.E. = Semi Gloss Enamel

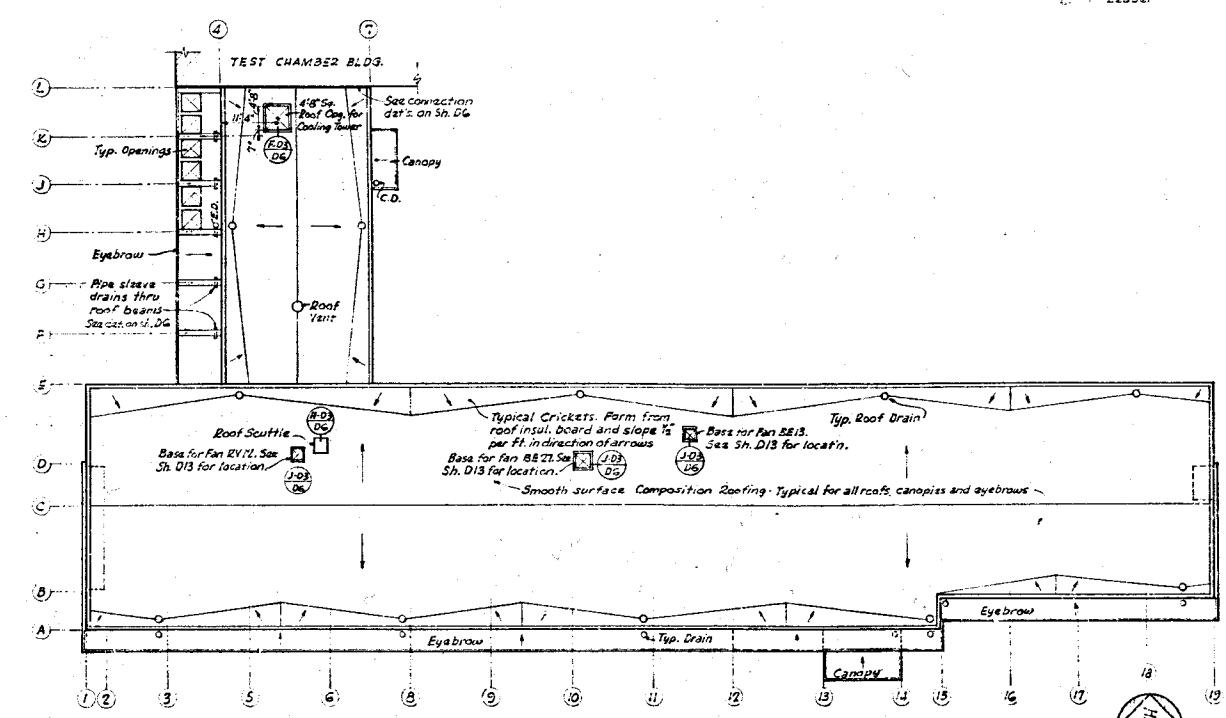







ROOF PLAN
Scale: 1/16" = 1'-0"

NOTE: All roof drains are 3"
All eyebrow and canopy drains are 2"

229-5902A--3
ROSENER ENGINEERING
INCORPORATED
ENGINEERS AND ARCHITECTS
SAN FRANCISCO, CALIFORNIA

SCALE: AS NOTED	REVISIONS	CHK. APP.
MATERIAL	DATE	
PROJECT		
PROJECT		
QUANT. ASSEM. DRWG. NO.		
DESIGN	BRANCH	DESIGN
DRAWN	DIVISION	CONST.
CHECKED		
RESEARCH		
APPROVED		
DATE		
BY		
DATE		
BY		

NATIONAL ADVISORY COMMITTEE FOR AERONAUTICS
AMES AERONAUTICAL LABORATORY
MOFFETT FIELD, CALIF.
3.5 FOOT HYPERSONIC TUNNEL
OFFICE BUILDING
2ND FLOOR & ROOF PLANS & SCHEDULE
A11262-D3

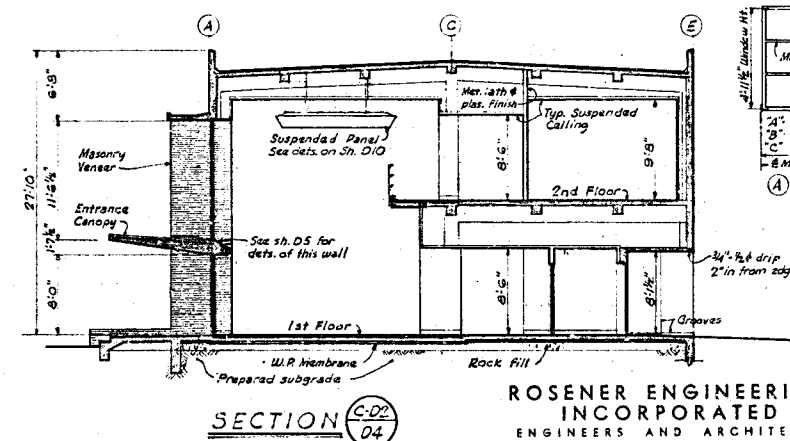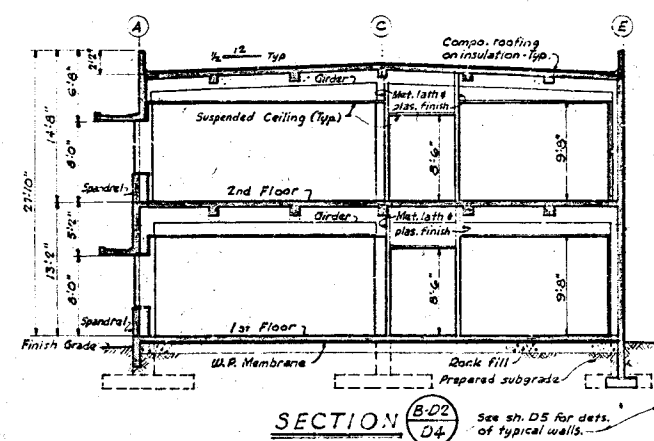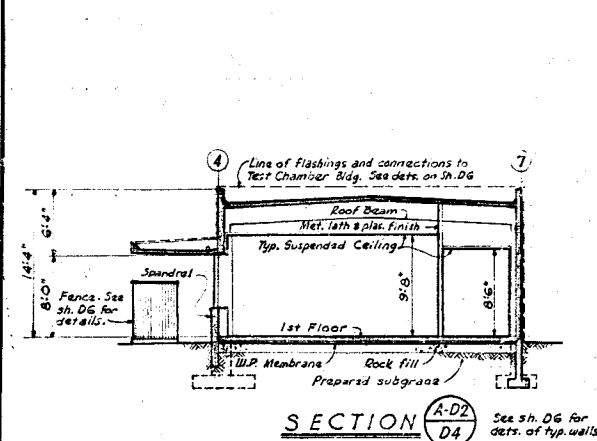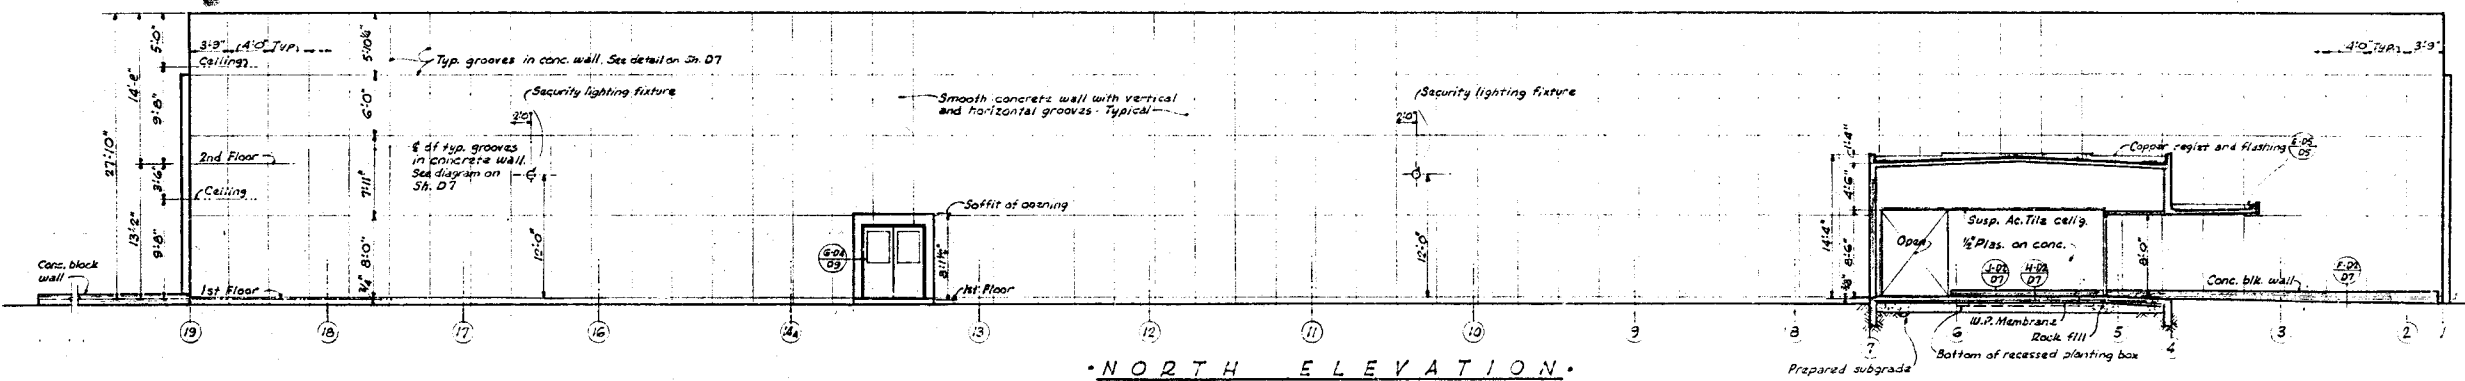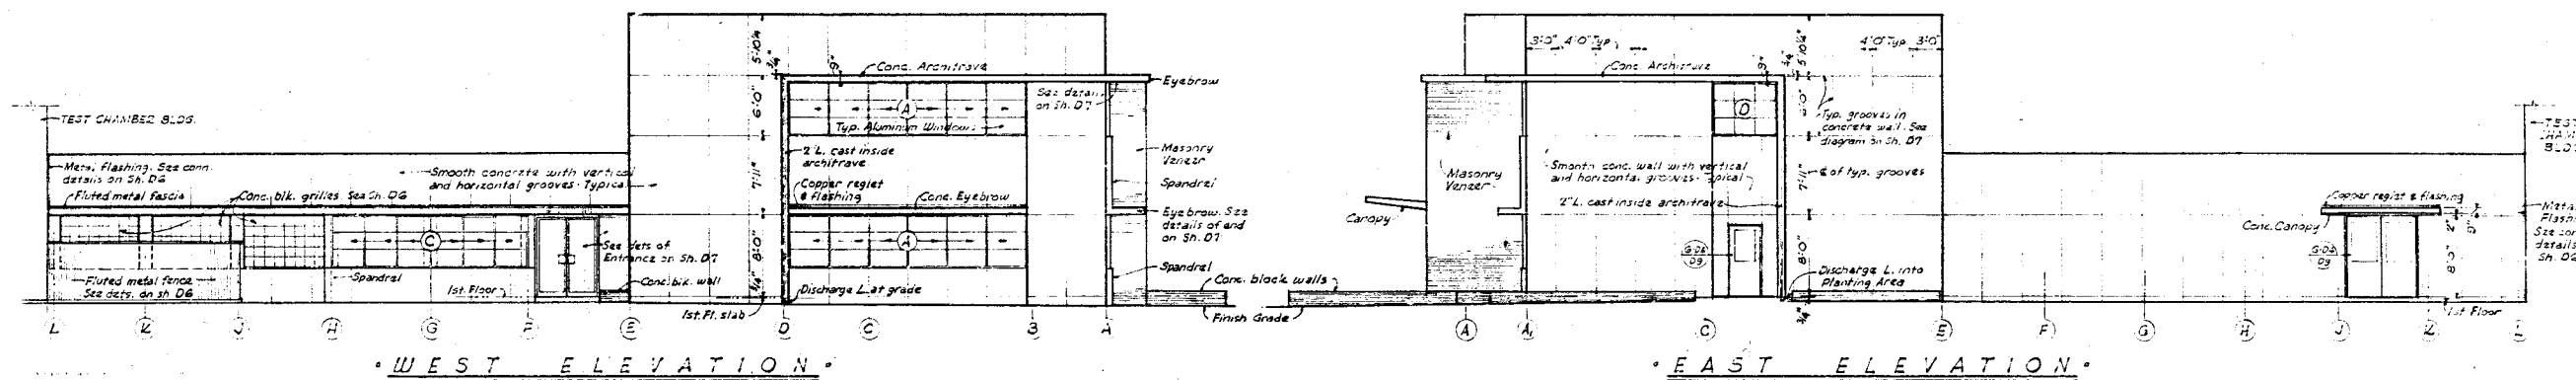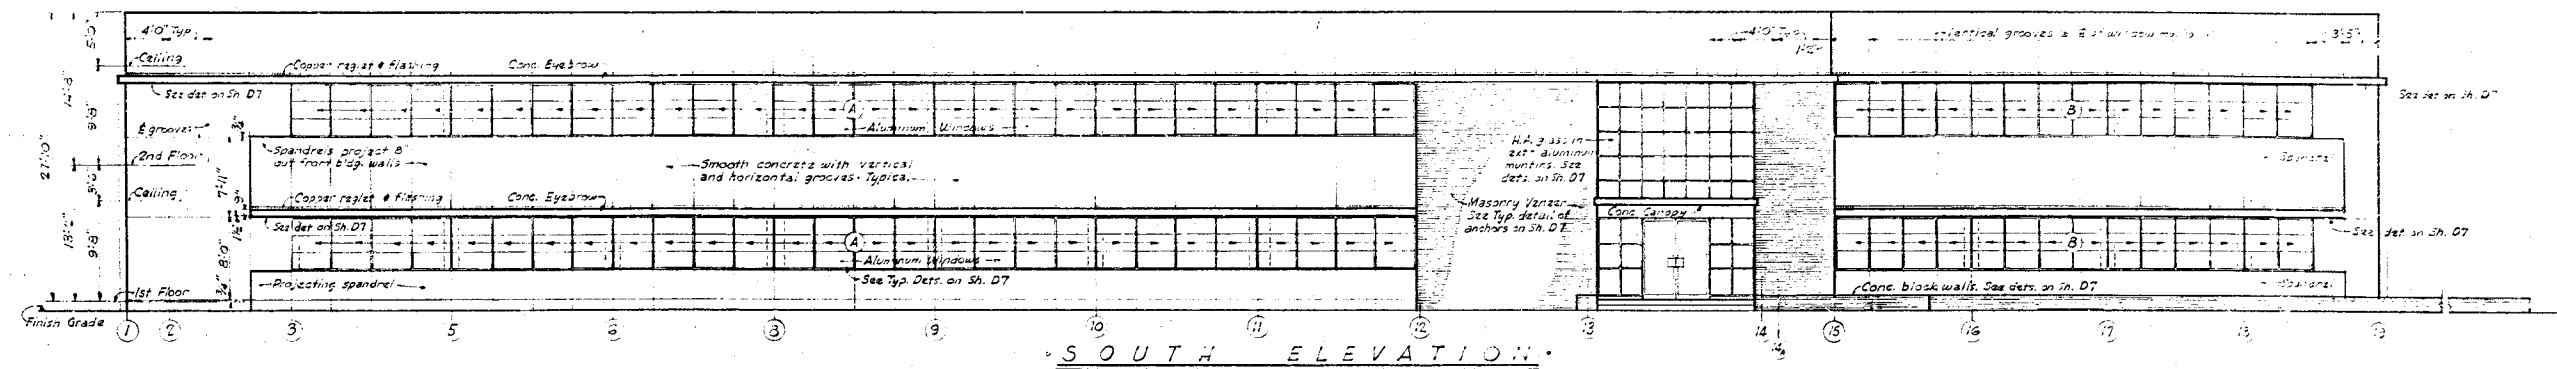

	6'-4" Window Width
	59-5902-1-1

①

WINDOW SCHEDULE

See det. on Sh. DT.


LET	DATE	REVISIONS	CHK.
NATIONAL ADVISORY COMMITTEE FOR AERONAUTICS AMES AERONAUTICAL LABORATORY MOFFETT FIELD, CALIF.			
SCALE: $\frac{1}{8}" = 1'-0"$			
MATERIAL PREST. FINISH QUAN. ASSEM. DRWG. NO.			
*3.5 FOOT HYPERSONIC TUNNEL * OFFICE BUILDING *			
EXTERIOR ELEVATIONS & CROSS SECTION			
DESIGN <i>2/21</i> DRAWN <i>ECH & PHK</i> CHECKED <i>RUH</i> RESEARCH 100-79719-125/18 100-79719-125/13	BRANCH DIVISION	DESIGN 50-21	A 11262-D4

Additional Images:

N-237: Hypervelocity Free Flight Facility



N-237, interior of Hypervelocity Free Flight Facility, test chamber
(Source: Page & Turnbull)

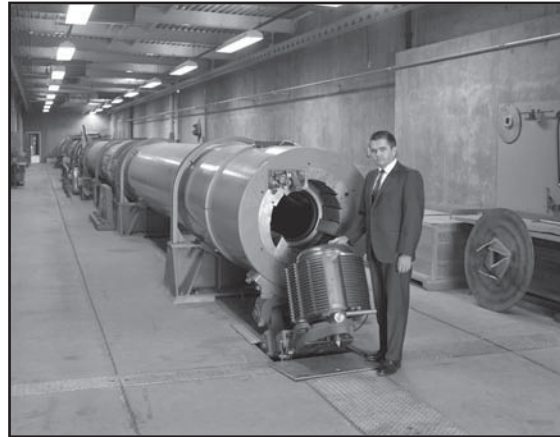

N-237, Thomas N. Canning, Hypersonic Free Flight Branch Chief inspects breech of the counter flow section of the gun, 22 June 1966
(Source: NASA Ames Research Center, A-37250)




N-237, interior of Hypervelocity Free Flight Facility, test chamber (left) and cameras (right)
(Source: Page & Turnbull)



N-237, Aerial photograph, 18 May 1989
(Source: NASA Ames Research Center, AC89-0234-153.1)



N-237, Diagram of Hypersonic Free-Flight Aerodynamic Facility, 1974
(Source: NASA Ames Facilities Summary, 1974)

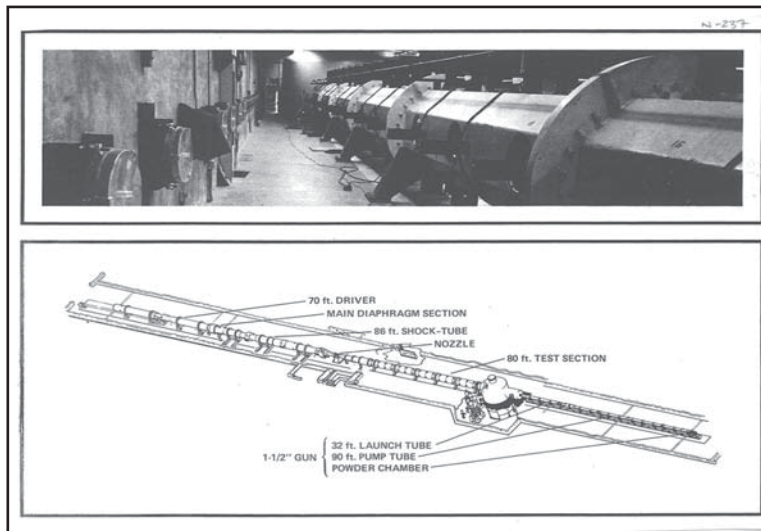

N-237, Diagram of Hypersonic Free-Flight Aerodynamic Facility, 1974
(Source: NASA Ames Facilities Summary, 1974)

Architectural Drawings for N-237

Hypervelocity Free Flight Facility Building, Perspective

Architect: B. L. Nishikian, Consulting Engineer

Date: 14 December 1962

Sheet: A12082 AR1

NASA EDC # 237-6204-A3

Hypervelocity Free Flight Facility Building, Plot Plan

Architect: B. L. Nishikian, Consulting Engineer

Date: 14 December 1962

Sheet: A12082 AR2

NASA EDC # 237-6204-A4

Hypervelocity Free Flight Facility Building, First Floor Plan - West

Architect: B. L. Nishikian, Consulting Engineer

Date: 14 December 1962

Sheet: A12082 AR3

NASA EDC # 237-6204-A5

Hypervelocity Free Flight Facility Building, First Floor Plan - East

Architect: B. L. Nishikian, Consulting Engineer

Date: 14 December 1962

Sheet: A12082 AR4

NASA EDC # 237-6204-A6

Hypervelocity Free Flight Facility Building, Second Floor Plan – East and West

Architect: B. L. Nishikian, Consulting Engineer

Date: 14 December 1962

Sheet: A12082 5 AR5

NASA EDC # 237-6204-A7

Hypervelocity Free Flight Facility Building, Basement Plan

Architect: B. L. Nishikian, Consulting Engineer

Date: 14 December 1962

Sheet: A12082 AR6

NASA EDC # 237-6204-A8

Hypervelocity Free Flight Facility Building, Elevations

Architect: B. L. Nishikian, Consulting Engineer


Date: 13 December 1962

Sheet: A12082 AR8

NASA EDC # 229-6204-A10

Hypervelocity Free Flight Facility Building, Sections
Architect: B. L. Nishikian, Consulting Engineer
Date: 14 December 1962
Sheet: A12082 AR9
NASA EDC # 237-6204-A11


U. S. F. P. BLDG. PERSPECTIVE

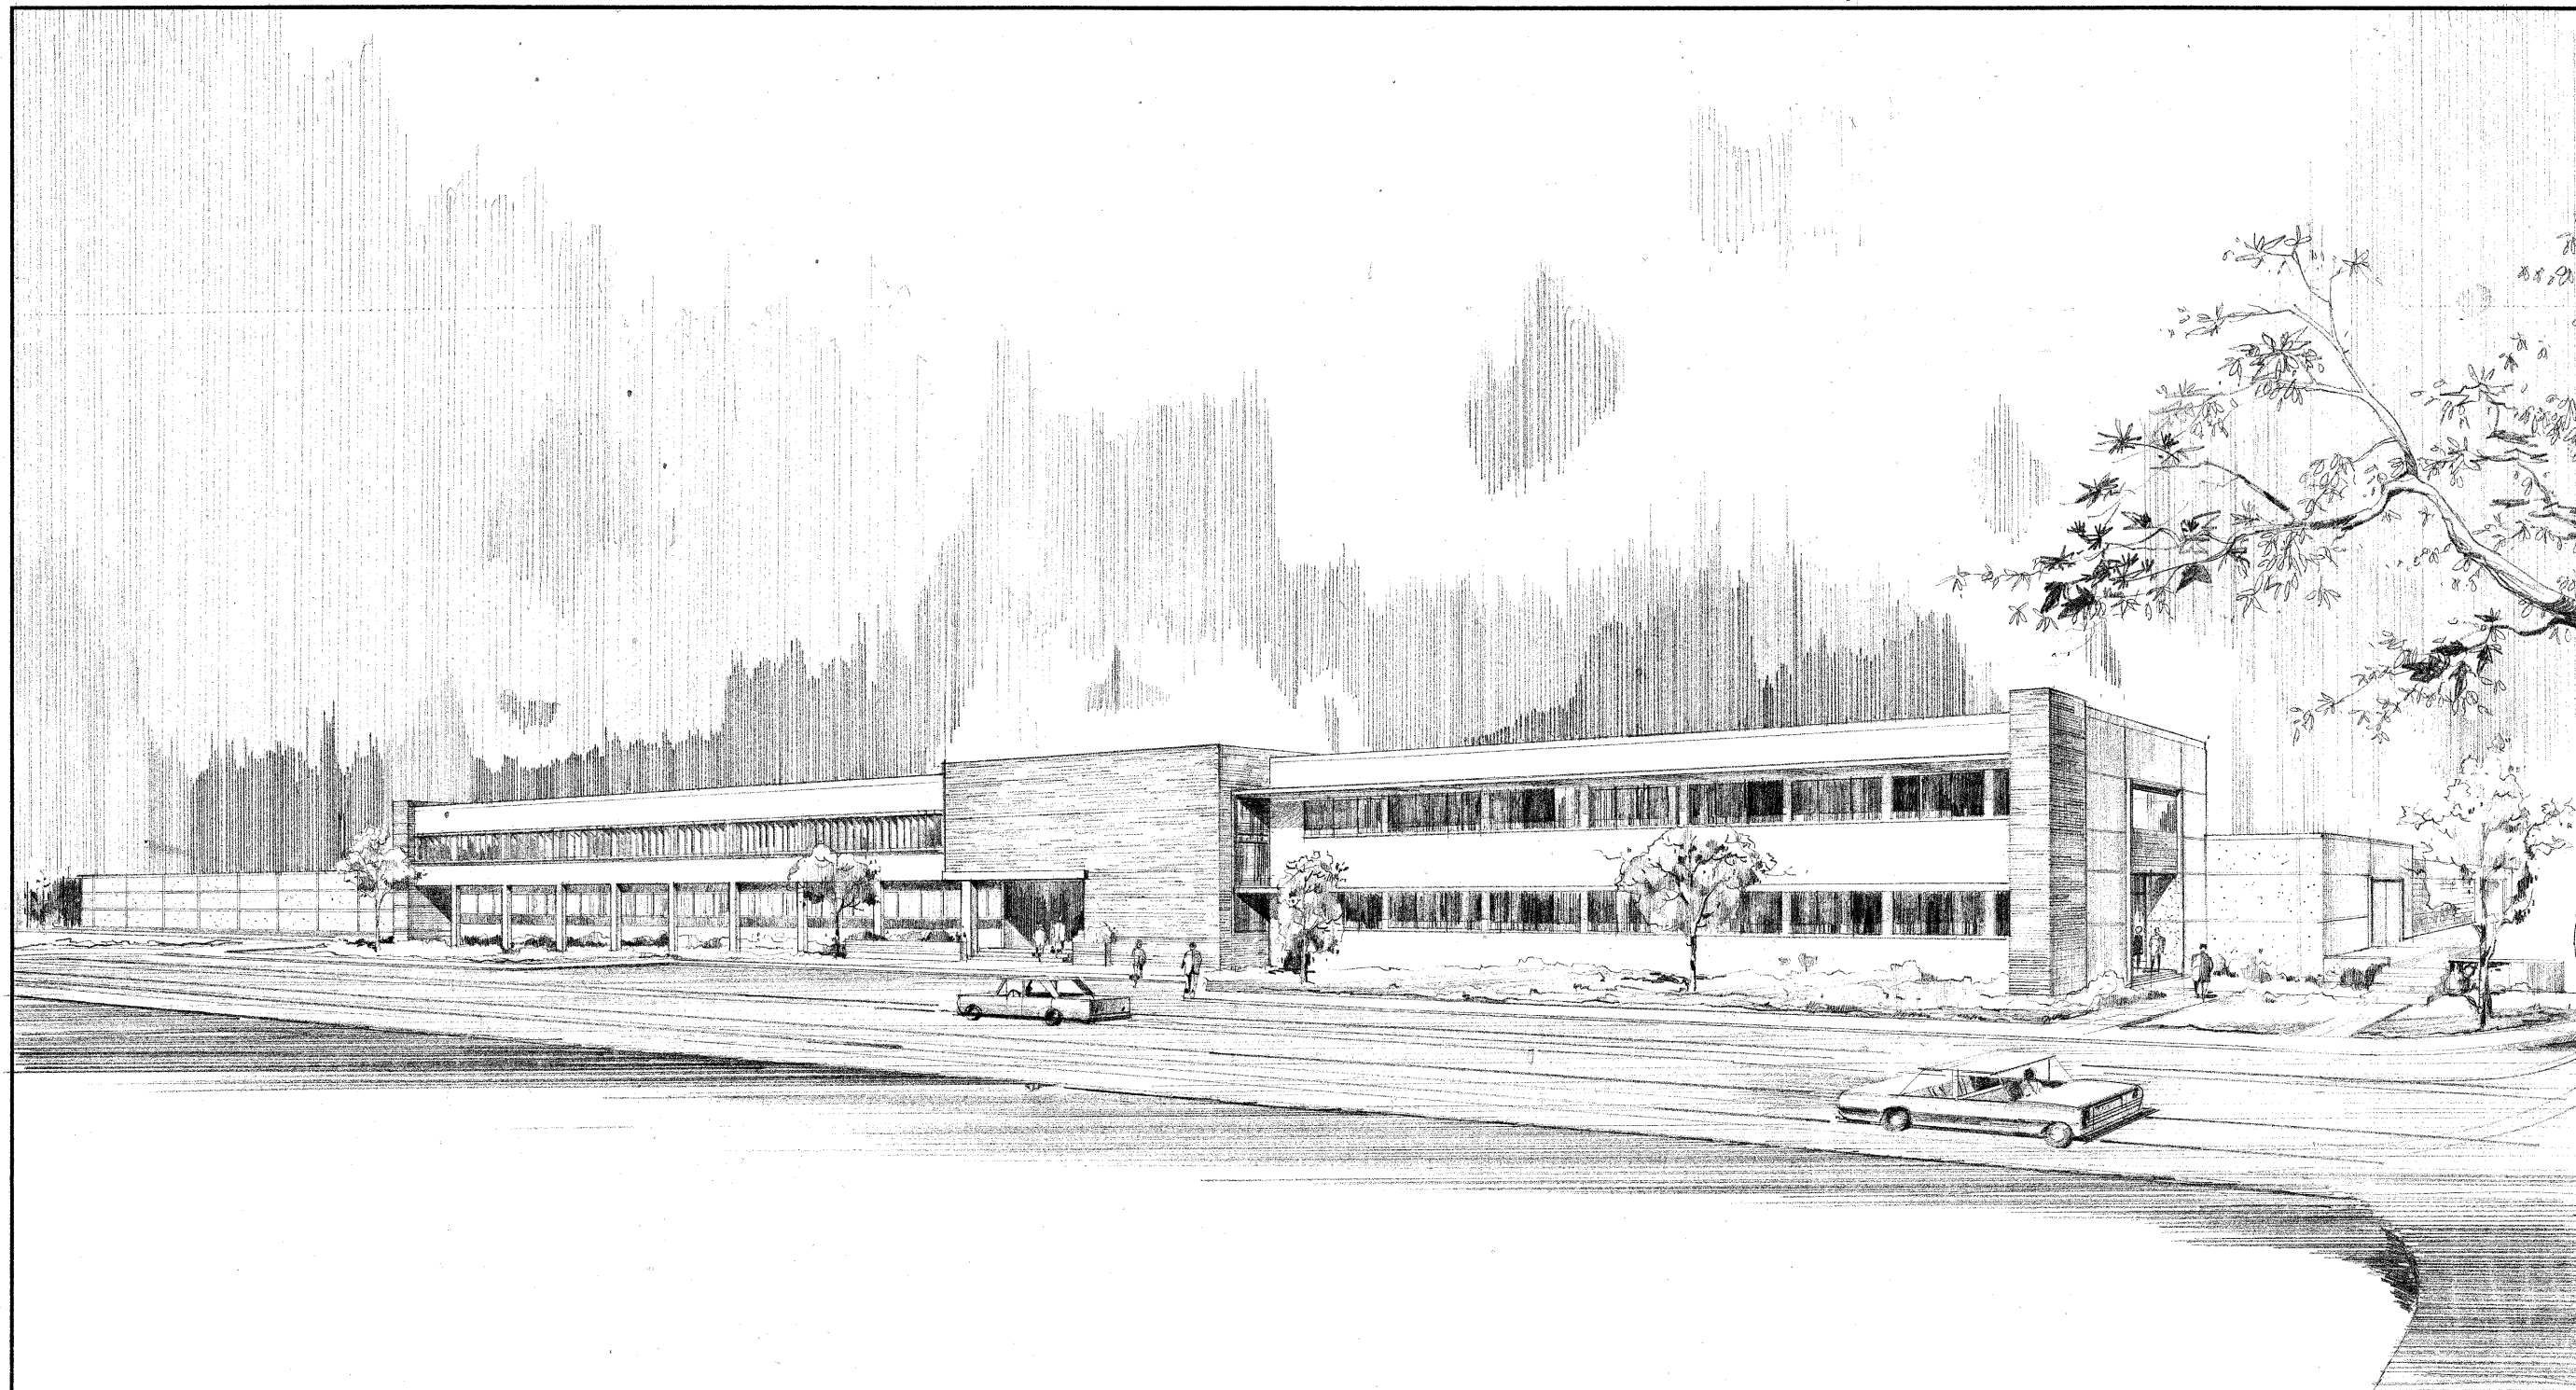

HYPERVELOCITY FREE FLIGHT FACILITY

B. L. NISHKIAN
CONSULTING ENGINEER
812 HOWARD STREET
SAN FRANCISCO 3 CALIFORNIA
2873 12-14-62


LETTER	DATE	REVISION DESCRIPTION	DRAWN	APP
NATIONAL AERONAUTICS AND SPACE ADMINISTRATION AMES RESEARCH CENTER MOFFETT FIELD, CALIFORNIA				
HYPERVELOCITY FREE FLIGHT FACILITY BUILDING PERSPECTIVE				
DRAWN D.W.	CHECKED RM	INDEX RM	MATERIAL	LIMITS UNLESS NOTED
DESIGN ENGINEER 28	BRANCH S.S.F.F.	1 OF 96	FRAC	DEC
APPROVED 12/14/62	ASST. ENGR. SCALE	A12082 AR1	REV	

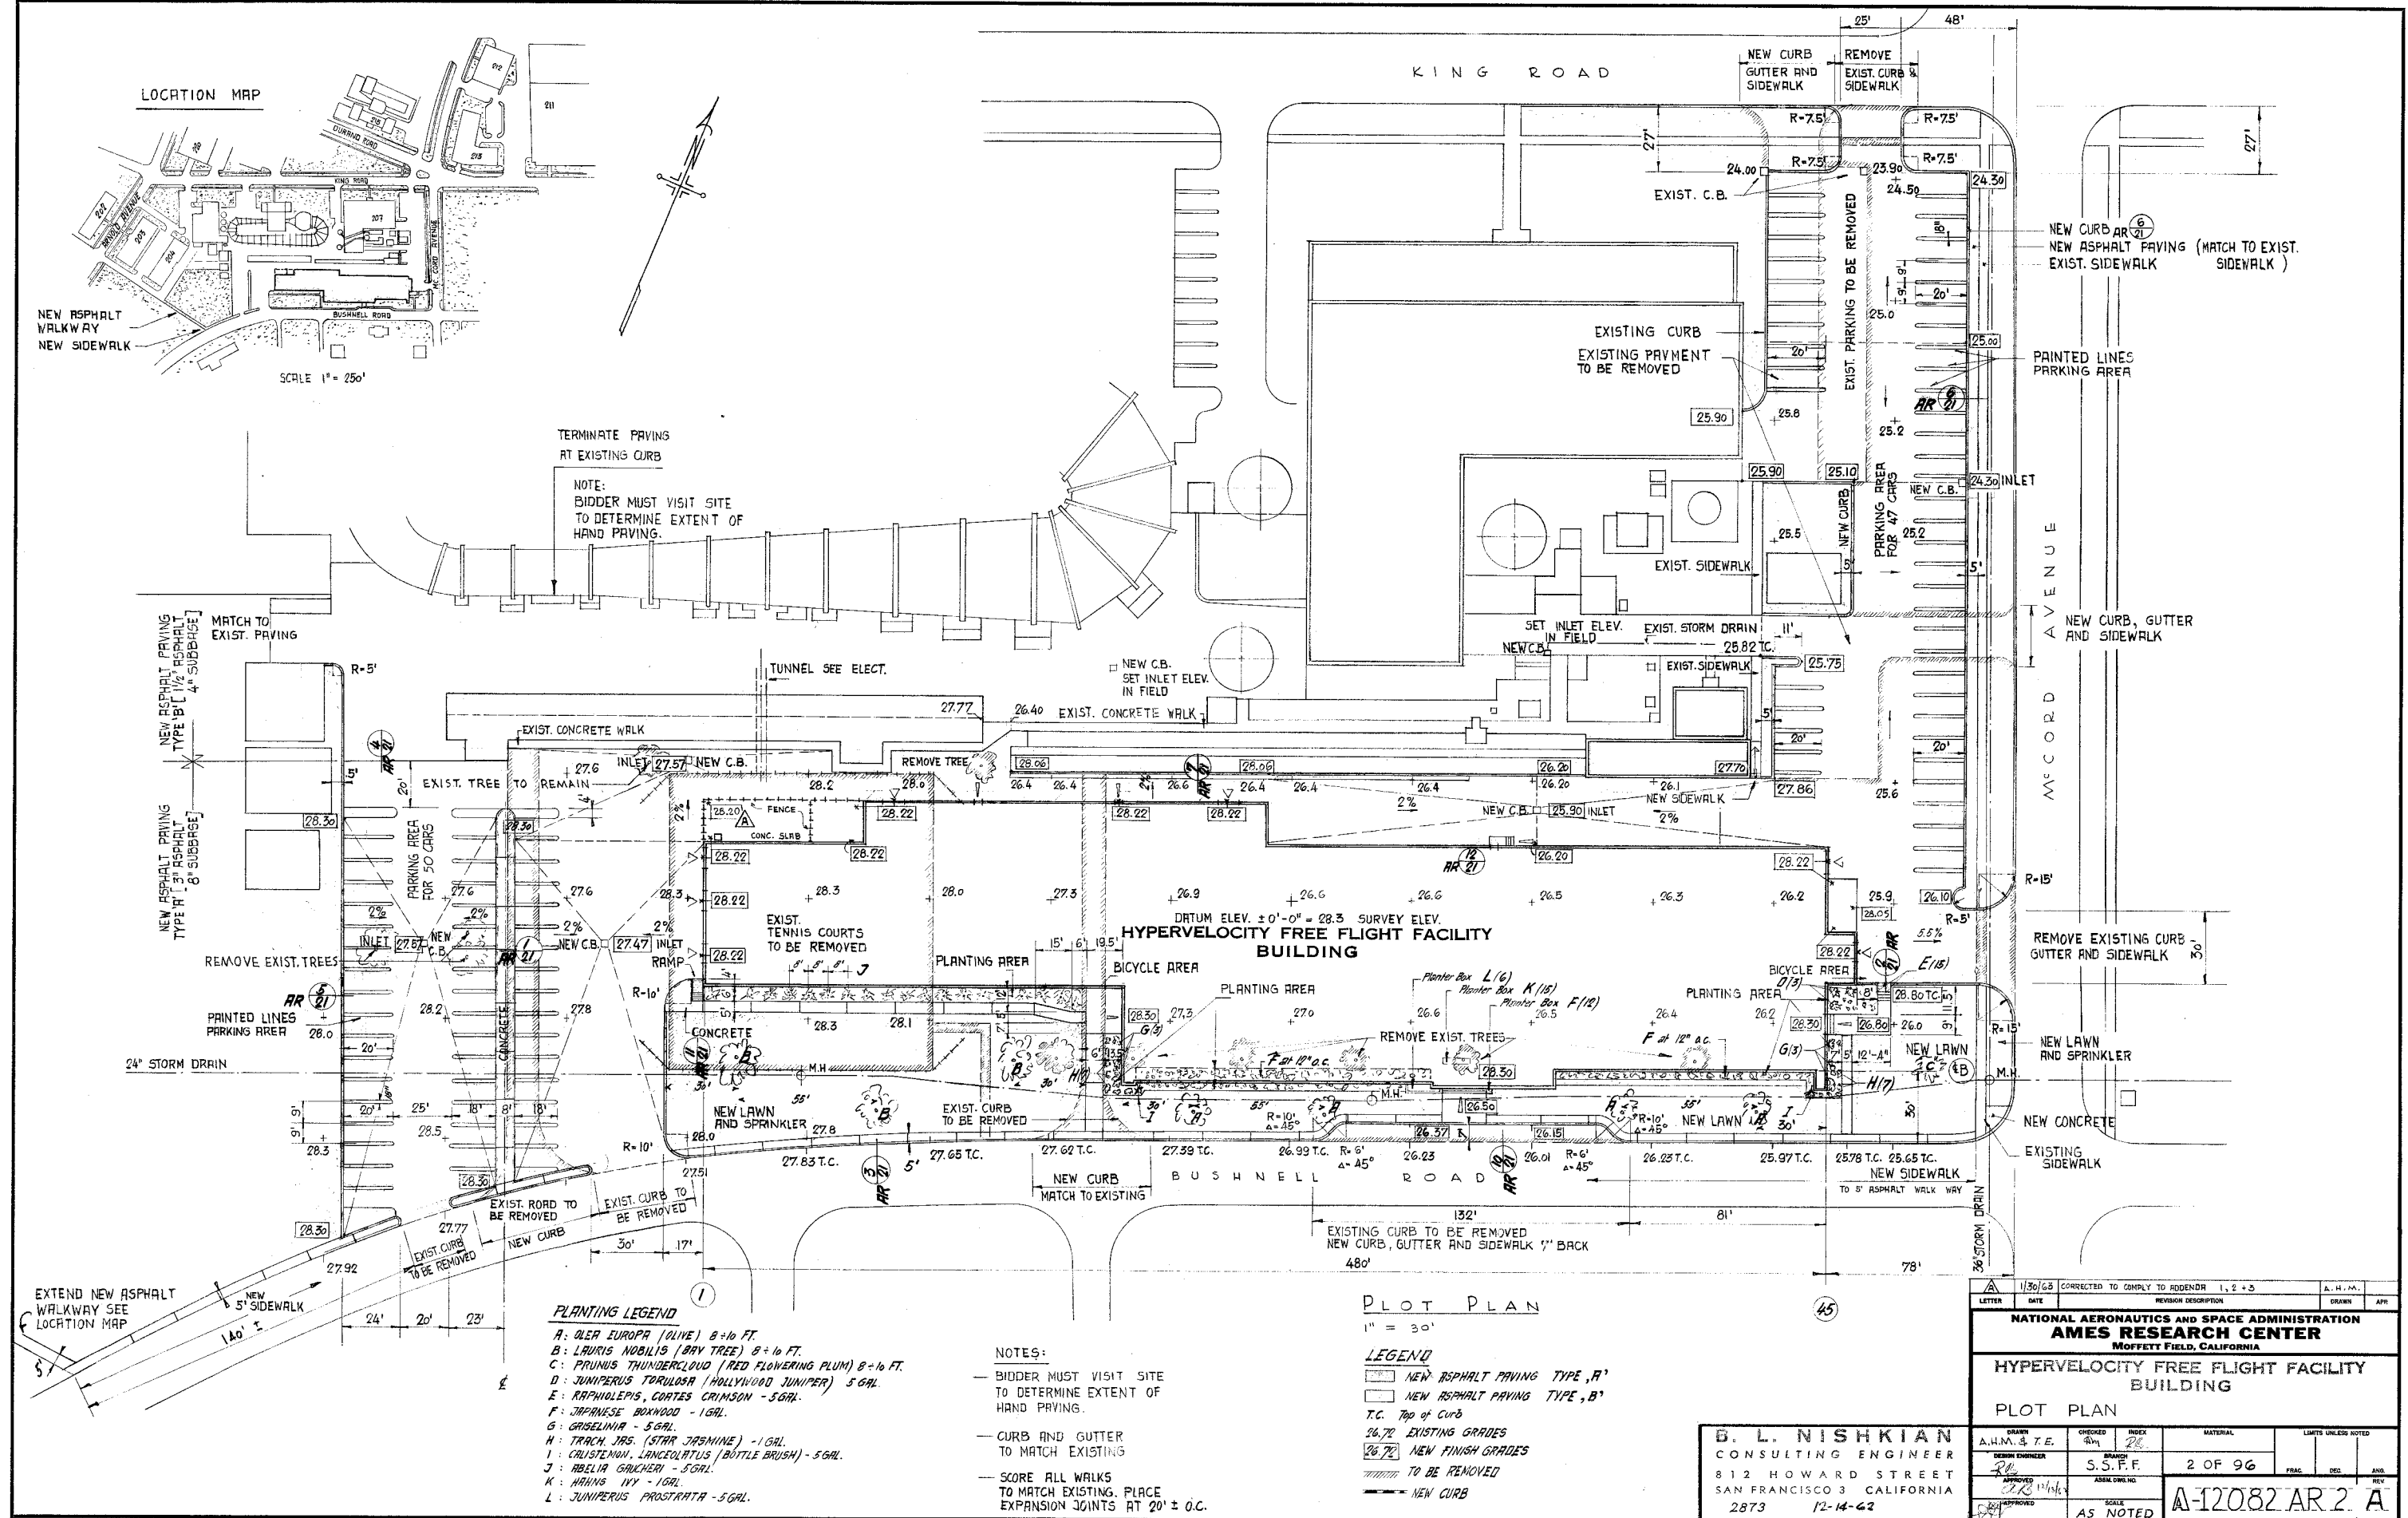

237-6204 A - 4	H. F. F. F. Bldg. Plot PLAN
----------------	-----------------------------

A

2	3	7	-	6	2	0	4	A	-	-	-	4
---	---	---	---	---	---	---	---	---	---	---	---	---

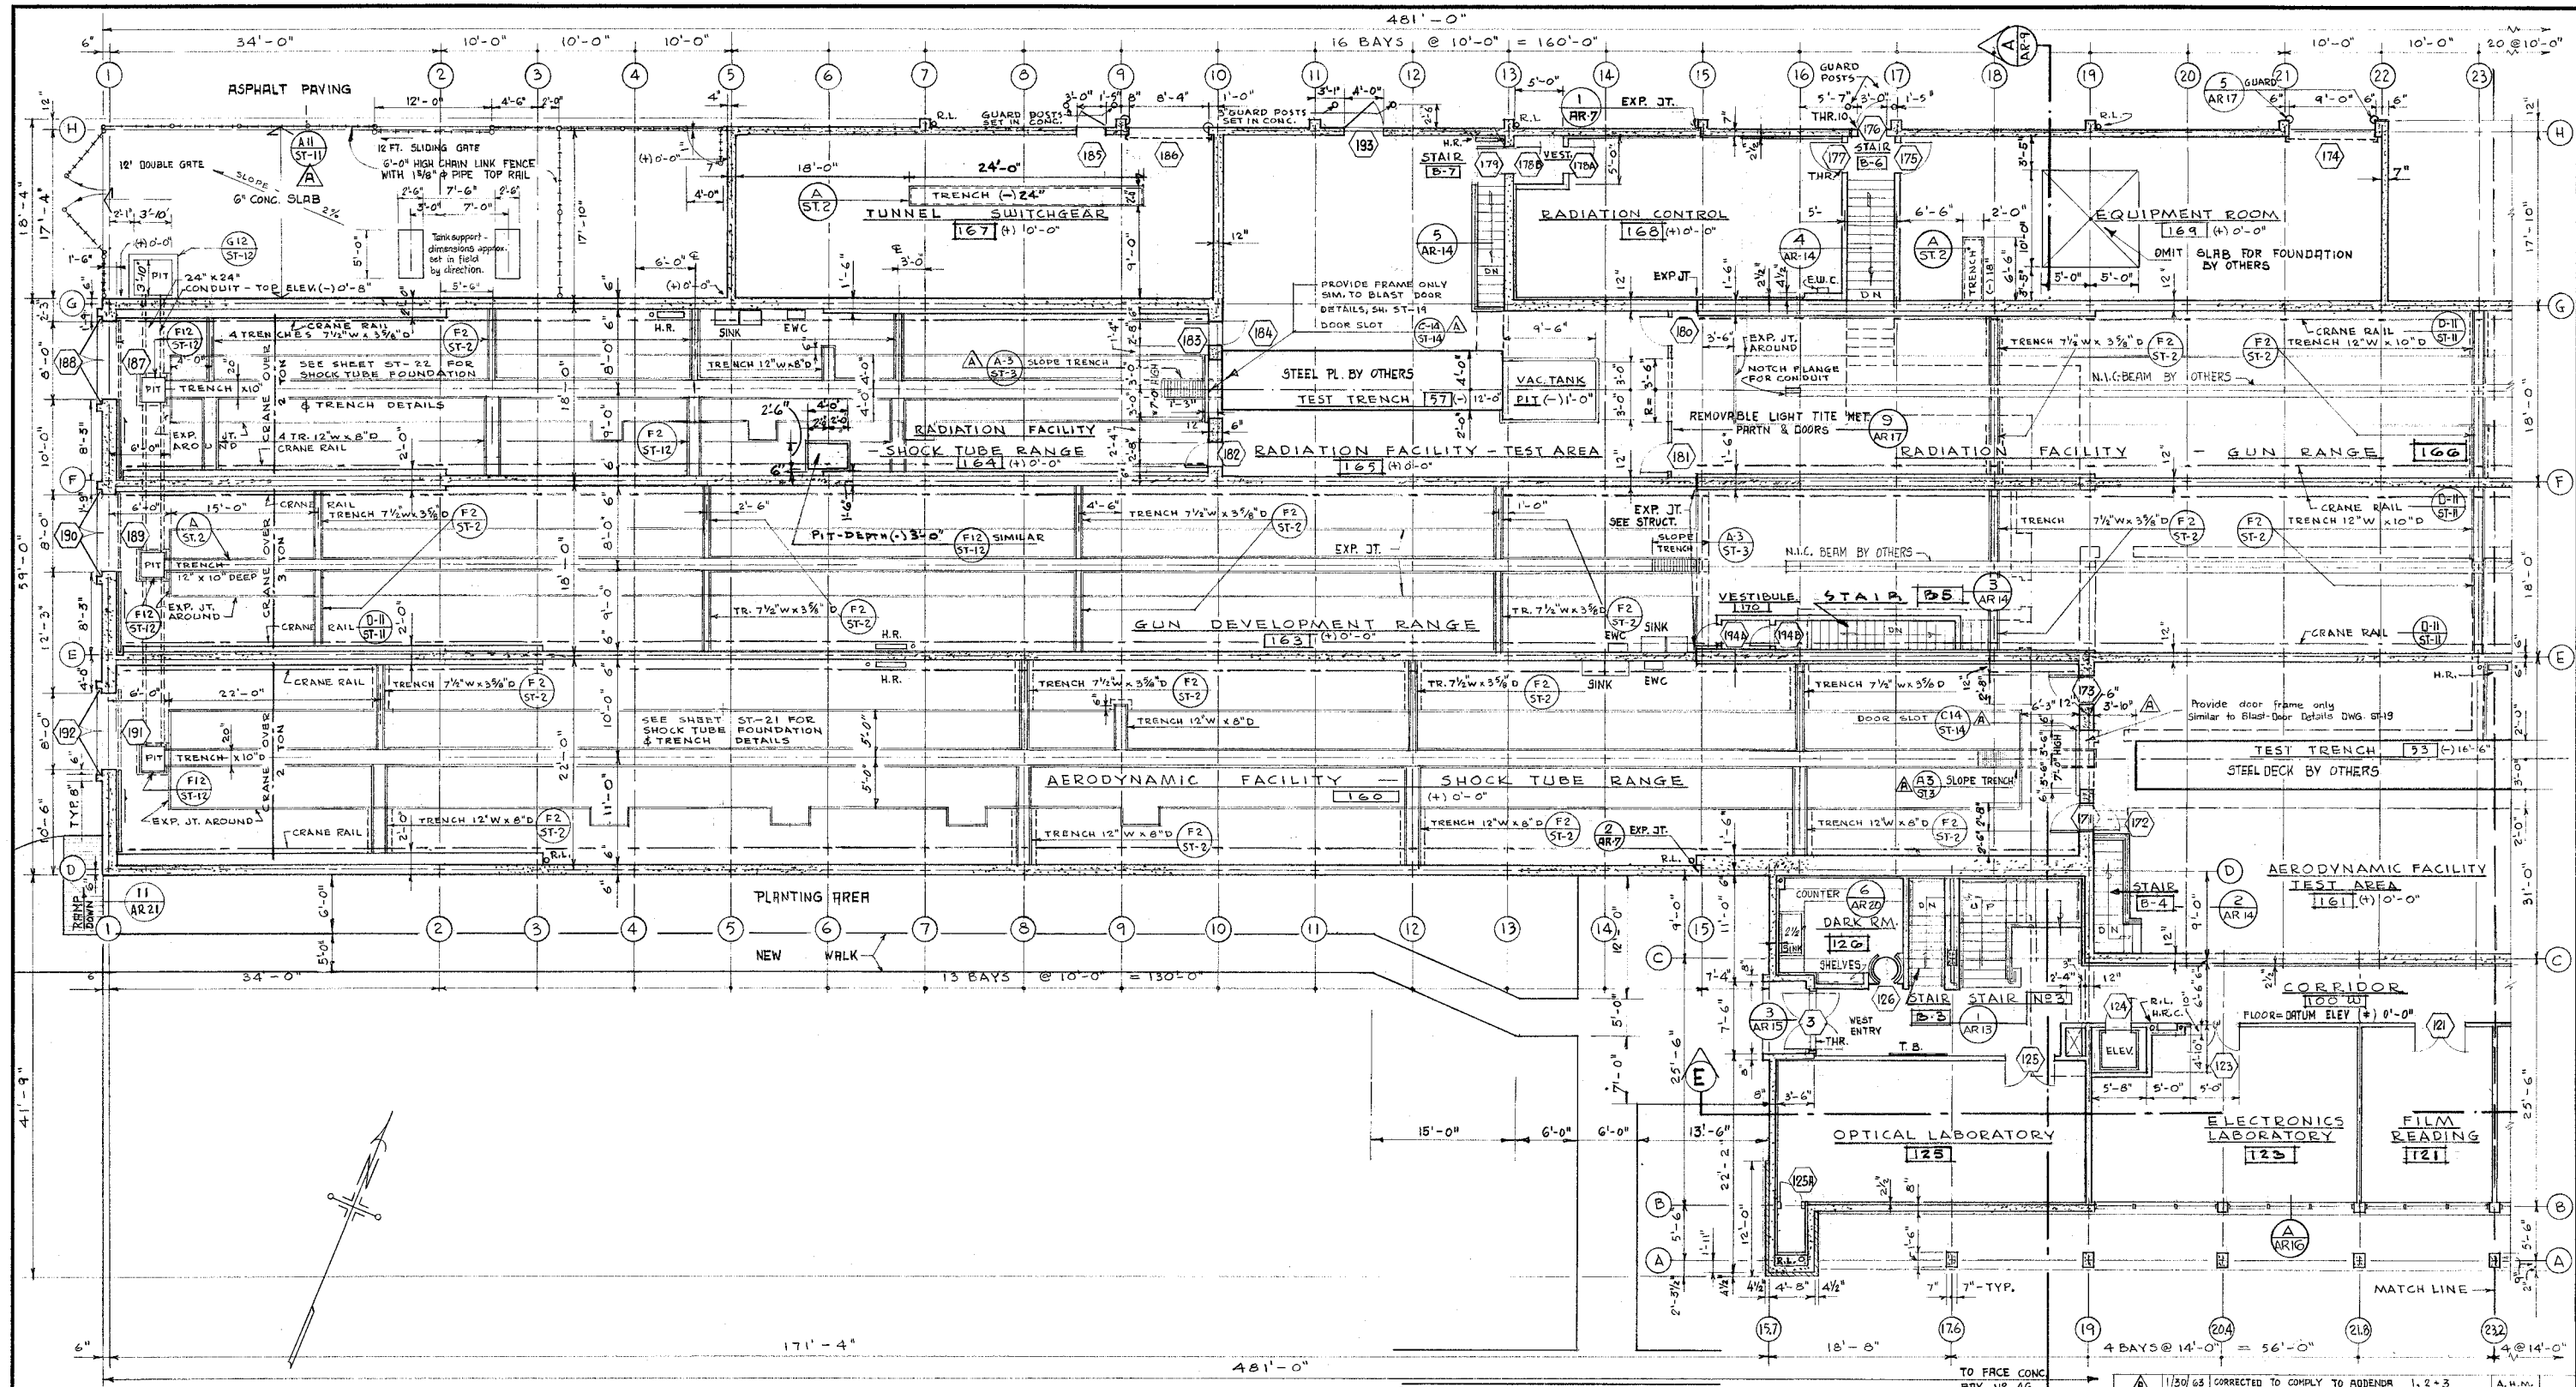

ABBREVIATIONS:

E.W.C. — ELECTRIC WATER COOLER
 N.I.C. — NOT IN CONTRACT
 R.L. — RAIN LEADER
 H.R. — FIRE HOSE REEL
 H.R.C. — HOSE REEL CABINET
 THR. — THRESHOLD
 EXP. JT. — EXPANSION JOINT
 TYP. — TYPICAL
 T.B. — TACK BOARD 6'-0" x 3'-6" UP 3'-6" FROM FLR.

LEGEND


— CONCRETE
 — SPLIT BLOCK VENEER
 — MET. STUD & PLASTER
 — DOOR NO.
 — DETAIL NO.
 — SHEET NO.

FIRST FLOOR PLAN - WEST
 1/8" = 1'-0"

B. L. NISHKIAN
 CONSULTING ENGINEER
 812 HOWARD STREET
 SAN FRANCISCO 3 CALIFORNIA
 2873 12-14-62

NATIONAL AERONAUTICS AND SPACE ADMINISTRATION AMES RESEARCH CENTER MOFFETT FIELD, CALIFORNIA			
HYPERVELOCITY FREE FLIGHT FACILITY BUILDING			
FIRST FLOOR PLAN - WEST			
DRAWN A.H.N. & T.E. CHECKED S.S.F.F. INDEX 3 OF 96 MATERIAL LIMITS UNLESS NOTED	DATE 1/30/63 CORRECTED TO COMPLY TO ADDENDUM 1, 2 & 3	A.H.N. DRAWN S.S.F.F. CHECKED 12/14/62	APPROVED A-12082 AR 3 A

237-6204 A-5
 H.F.F. Bldg. FIRST FLOOR PLAN WEST

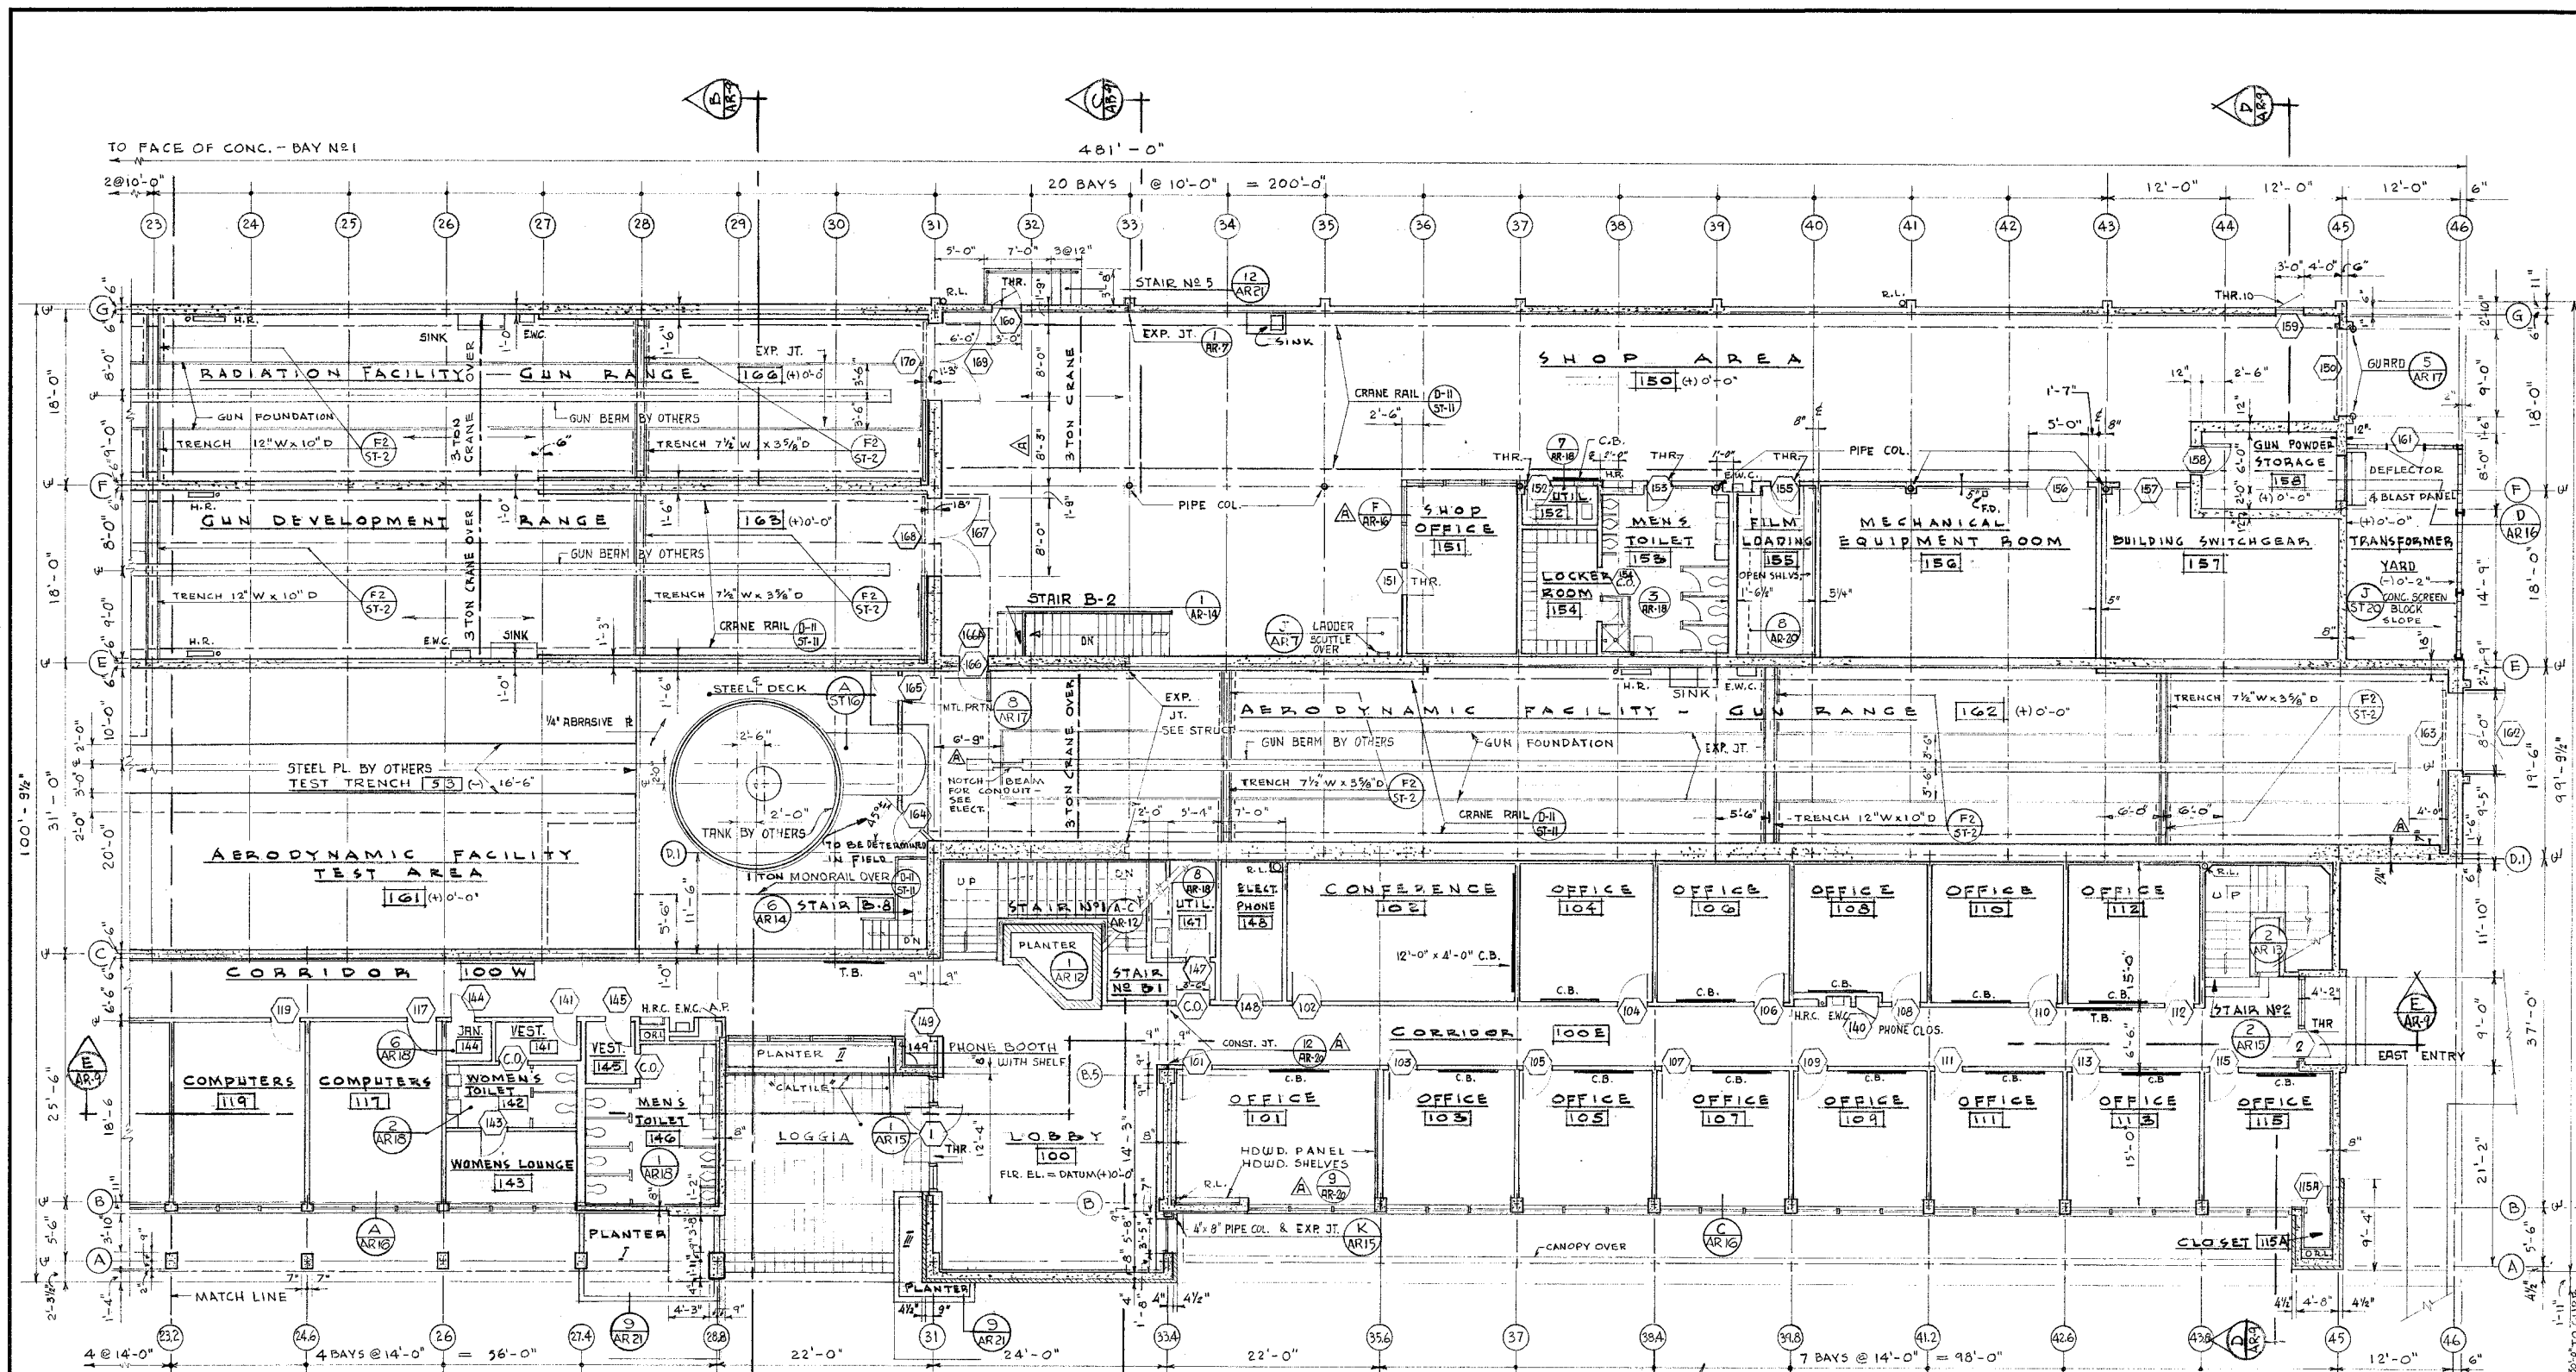

PLANTING LEGEND

Planter I: 6 Juniperus Prostrata - 5 Gal.
 Planter II: 15 Mahoe Ivy - 1 Gal.
 Planter III: 12 Japanese Boxwood - 1 Gal.

ABBREVIATIONS

T.B. - TACK BOARD 6'-0" x 3'-6"
 R.L. - RAIN LEADER
 E.W.C. - ELECTRIC WATER COOLER
 H.R.C. - HOSE REEL CABINET
 THR. - THRESHOLD
 EXP. JT. - EXPANSION JOINT
 TYP. - TYPICAL
 A.P. - ACCESS PANEL (MILCOR TYPE K)
 C.B. - CHALK BOARD 6'-0" x 5'-6" TYPICAL FOR OFFICES

LEGEND

- CONCRETE
- SPLIT BLOCK VENEER
- METAL STUDS & PLASTER
- DOOR NO.
- DETAIL NO.
- SHEET NO.


FIRST FLOOR PLAN - EAST

1/8" = 1'-0"


B. L. NISHKIAN
 CONSULTING ENGINEER
 812 HOWARD STREET
 SAN FRANCISCO 3 CALIFORNIA
 2873 12-14-62

1/30/65 CORRECTED TO COMPLY TO ADDENDUM 1, 2 & 3		A.H.M.	
LETTER	DATE	REVISION DESCRIPTION	APP.
NATIONAL AERONAUTICS AND SPACE ADMINISTRATION AMES RESEARCH CENTER MOFFETT FIELD, CALIFORNIA			
HYPERVELOCITY FREE FLIGHT FACILITY BUILDING FIRST FLOOR PLAN - EAST			
DRAWN A.H.M. & T.E. CHECKED S.S.F.F. INDEX 76 MATERIAL 4 OF 96 LIMITS UNLESS NOTED	SCALE A12082 AR4 A		

287-6204 A-6
 H.F.F. BLDG. FIRST FLOOR PLAN EAST

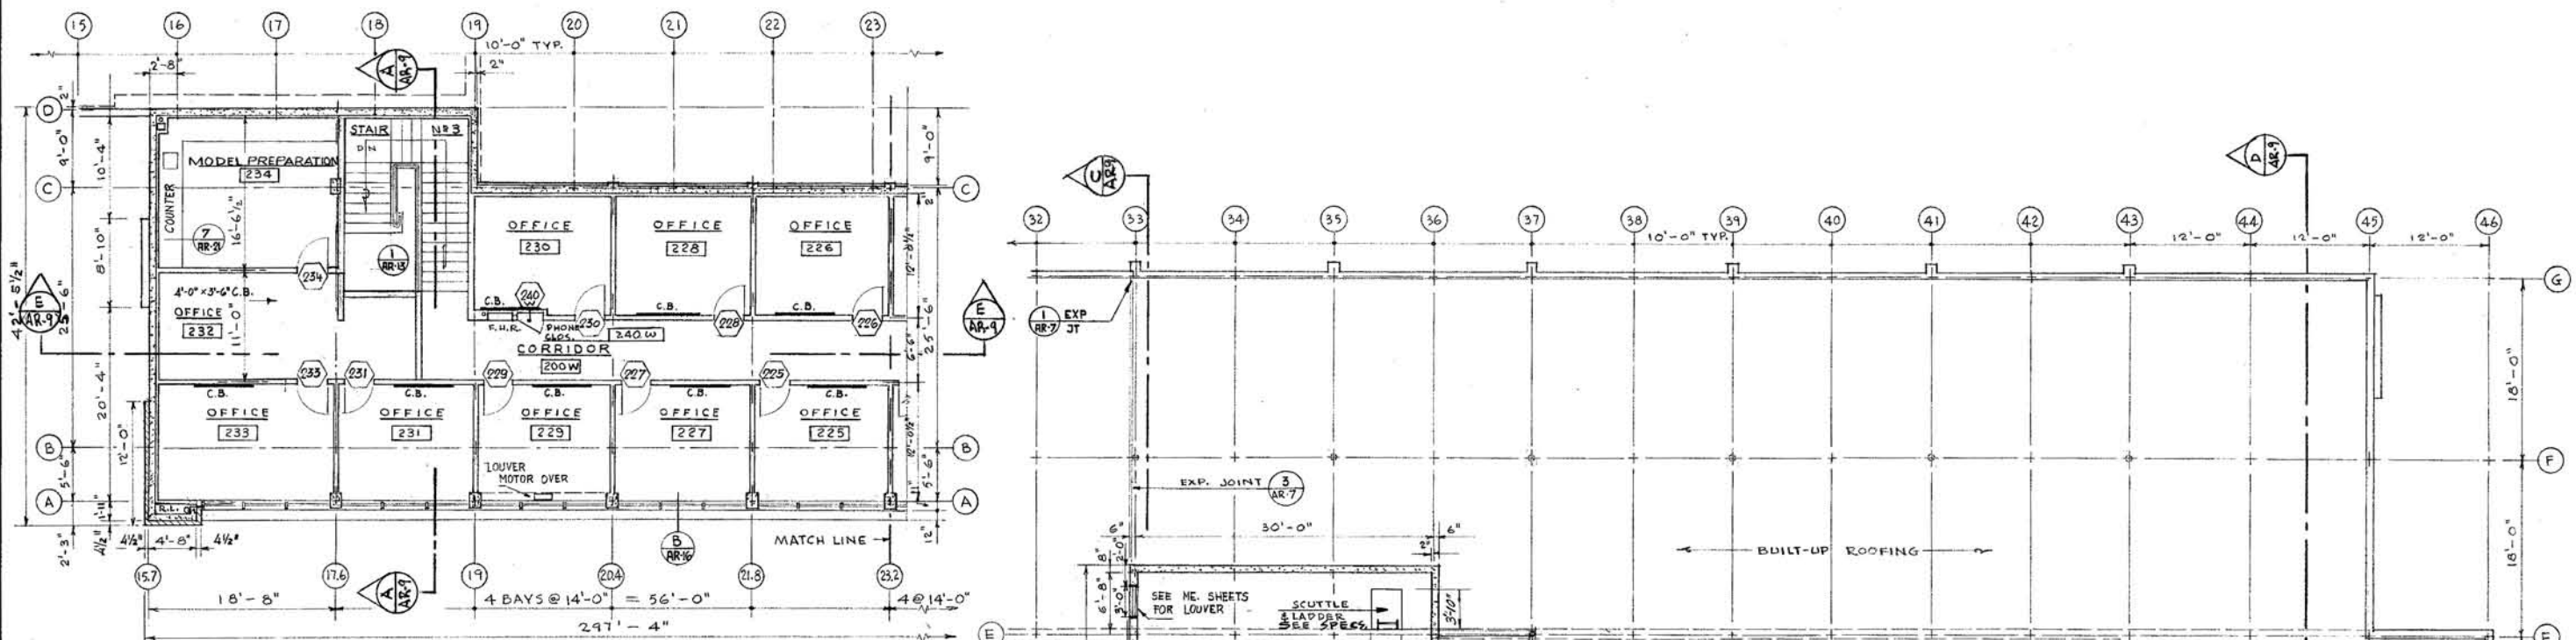

SECOND FLOOR PLAN - WEST
1/8" = 1'-0"

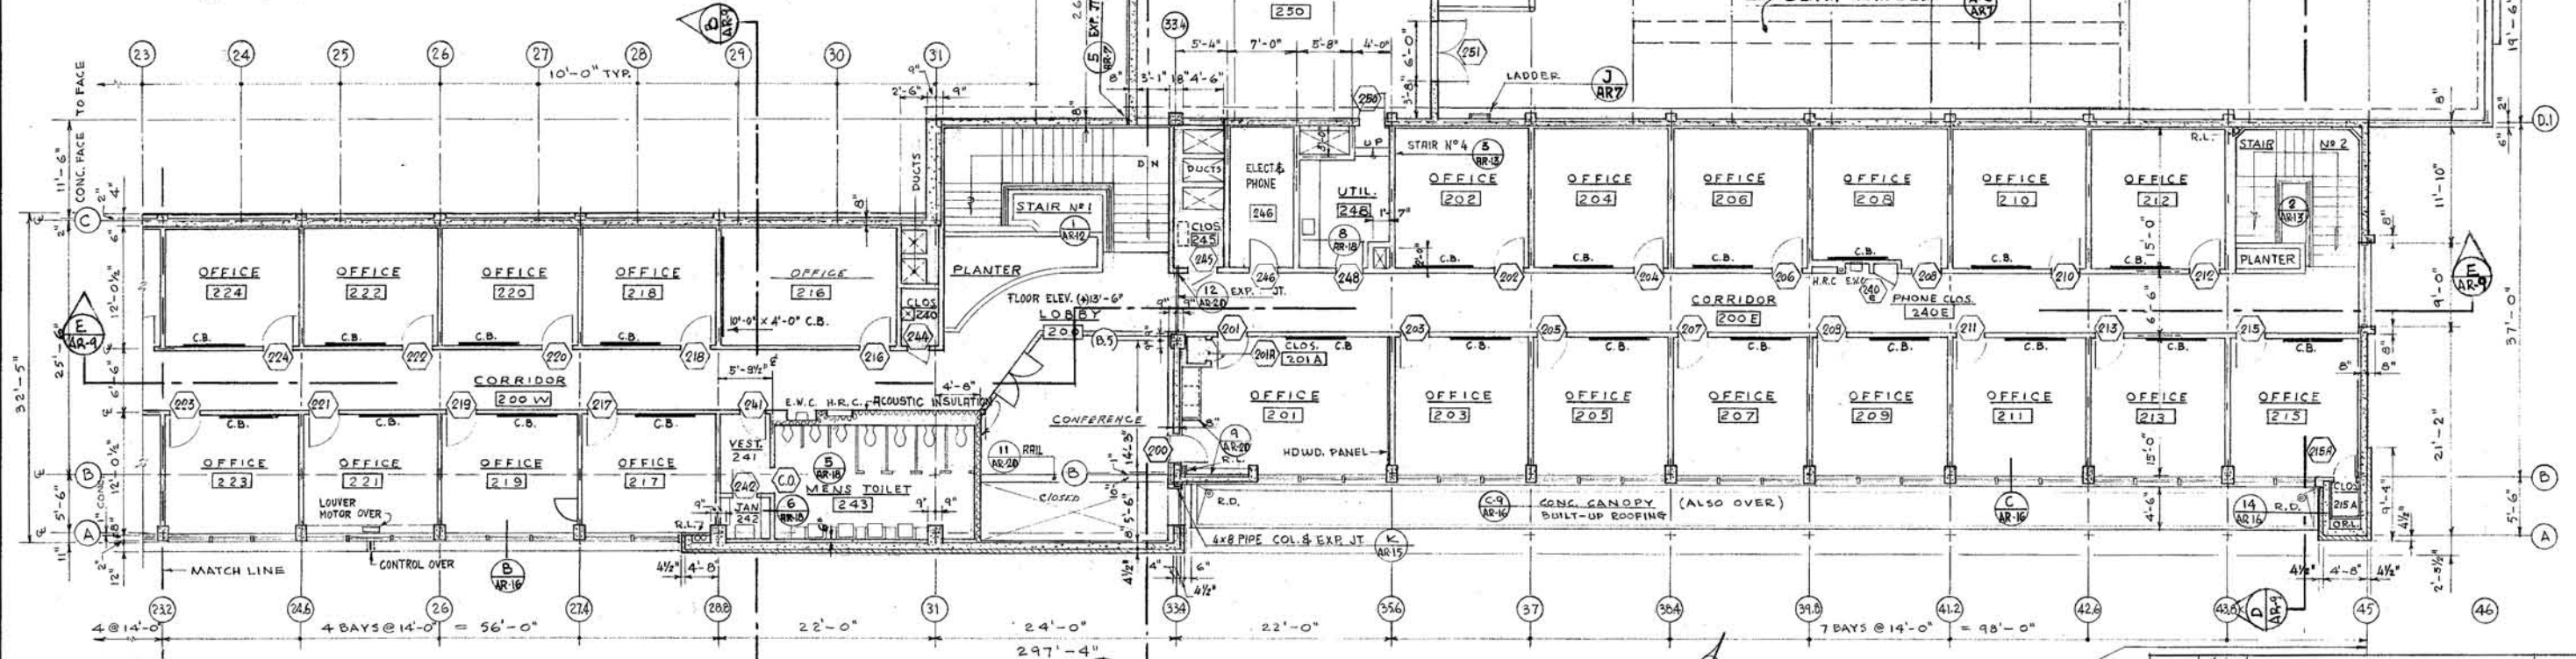

SECOND FLOOR PLAN - EAST
1/8" = 1'-0"

ABBREVIATIONS:

- R.L. — RAIN LEADER
- H.R. — FIRE HOSE REEL
- H.R.C. — HOSE REEL CABINET
- N.I.C. — NOT IN CONTRACT
- EXP. JT. — EXPANSION JOINT
- TYP. — TYPICAL
- THR. — THRESHOLD
- E.W.C. — ELECTRIC WATER COOLER
- C.B. — CHALK BOARD 6'-0" X 3'-6" [TYPICAL FOR OFFICES]


LEGEND

- CONCRETE
- SPLIT BLOCK VENEER
- MET. STUD & PLASTER
- DOOR N°
- DETAIL N°
- SHEET N°

A		4/1/79		CONFERENCE ROOM		E. J.	
LETTER	DATE	REVISION DESCRIPTION				DRAWN	APP.
NATIONAL AERONAUTICS AND SPACE ADMINISTRATION							
AMES RESEARCH CENTER							
MOFFETT FIELD, CALIFORNIA							
HYPERVELOCITY FREE FLIGHT FACILITY							
BUILDING							
SECOND FLOOR PLAN - EAST & WEST							
DESIGN ENGINEER	CHECKED	INDEX	NATIONAL		LIMITS UNLESS NOTED		
BRANCH ENGINEER	REV.	REV.	5 OF 96		FRAC	DEC	AME
APPROVED	APPROVED	APPROVED	SCALE		A-12082 AR 5		

B. L. NISHKIAN
CONSULTING ENGINEER
812 HOWARD STREET
SAN FRANCISCO 3, CALIFORNIA
2873 12-14-62

237-6204A-7
H.F.F. BLOC. SECOND FLOOR PLAN EAST & WEST

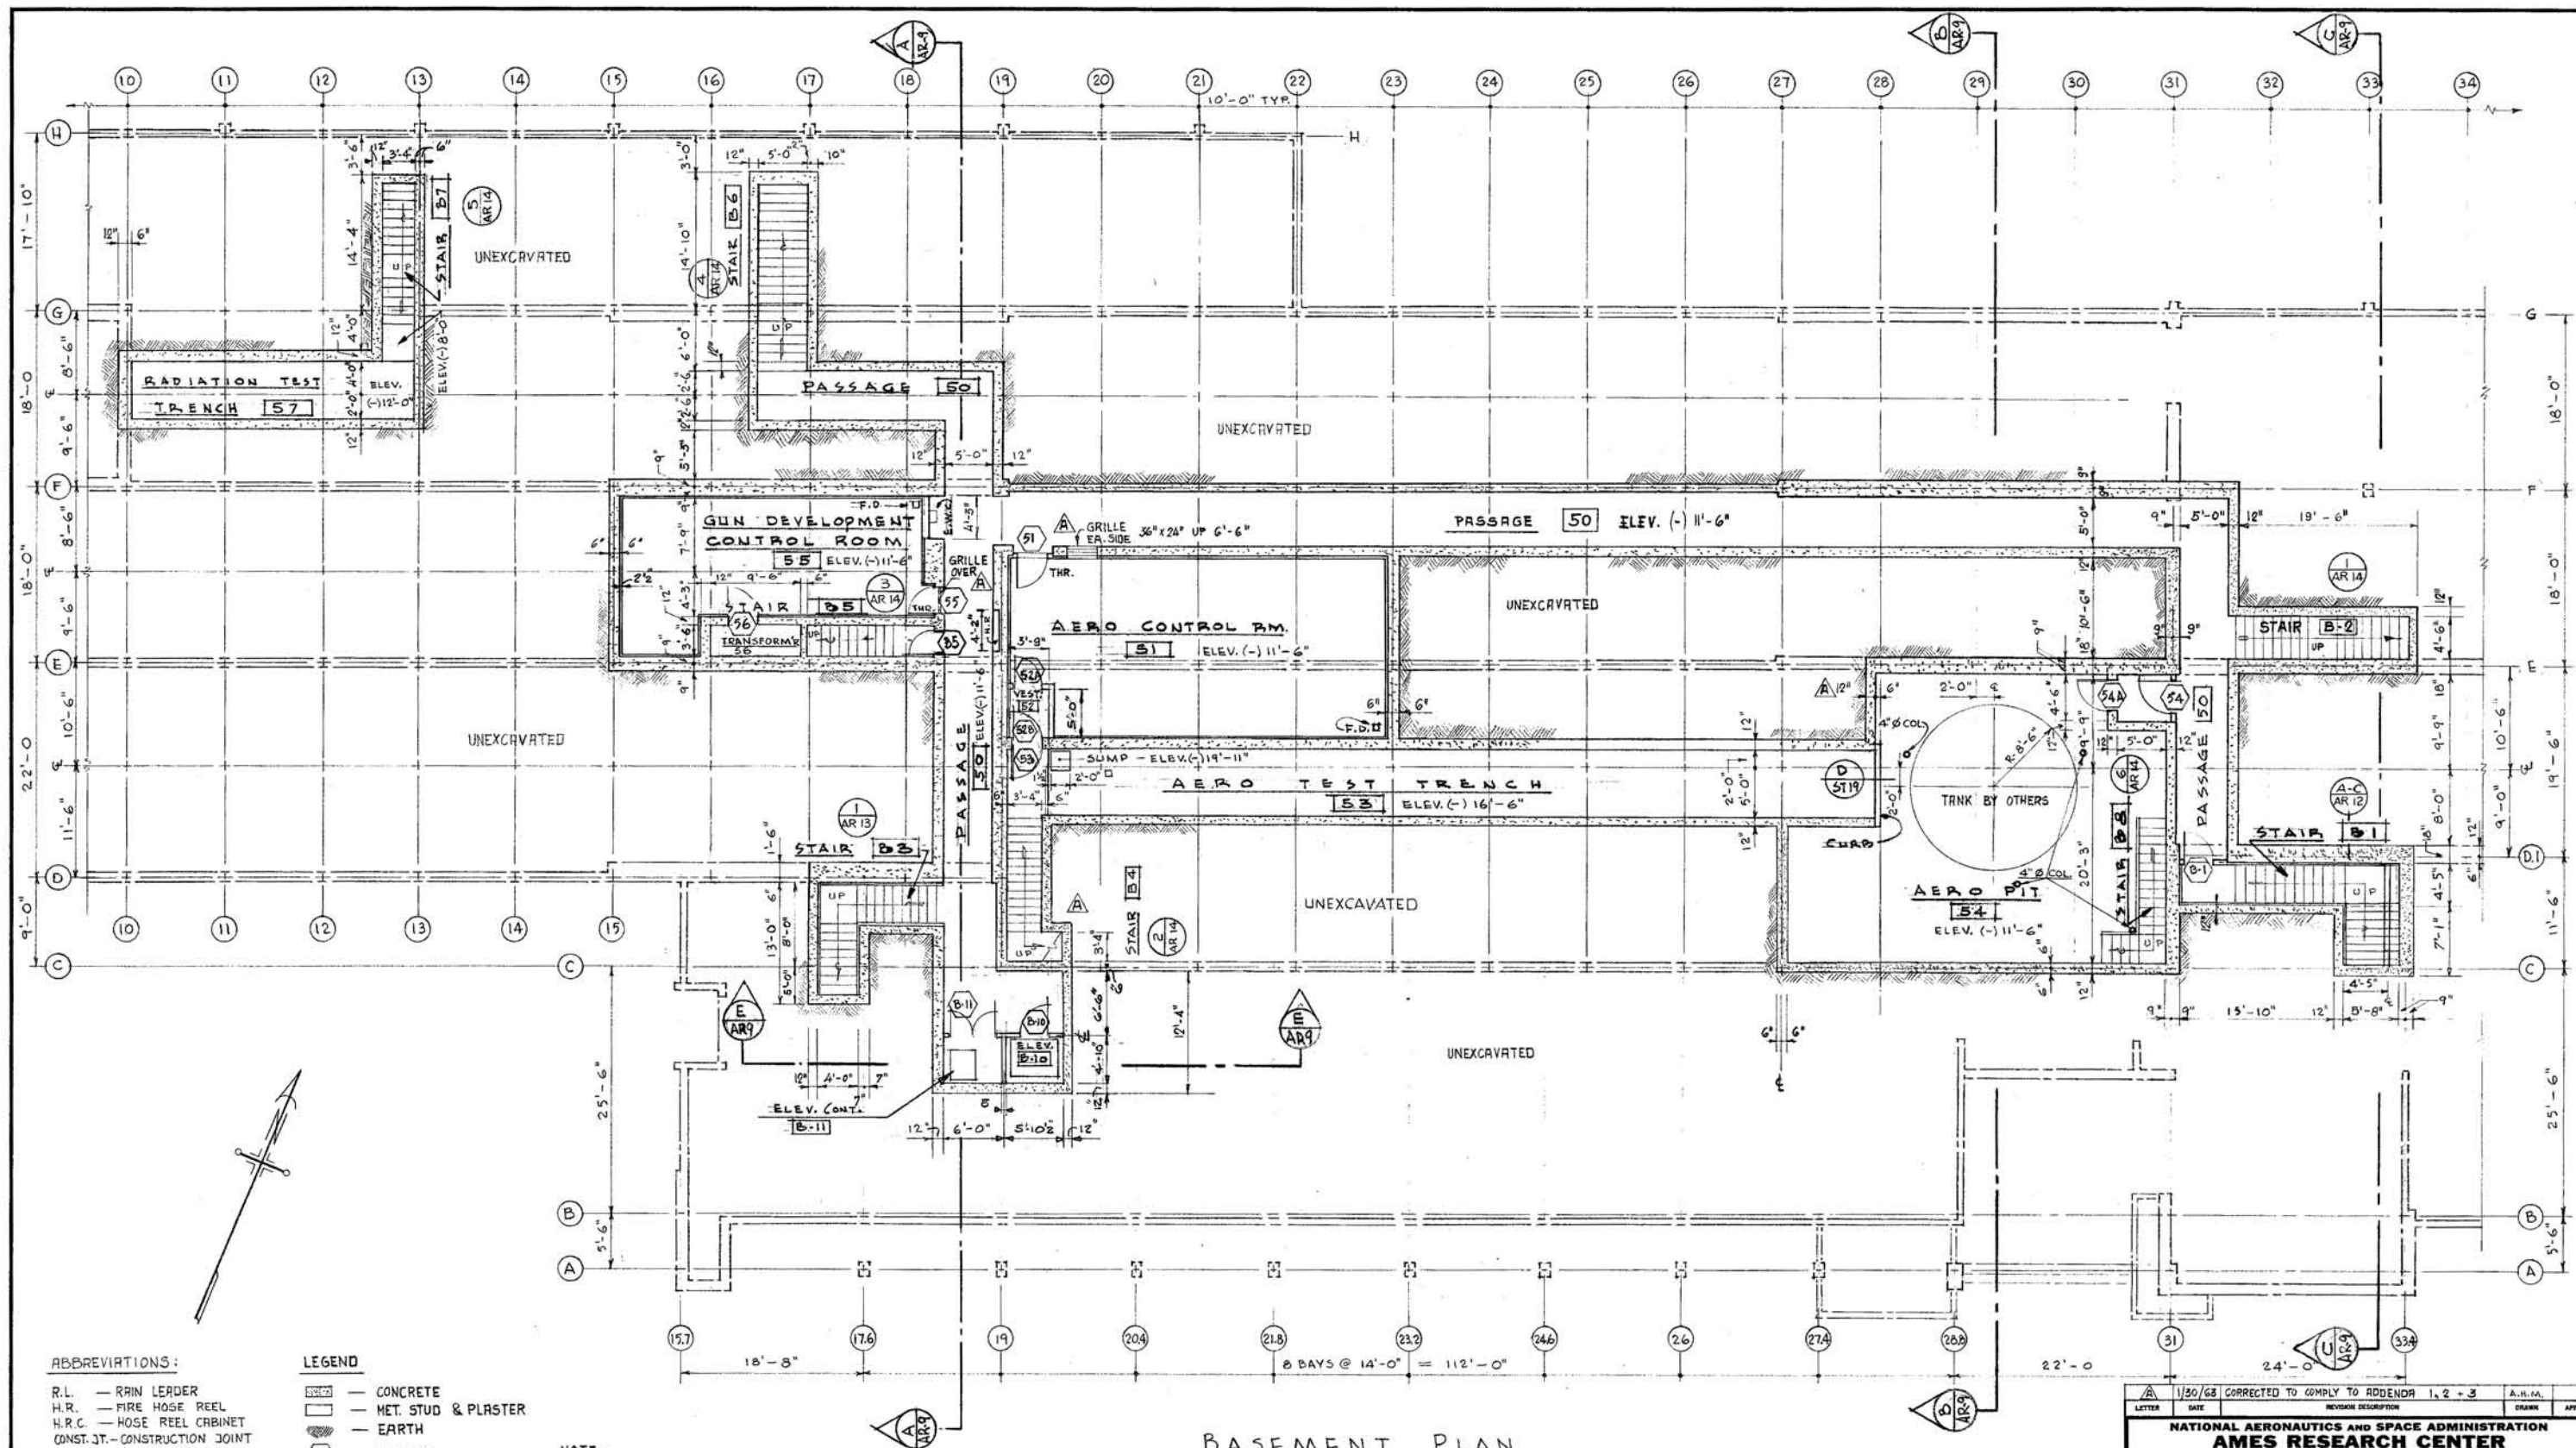

ABBREVIATIONS:

R.L. — RAIN LEADER
H.R. — FIRE HOSE REEL
H.R.C. — HOSE REEL CABINET
CONST. JT. — CONSTRUCTION JOINT
EXP. JT. — EXPANSION JOINT
TYP. — TYPICAL
THR. — THRESHOLD
E.W.C. — ELECTRIC WATER COOLER
N.I.C. — NOT IN CONTRACT

LEGEND

CONCRETE
MET. STUD & PLASTER
EARTH
DOOR NO.
DETAIL NO.
SHEET NO.

NOTE:

FOR ALL STAIR DETAILS, SEE SHEETS AR 11, AR 12 & AR 13
FOR DOOR DETAILS, SEE SHEET AR 17


BASEMENT PLAN

1/8" = 1'-0"


B. L. NISHKIAN
CONSULTING ENGINEER
812 HOWARD STREET
SAN FRANCISCO 3 CALIFORNIA
2873 12-14-62

1/30/63 CORRECTED TO COMPLY TO ADDENDUM 1, 2 & 3		A.H.M.	
LETTER	DATE	REVISION DESCRIPTION	APP.
NATIONAL AERONAUTICS AND SPACE ADMINISTRATION AMES RESEARCH CENTER MOFFETT FIELD, CALIFORNIA			
HYPERVELOCITY FREE FLIGHT FACILITY BUILDING			
BASEMENT PLAN			
DESIGN ENGINEER	CHECKED	INDEX	MATERIAL
DESIGNER	4/11	28	6 OF 96
APPROVED	S.S.F.F.	ASST. D.W.G.	FRAG. DEC. APP.
SCALE	A-12082 AR 6 A		


237-6204 A-8
U.F.F. BLOC. BASMT. PLAN

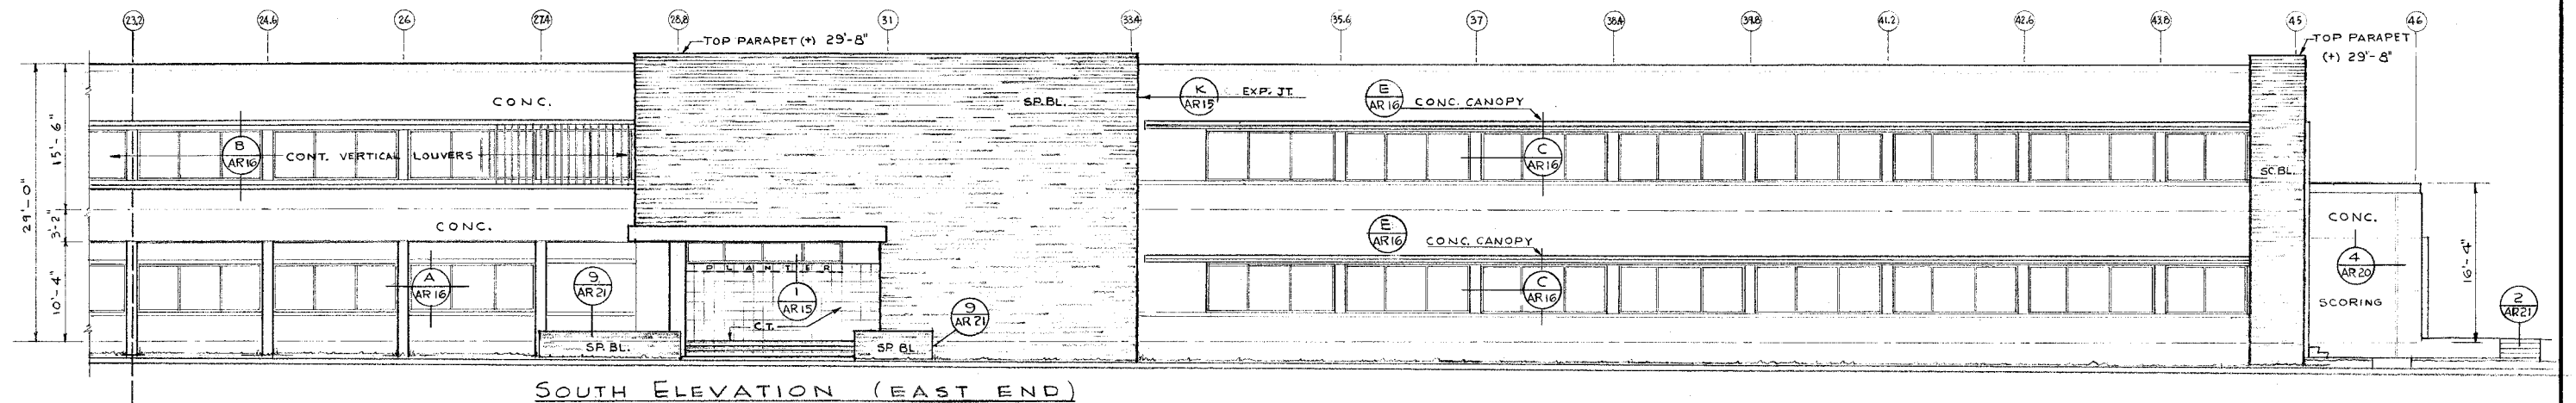


SOUTH ELEVATION (EAST END)
 $\frac{1}{8}'' = 1'-0''$

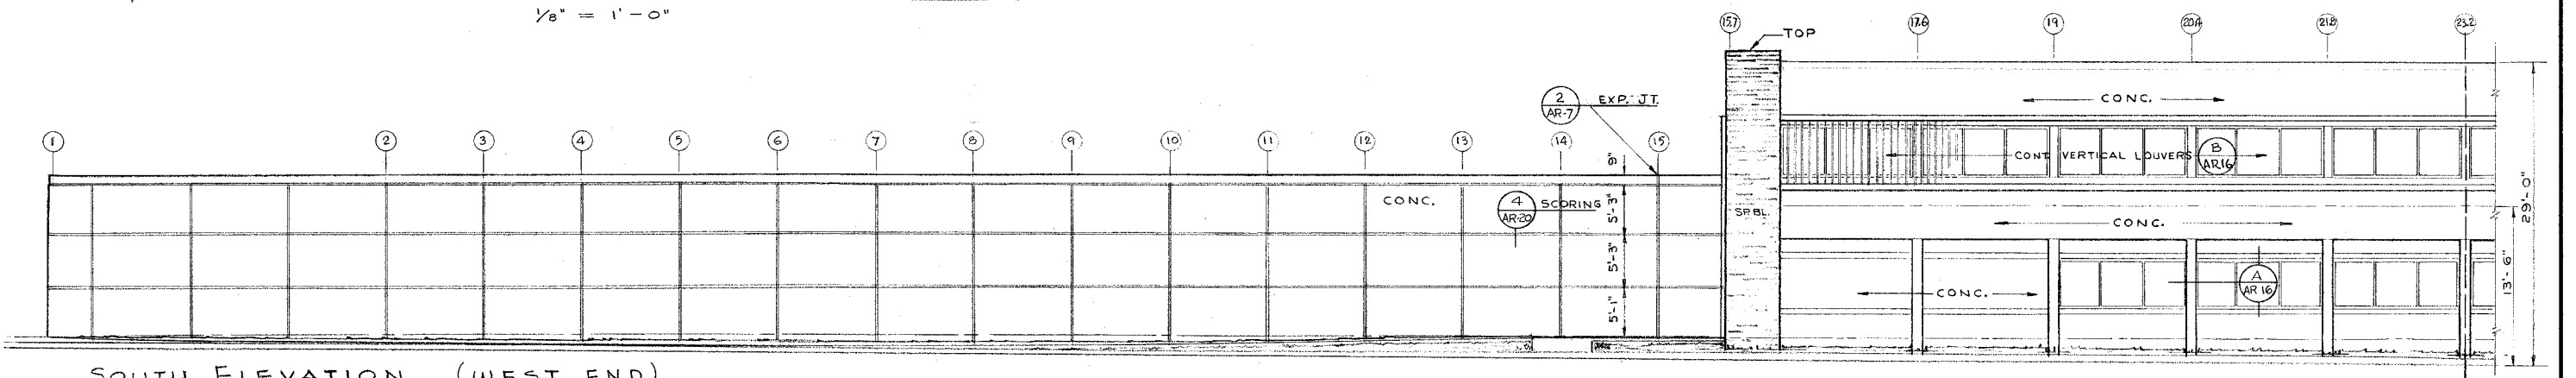


SOUTH ELEVATION (WEST END)
 $\frac{1}{8}'' = 1'-0''$

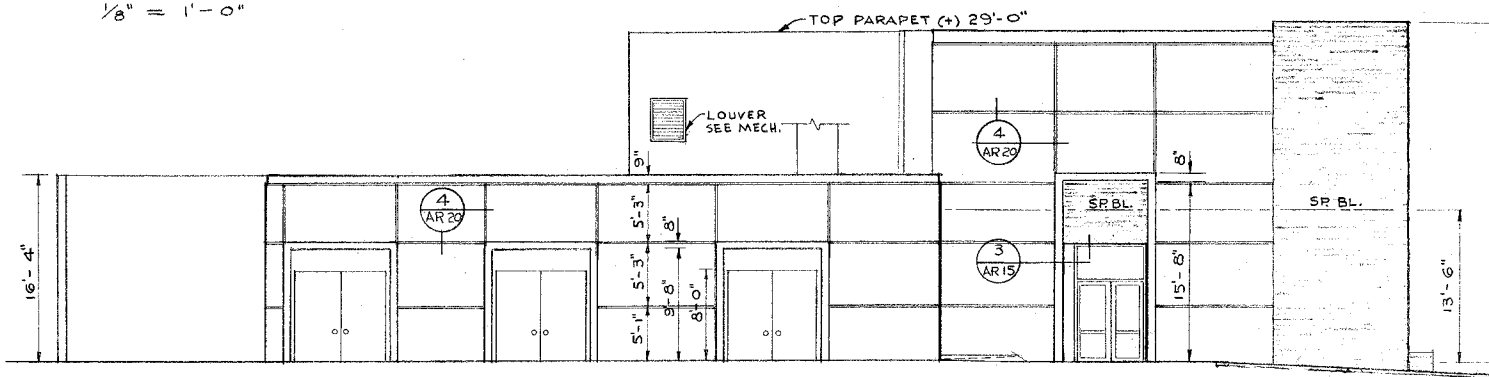

WEST ELEVATION
 $\frac{1}{8}'' = 1'-0''$

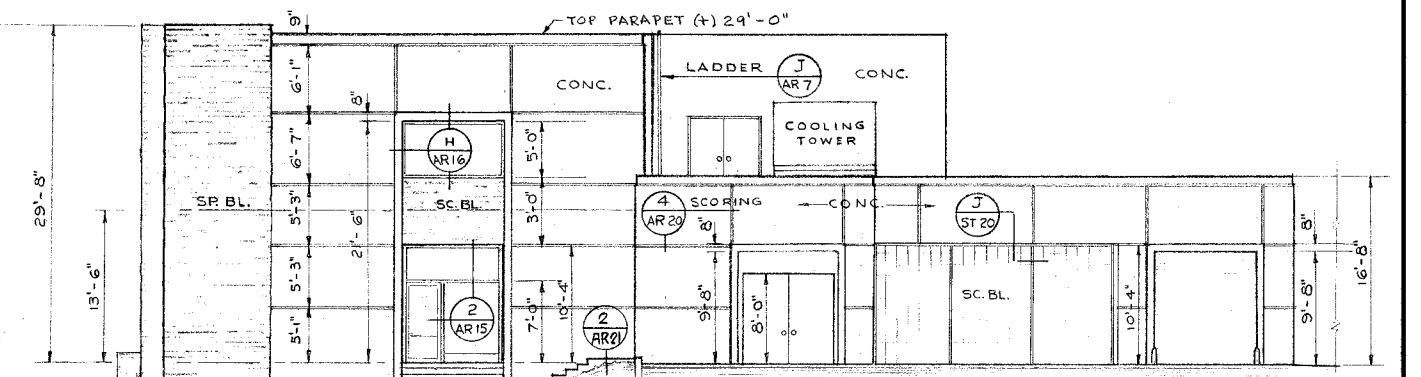

EAST ELEVATION
 $\frac{1}{8}'' = 1'-0''$

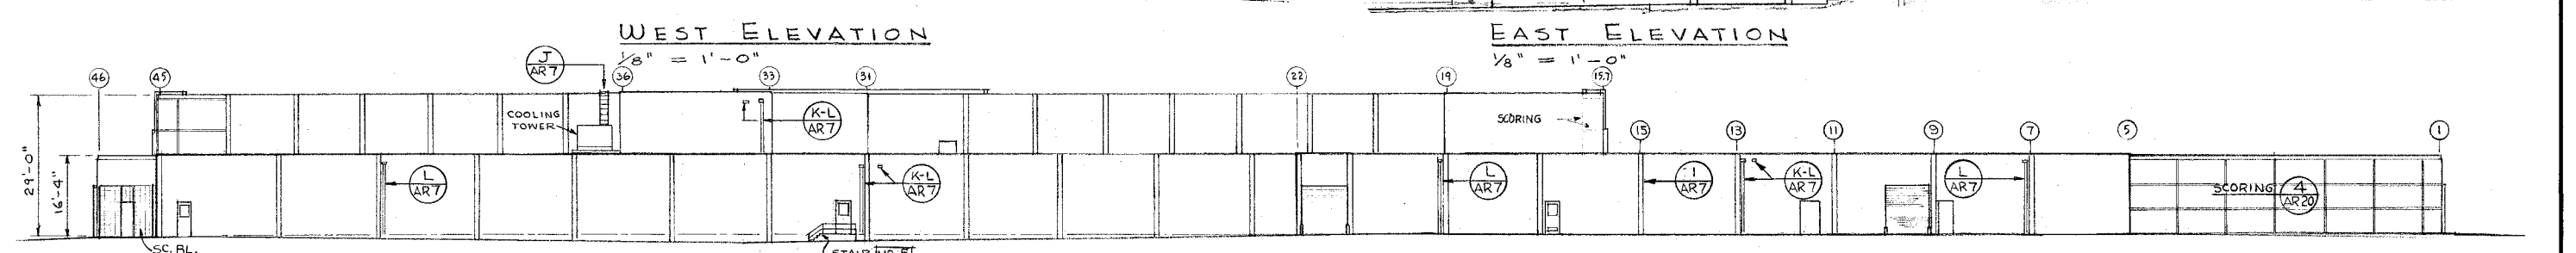


NORTH ELEVATION
 $\frac{1}{16}'' = 1'-0''$

ABBREVIATIONS

SP. BL. - "CALTILE" SPLIT BLOCK VENEER 4"x8"x16"
 SC. BL. - SCREEN BLOCK-"EMPRESS" PATTERN 12"x12"x4"
 C. T. - "CALTILE" CONC. TILE 12"x12"x1"
 EXP. JT. - EXPANSION JOINT

LETTER	DATE	REVISION DESCRIPTION	DRAWN	APP.
NATIONAL AERONAUTICS AND SPACE ADMINISTRATION AMES RESEARCH CENTER MOFFETT FIELD, CALIFORNIA				
HYPERVELOCITY FREE FLIGHT FACILITY BUILDING				
ELEVATIONS				
DRAWN A. H. M.	CHECKED R. M.	INDEX S.S.F.F.	MATERIAL 8 OF 96	LIMITS UNLESS NOTED
DESIGNED R. M.	APPROVED R. M.	SCALE 1/8" = 1'-0"	DATE 12-14-62	REV.
B. L. NISHKIAN CONSULTING ENGINEER 812 HOWARD STREET SAN FRANCISCO 3, CALIFORNIA 2873 12-14-62				A-12082 AR 8

237-6204 A-10
 H.F.F. BLDG. ELEVATIONS

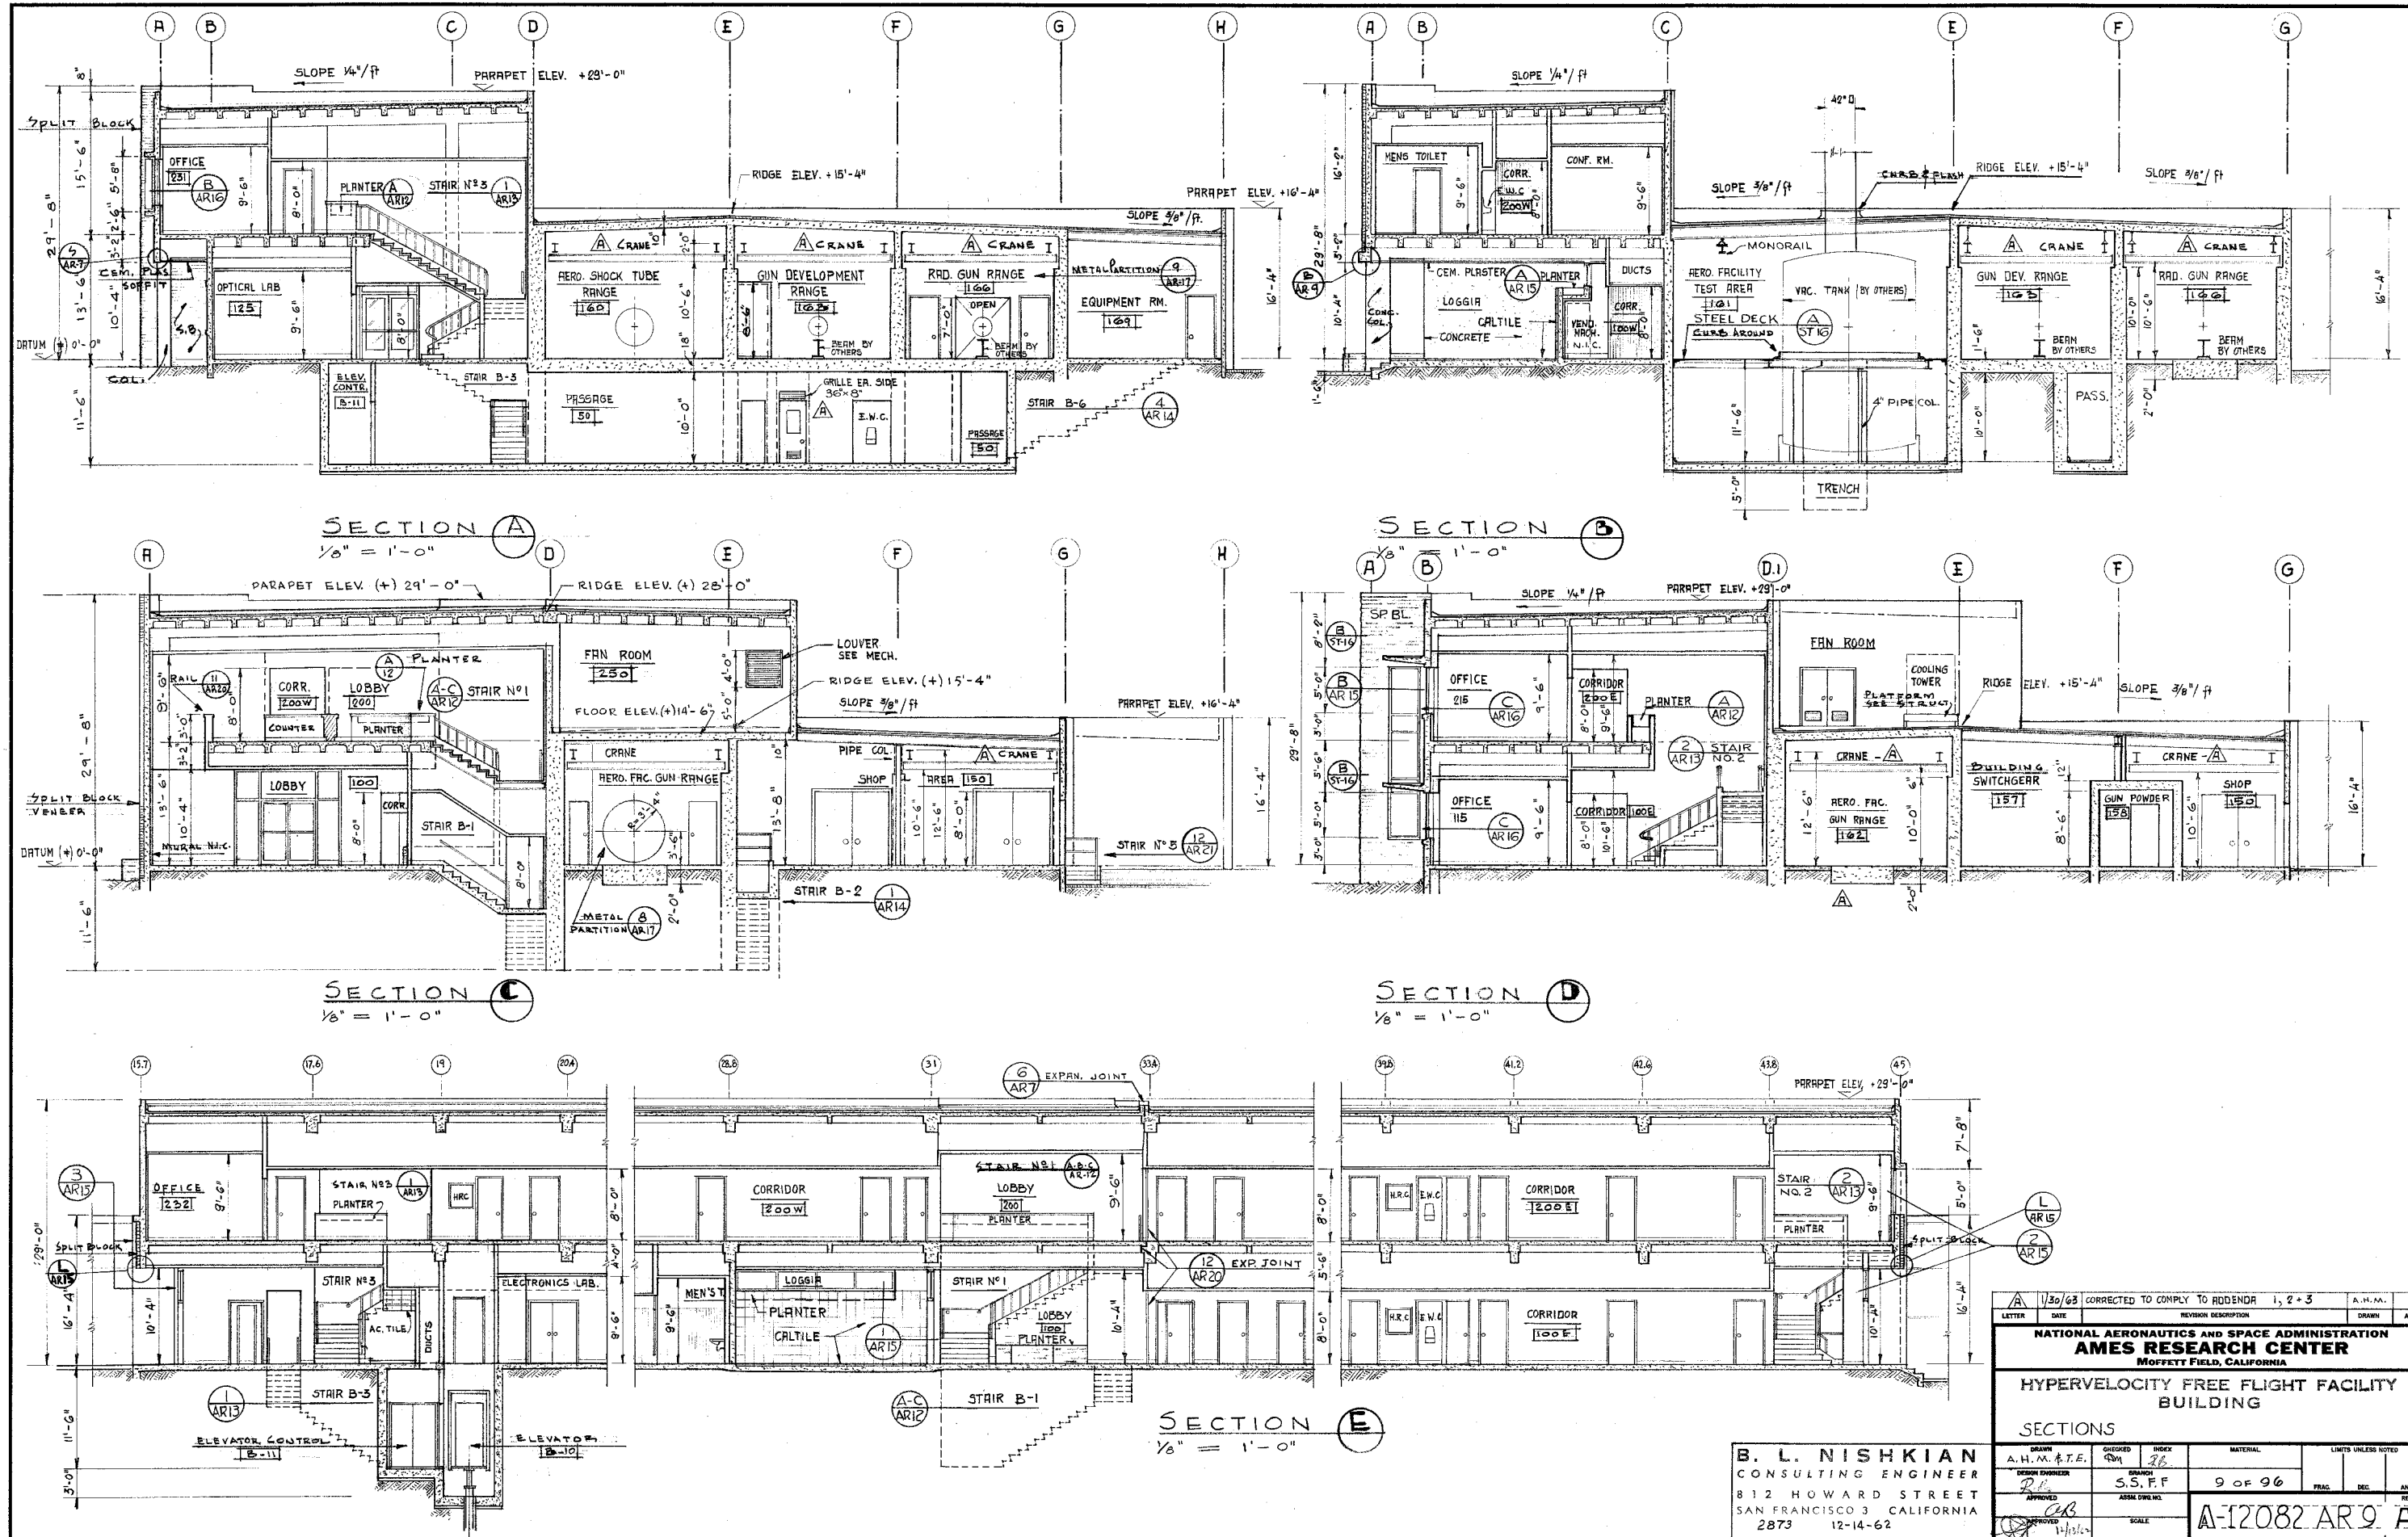


257-6204 A-11
H.F.F. BLOC. SECTIONS

Additional Images:

N-238: Arc Jet Laboratory



N-238, Aerial photograph, 1964
(Source: NASA Ames Research Center,
A-33038-22)

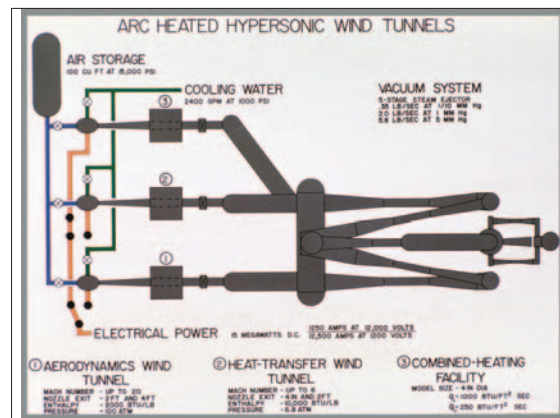

N-238, Cutaway Illustration of Arc-Heated
Hypersonic Wind Tunnel, 8 June 1964
(Source: NASA Ames Research
Center, A-32663-3)




N-238, 60-MGW Interaction Heating Facility,
10 May 1974
(Source: NASA Ames Research Center,
AC74-1979)



N-238, Reinforced Carbon-Carbon (RCC)
Johnson Space Center model testing in Ames
Interaction Heating Facility IHF-127
(Source: NASA Ames Research
Center, ACD02-0036-017)



N-238, north facade, main entrance
(Source: Page & Turnbull)

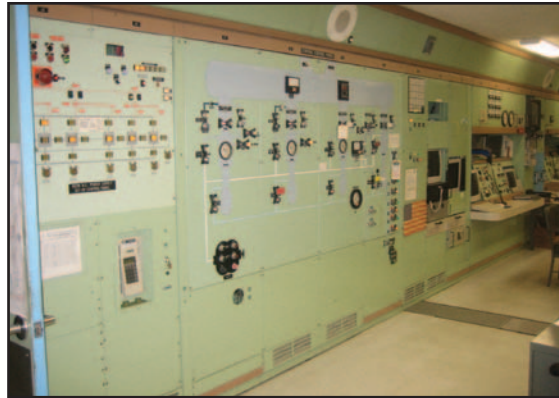

N-238, interior, control room
(Source: Page & Turnbull)



N-238, interior, high-bay and machine shop
(Source: Page & Turnbull)




N-238, 60MGW Interaction Heating Facility
(Source: Page & Turnbull)



N-238, interior, ceiling
(Source: Page & Turnbull)

Space Shuttle: 8 Years of Development and \$ 30 B

- Cool structure with external insulating TPS design approach which successfully minimized thermal structural effects

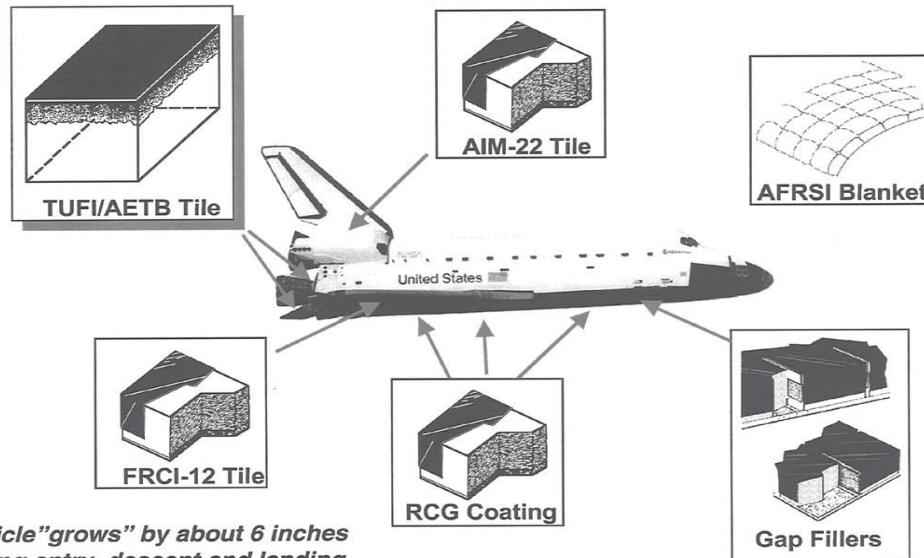

N-238, Diagram of 3.5-Foot Hypersonic Wind Tunnel
(Source: NASA Ames Facilities Summary, 1974)

Architectural Drawings for N-238

Building N-238 Arc Jet Facility, Architectural Perspectives

Architect: Robert E. Jones, Structural Engineer

Date: 14 January 1963

Sheet: A 238-6200A-1

NASA EDC # 238-6200-A1

Building N-238 Arc Jet Facility, Design Data

Architect: Robert E. Jones, Structural Engineer

Date: 14 January 1963

Sheet: A 238-6200A-3

NASA EDC # 238-6200-A3

Building N-238 Arc Jet Facility, Site Grading, Paving, and Landscaping Plan

Architect: Robert E. Jones, Structural Engineer

Date: 14 January 1963

Sheet: A 238-6200A-4

NASA EDC # 238-6200-A4

Building N-238 Arc Jet Facility, First Floor Plan

Architect: Robert E. Jones, Structural Engineer

Date: 14 January 1963

Sheet: A 238-6200A-5

NASA EDC # 238-6200-A5


Building N-238 Arc Jet Facility, Exterior Elevations

Architect: Robert E. Jones, Structural Engineer

Date: 14 January 1963

Sheet: A 238-6200A-7


NASA EDC # 238-6200-A7

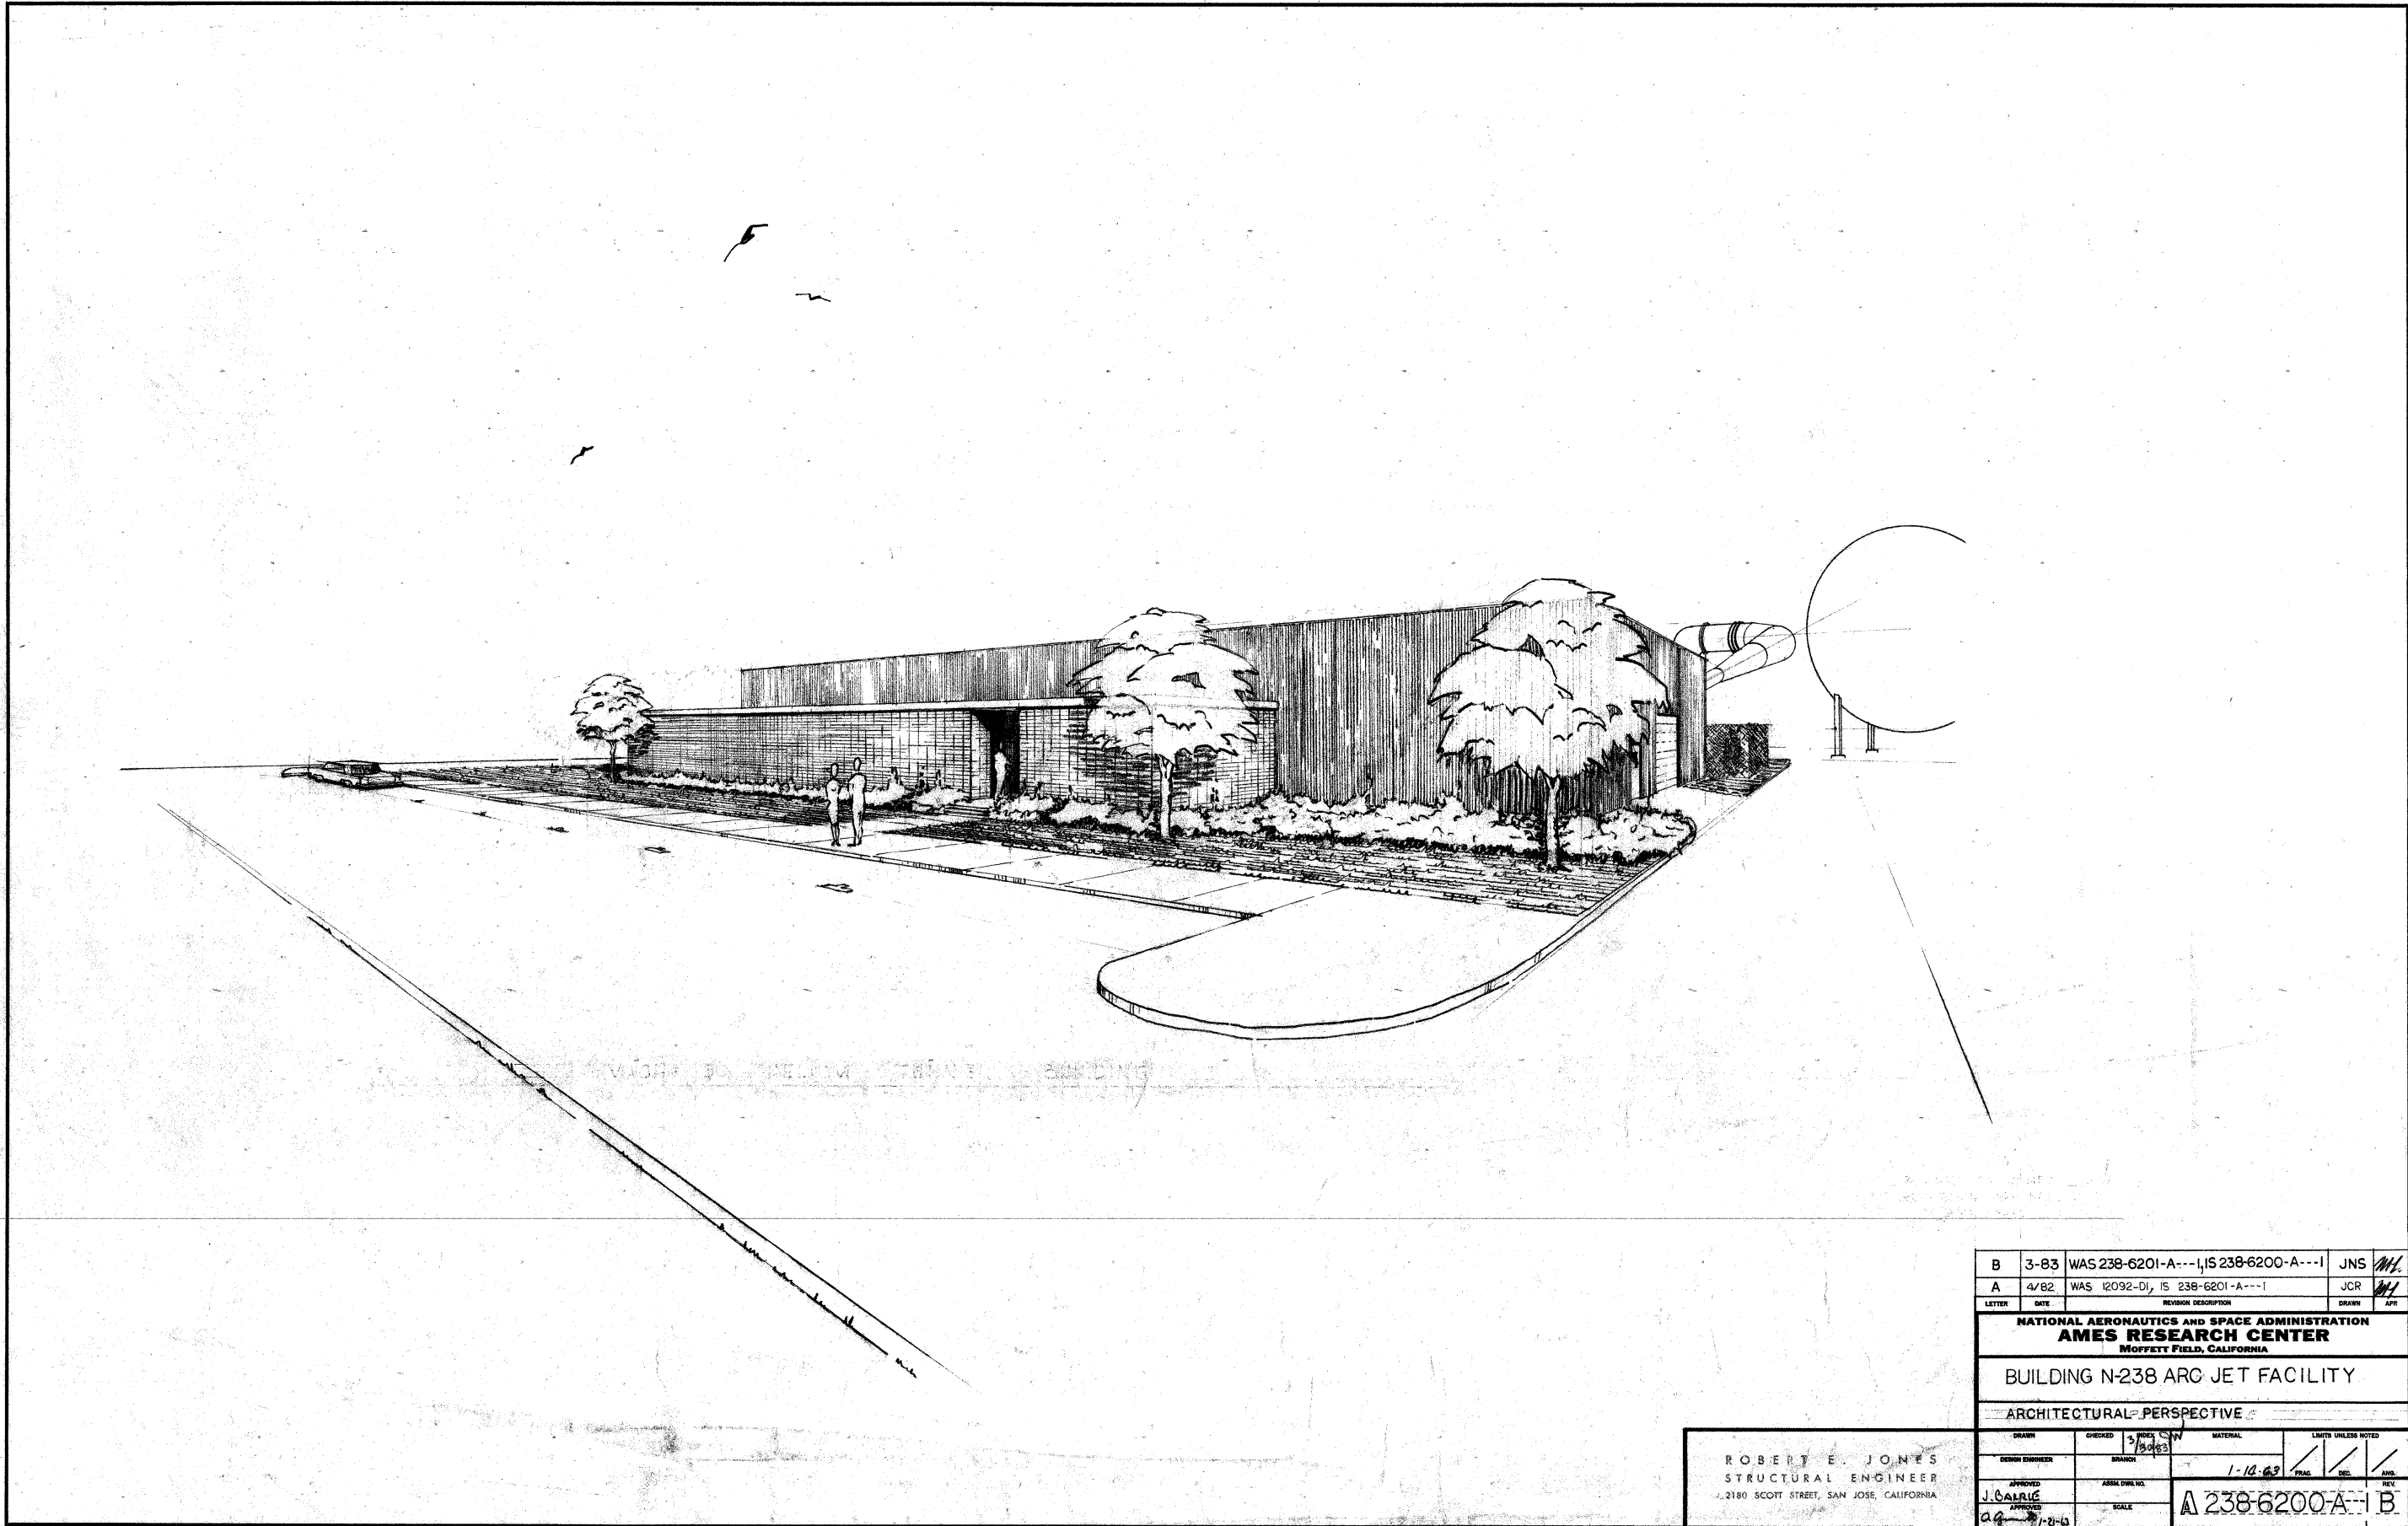


B	3-83	WAS 238-6201-A---1, IS 238-6200-A---1	JNS	ML		
A	4/82	WAS 12092-D1, IS 238-6201-A---1	JCR	ML		
LETTER	DATE	REVISION DESCRIPTION	DRAWN	APP		
NATIONAL AERONAUTICS AND SPACE ADMINISTRATION AMES RESEARCH CENTER MOFFETT FIELD, CALIFORNIA						
BUILDING N-238 ARC JET FACILITY						
ARCHITECTURAL PERSPECTIVE						
DRAWN	CHECKED	DATE	MATERIAL	LIMITS UNLESS NOTED		
DESIGN ENGINEER	BRANCH	1-10-63	1-10-63	PRAC	DEC	APP
J. CALAIS	ASST. CIVIL ENGR.	SCALE	A 238-6200-A---1 B			
APPROVED	APPROVED	DATE				
ag	1-10-63					

A


B

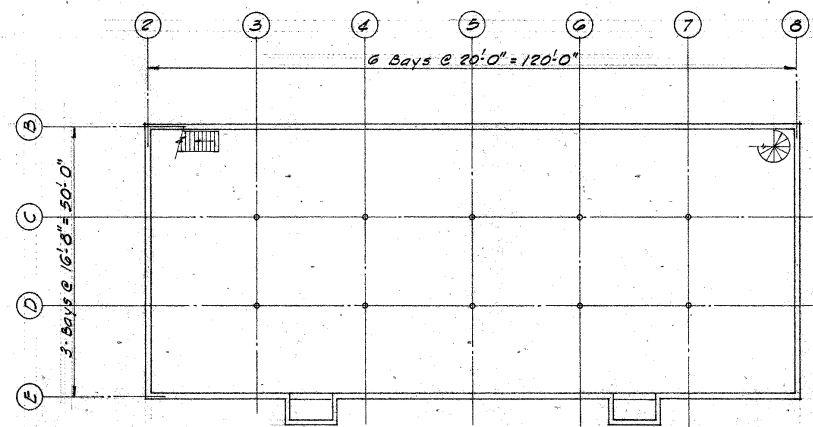


BASEMENT FLOOR PLAN 1/8"=1'-0"

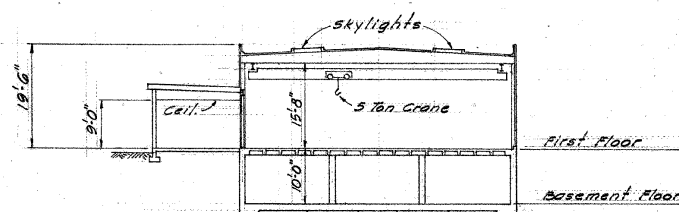

CROSS SECTION A

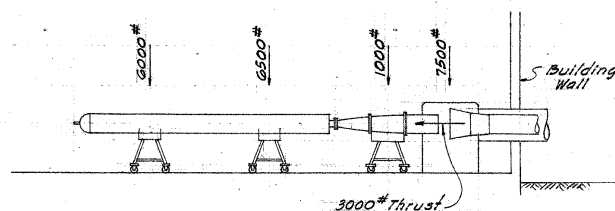

LOAD DIAGRAM
 CO₂ TUNNEL

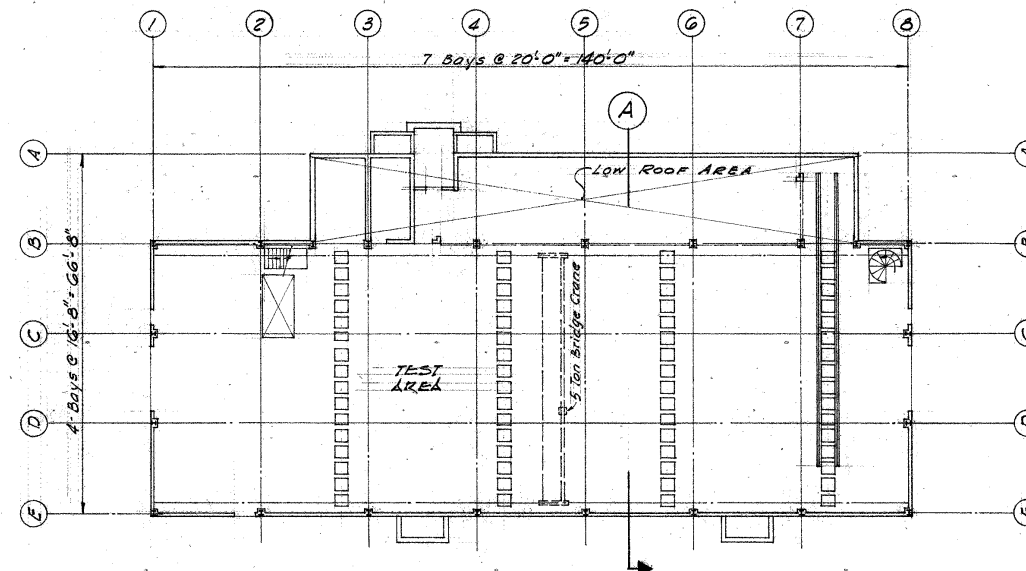

FIRST FLOOR PLAN 1/8"=1'-0"

GENERAL DESCRIPTION

1. FOUNDATIONS

- Reinforced concrete continuous exterior footings and interior spread footings under columns.

2. FLOOR FRAMING

- Reinforced concrete slabs on grade.
- Reinforced concrete waffle slab (8" x 3") over basement area.
- Basement slab 12" thick to allow for concentrated tunnel and other loads.

3. WALL CONSTRUCTION

- 12" reinforced concrete basement walls.
- 8" reinforced concrete blocks around Low Roof Area (Control room, toilets, entrance, etc.).
- 18 ga. metal siding around High Roof Area (Test area), steel girts, angles, etc.

4. ROOF FRAMING

- Tapered steel beams, steel purlins, WF columns, 20 ga. steel decking.

5. INSULATION

- 12" rigid roof insulation over steel decking.
- 1" pre-finished insulation board inside of metal siding.

6. ROOFING

- Three ply built up with mineral surface cap sheet.

7. WATERPROOFING

- Membrane under slabs on grade.
- External waterproofing on basement walls.

8. CEILINGS

- Exposed steel decking in Test Area.
- Acoustic tile in Control Room.
- Gypsum plaster in Toilet Room.
- Cement plaster Entry.

9. FLOORING

- Concrete in Basement and Test Area.
- Vinyl asbestos tile in Control Room, Toilets and Entry.

10. DOORS

- Electric operated steel roll-up.
- Hollow metal personnel doors.

II. CRANE

- 5-ton double girder, low headroom, traveling bridge crane.

III. PAVING

- Yard Area: 1 1/2" A.C. over 4" base
- Roadways: 3" A.C. over 6" base

DESIGN CRITERIA

- GENERAL - Uniform Building Code, 1961 Edition.

- FOUNDATIONS - Dames & Moore Report re/ Addition to Flight Research Hanger.

- CONCRETE - A.C.I. 318-56

- STEEL - A.I.S.C. Code

- CRANE - 15% vertical impact, 20% lateral & 10% longitudinal forces.

STRESSES

- SOIL BEARING: 1500 psf D.L.
2000 psf D+LL + Seismic

- CONCRETE & REINFORCING: $f'_c = 3000$ psi, $f'_s = 1350$ psi, $n = 10$
 $f_s = 20000$ psi (A-15 steel)

- STRUCTURAL STEEL: Per A.I.S.C. for A-7 steel.

- MASONRY: Mortar and grout $f'_m = 2000$ psi; grade 'A' units: $f'_m = 1800$ psi.

DESIGN LOADS

- CO₂ TUNNEL - See sketch above.

- ROOF - 20 psf live load

FLOORS

- Test Area - 185 psf L.L.
- Offices - 100 psf L.L.

LATERAL

- Wind: 30 psf
- Seismic: 20% gravity

- FLUID PRESSURE - Basement walls
Saturated earth - 75 psf.

ELECTRICAL DESIGN CRITERIA

1. POWER REQUIREMENTS

- Building Power:
 - 6000 volt 3 ϕ 60 cycle Primary Supply.
 - 480Y/277 volt 3 ϕ 4W. Motors, Lighting, Welders
 - 208Y/120 volt 3 ϕ 4W. Motors, Lighting, Outlets
 - Instrumentation Power:
 - 120/60 volt 1 ϕ 3W Instrumentation Outlets

2. TRANSFORMERS

- 500 KVA 6000-480Y/277 volt Building Power
- 45 KVA 480-208Y/120 volt Day Panel B
- 45 KVA 480-208Y/120 volt Day Panel C
- 30 KVA 480-208Y/120 volt Night Panel N(1)
- 10 KVA 480-120/60 volt Special Instrumentation

3. DAY PANELS

- Upper section of Main Distribution Panel Feeds Welders and other Day Panels.
- Panel 'A' - Feeds 277 volt "Day" Lighting
- Panel 'B' - Feeds 120 volt "Day" Lighting, Receptacles and small Power Outlets
- Panel 'C' - Same as Panel 'B'.
- Panel 'D' - Feeds Instrumentation Outlets

4. NIGHT PANELS

- Lower Section of Main Distribution Panel Feeds Night Lighting and Heating & Ventilating equip. on 480/277 volts.
- Panel N(1) Feeds Night Lighting, Signal Systems & Small Motors for Heating, Ventilating & Plumbing equip. on 120/208 volts.

5. ILLUMINATION

- Control Room, Test Area & Toilet Room lighting to be 277 volt Fluorescent Fixtures.
Control Room 75 F.C. minimum
Test Area 50 F.C. minimum
- Basement Street Lighting & Security Lighting to be 120 volt Incandescent Fixtures.

6. COMMUNICATION SYSTEMS

- Telephone system outlets & 25 pairs of cable to building.
- General Code Call Bells and Relays.
- Door Call Button and Bells.
- Fire Alarm Auxiliary Station.

7. GROUNDING

- Equipment and System Ground Loop.
- Instrumentation System Ground Loop.

8. DUCT BANK AND MANHOLES

- As required to extend existing underground facilities to new building.

HEATING, VENTILATING AND AIR CONDITIONING


- Cast iron sectional boiler for hot water service to space heating requirements.
- Direct expansion, air cooled, roof mounted air conditioning for cooling Control Room.
- Hot water horizontal and projection type unit heaters for Test Area.
- Roof exhaust fans to provide general ventilation. Basement.
- Temperature control system energized thru time clock.
- Galv. sheet metal ducts with internal insulation on supply and returns.
- Air is supplied at approximately 25 air changes per hour to control room.

PLUMBING



- Toilet facilities for 15 men.
- Electric water cooler.
- Roof & area drainage. Lawn sprinkler system.
- Sump & pump for Basement floor drains. Floor drains in Test area.

B	3-83	WAS 238-6200-A-3	IS 238-6200-A-3	JNS	WJS
A	4/82	WAS 12092-DO	IS 238-6200-A-3	JCR	WJS
LETTER	DATE	REVISION DESCRIPTION	DRAWN	APP	
NATIONAL AERONAUTICS AND SPACE ADMINISTRATION					
AMES RESEARCH CENTER					
MOFFETT FIELD, CALIFORNIA					
BUILDING N238 ARC JET FACILITY					
DESIGN DATA					
DRAWN	CHECKED	DESIGNED	MATERIAL	LIMITS UNLESS NOTED	
HJB	WJS	WJS			
DESIGN ENGINEER	BRANCH	SCALE	1:14-63	PRAC	DEL
APPROVED	ASSN. ENGR.	SCALE	A 238-6200-A-3 B	REV	
J. B. Jones 1-23-63					
DATE	1-21-63				

ROBERT E. JONES
 STRUCTURAL ENGINEER
 2180 SCOTT STREET, SAN JOSE, CALIFORNIA

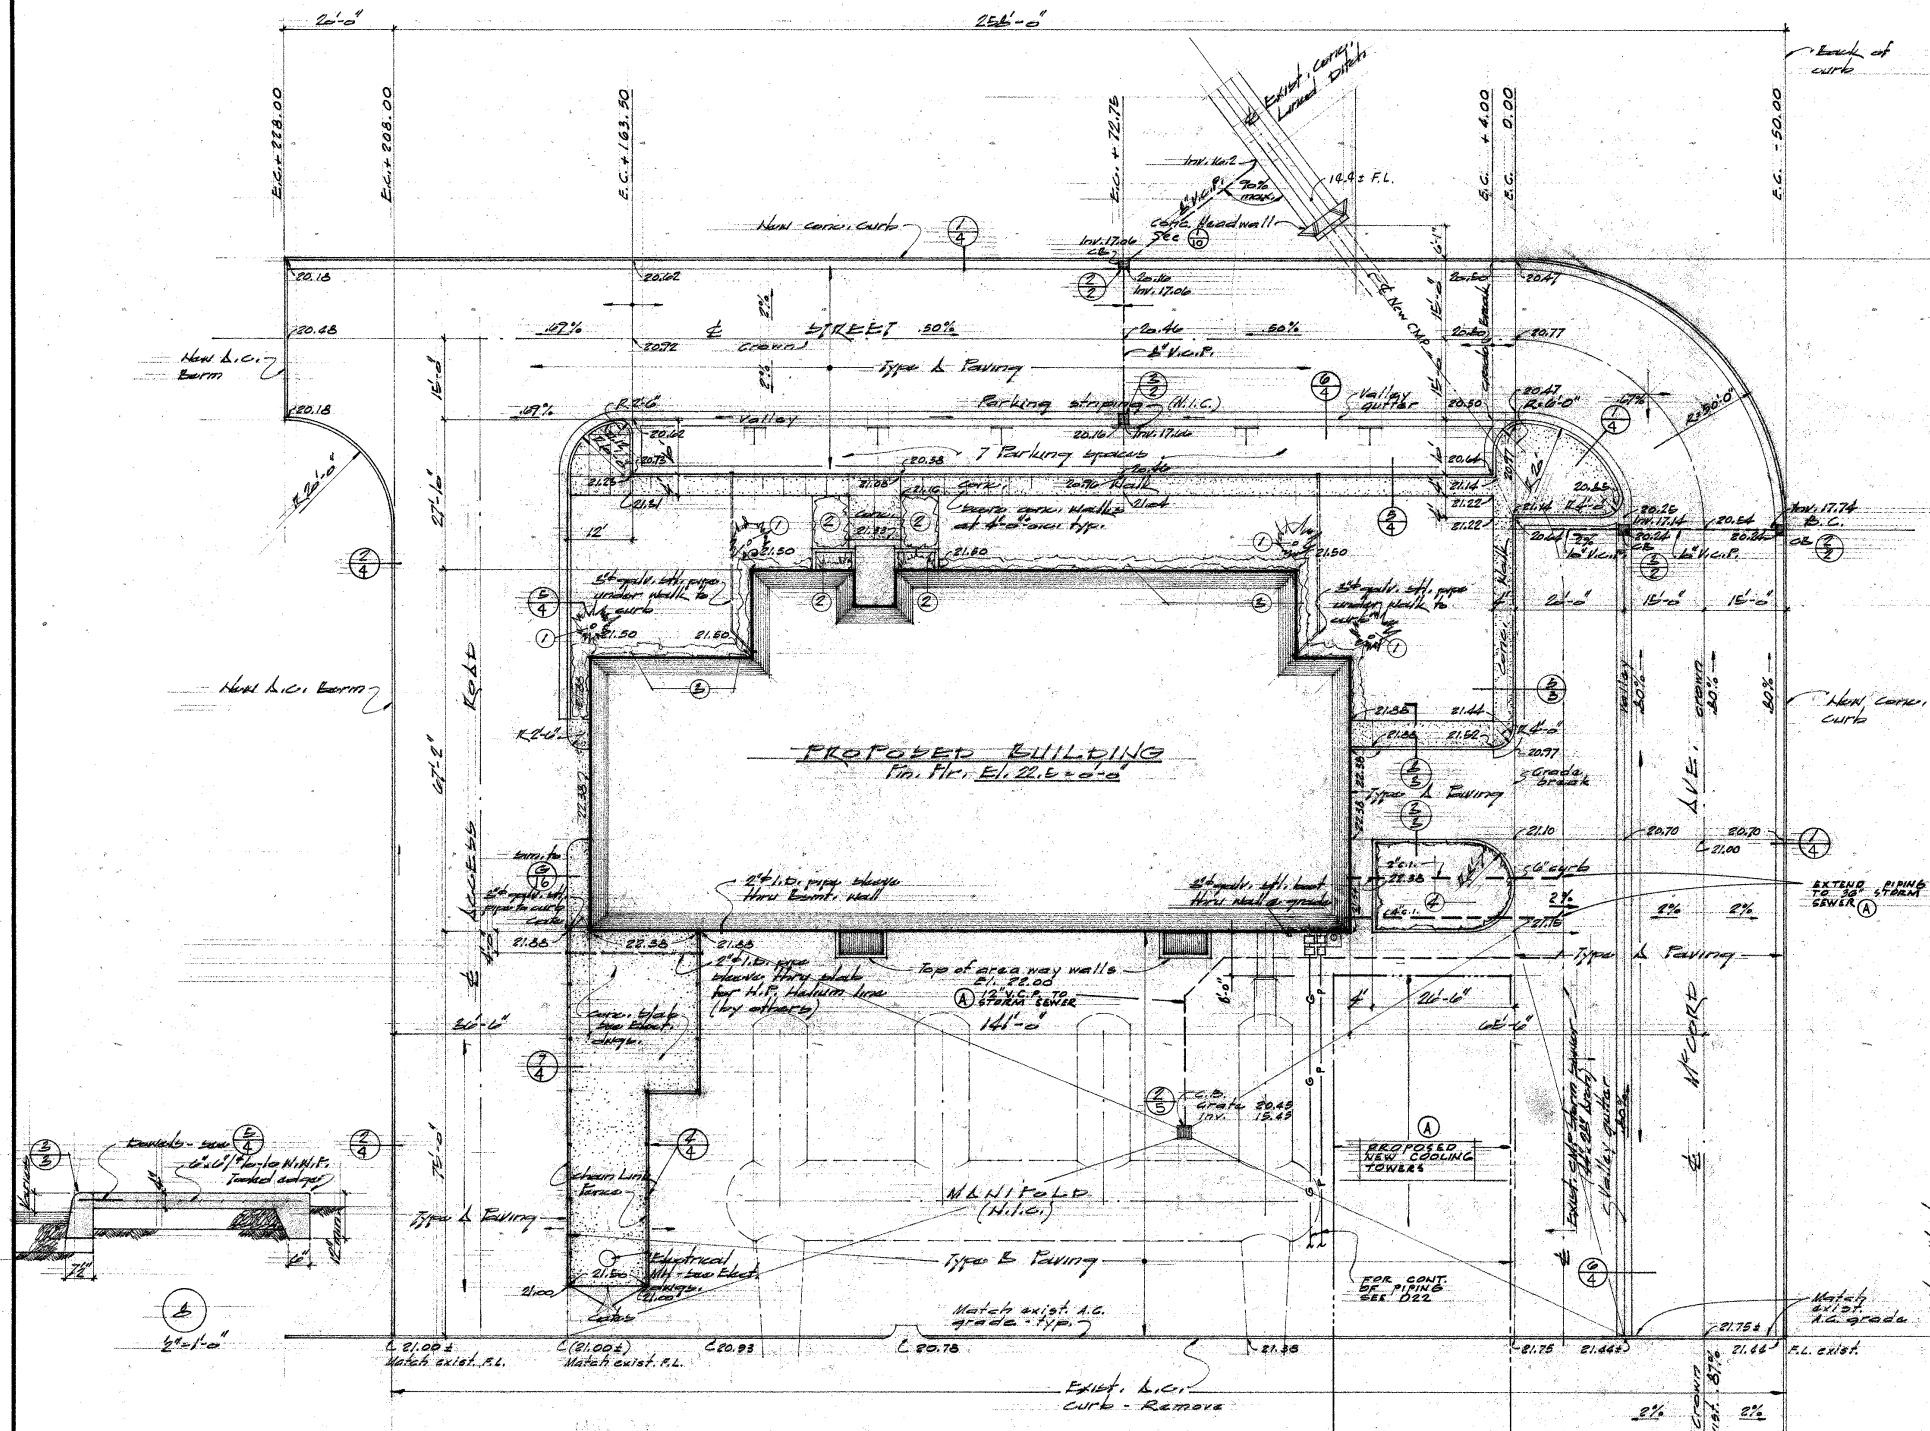



SITE GRADING - PAVING & LANDSCAPING PLAN
 1/2" = 1'-0"
 All grades indicated on this plan are to finish.

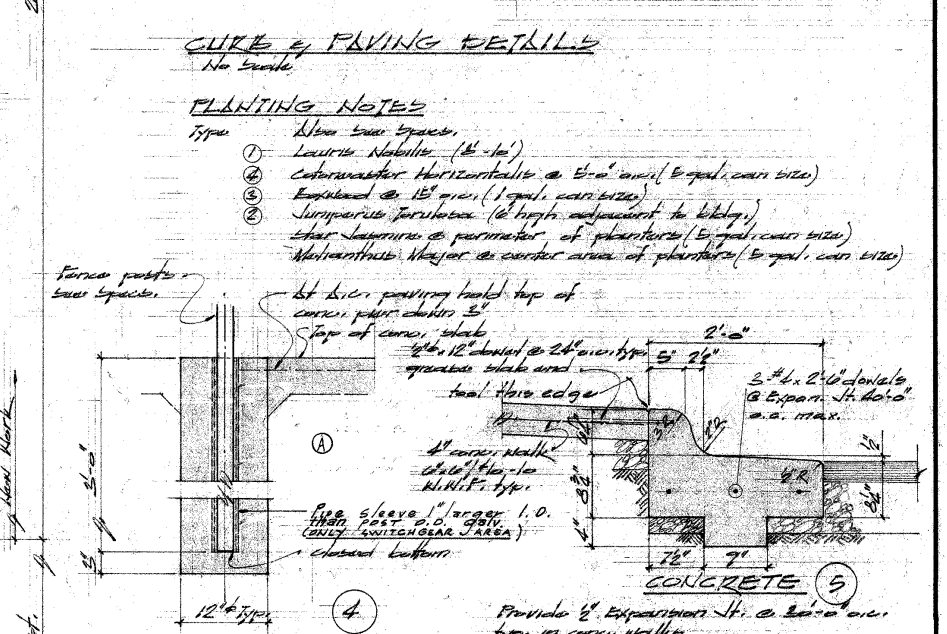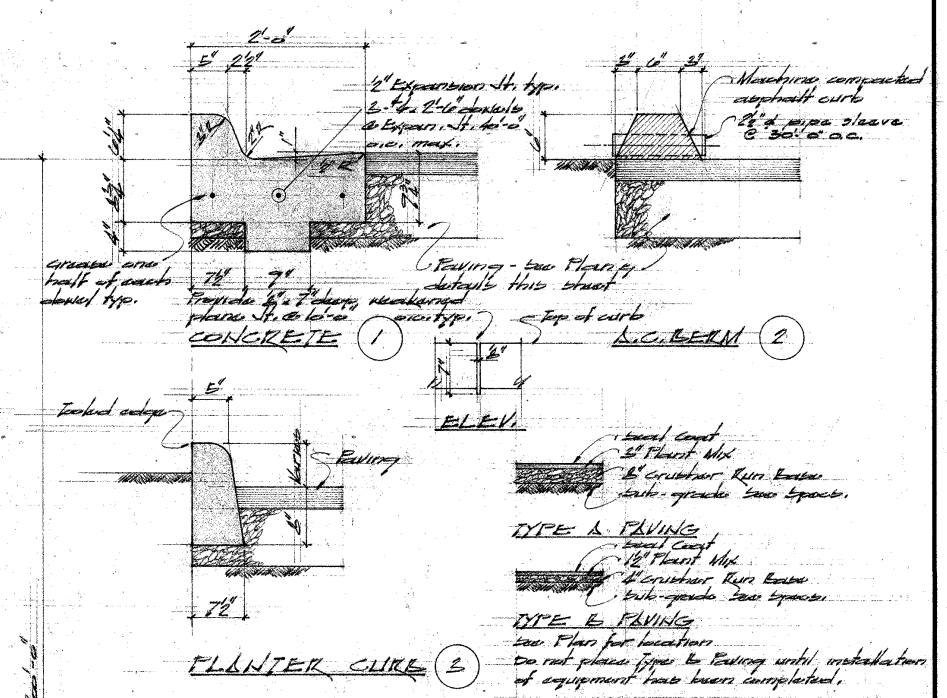

C 3-B3 WAS 238-6200-A-4 JNS		JNS	
B 4/82	WAS 12092-D3 IS 238-6201-A-3	JCR	JCR
A 7-8-83	ONE REVISED TO DATE	B. 06	06
LETTER	DATE	REVISION DESCRIPTION	DRAWN
NATIONAL AERONAUTICS AND SPACE ADMINISTRATION AMES RESEARCH CENTER MOFFETT FIELD, CALIFORNIA			
BUILDING N-238 ARC JET FACILITY			
SITE GRADING - PAVING - AND LANDSCAPING PLAN			
DESIGN ENGINEER	CHECKED	DATE	LIMITS UNLESS NOTED
ROBERT E. JONES	JNS	7/30/83	1-16-83
APPROVED	ASST. ENGINEER	SCALE	REV
J. BAR. FILE	ASST. ENGINEER	1/2" = 1'-0"	A 238-6200-A-4C

238-6200-A-4
 8006-N-238 SITE GRADING - PAVING - AND LANDSCAPING PLAN

23-B-6200-A-5
0106. N338 FIRST FLOOR PLAN

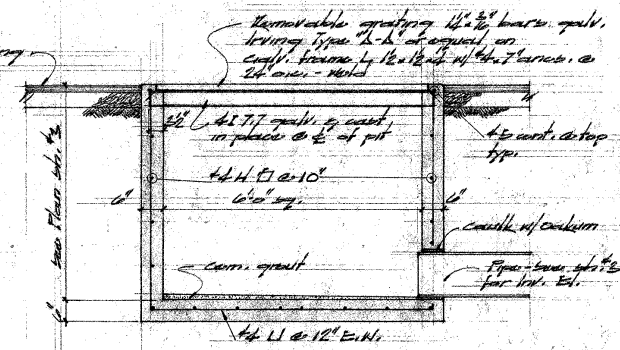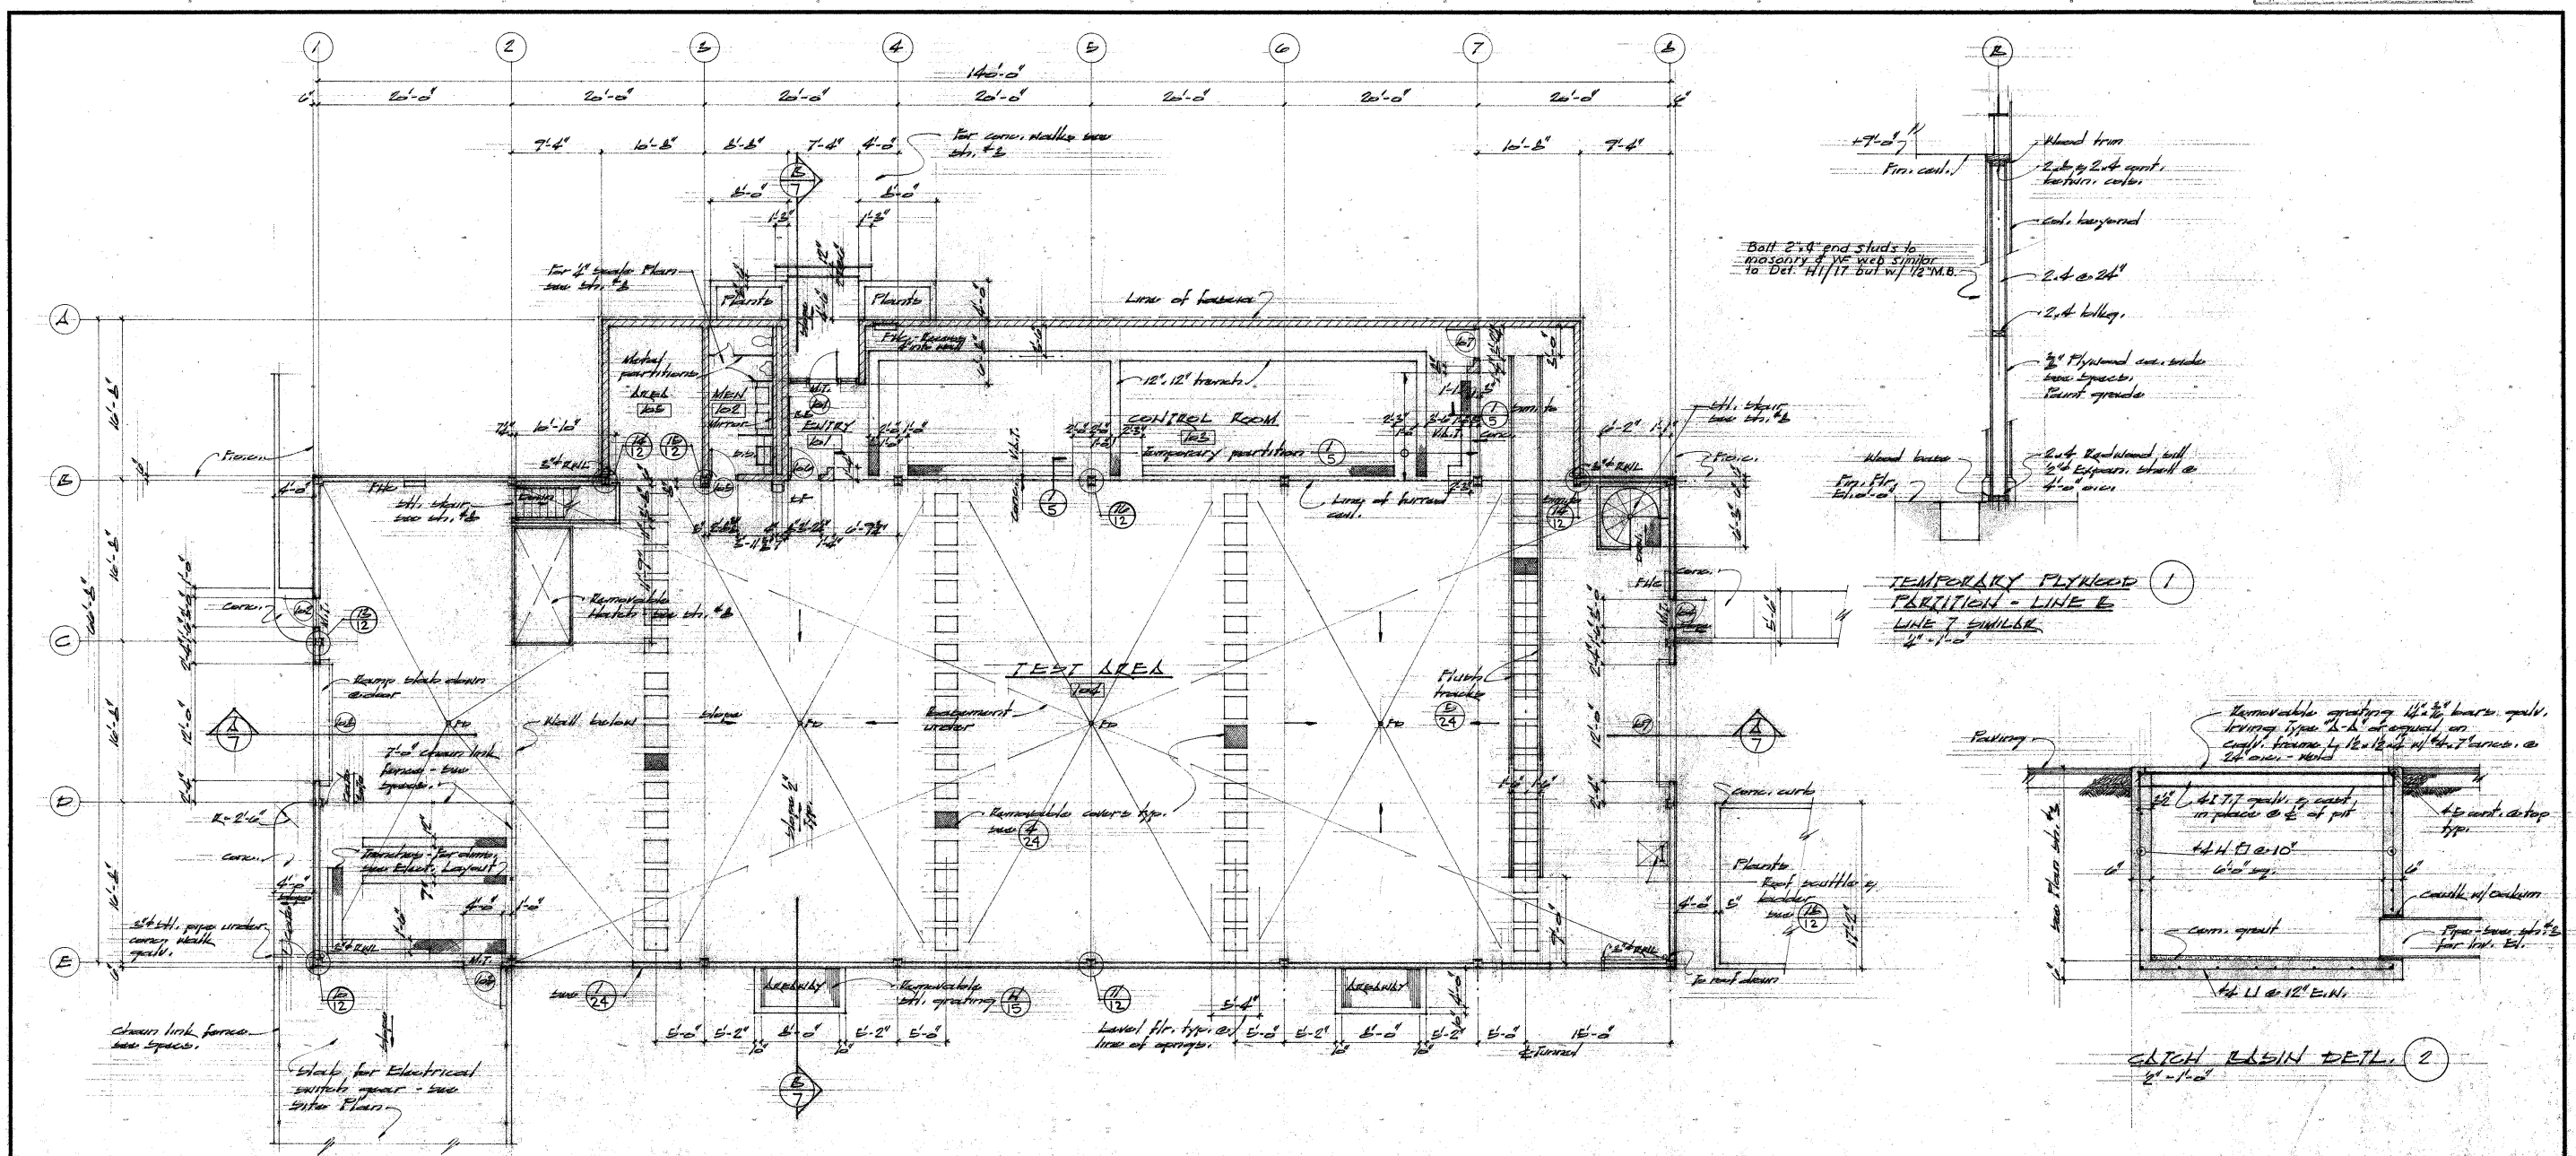

FIRST FLOOR PLAN
1/8" = 1'-0"


LEGEND

- RHL Room Heater Location
 - MT Metal Threshold
 - PC Face of Concrete
 - PF Drinking Fountain
 - HE House Entry
 - VST Vinyl Substrate Tile
 - LS Service Sink
 - FD Floor Drain
 - ES Roof Eave
 - FHC Fire Hose Cabinet
 - TD Taped, Tapeless
 - MT Manifold
 - EB Exhaust Exhaust
 - NHT Mechanical Room Exhaust
- (X) Detail Sheet number
 - Concrete in section
 - Concrete block in section
 - Wood continuous
 - Wood blocking
 - Footing step

3-B3	WAS 238-6200-A-4, IS 238-6200-A-5	JNS	ML
A	4/82	WAS 12092-D4	IS 238-6200-A-4
LETTER	DATE	REVISION DESCRIPTION	DRAWN
NATIONAL AERONAUTICS AND SPACE ADMINISTRATION AMES RESEARCH CENTER MOFFETT FIELD, CALIFORNIA			
BUILDING N-238 ARC JET FACILITY			
FIRST FLOOR PLAN			
DESIGN	CHECKED	DATE	MATERIAL
J.M.	J.M.	7/30/83	1-18-83
DESIGN ENGINEER	BRANCH	SCALE	LIMITS UNLESS NOTED
J. BARRIE	ARCHITECT	SCALE	1/8" = 1'-0"
APPROVED	DATE	A238-6200-A-5 B	
AG	7-21-83		


ROBERT E. JONES
STRUCTURAL ENGINEER
2180 SCOTT STREET, SAN JOSE, CALIFORNIA

238-6200-A-7
 0105. MASS EXTERIOR ELEVATIONS

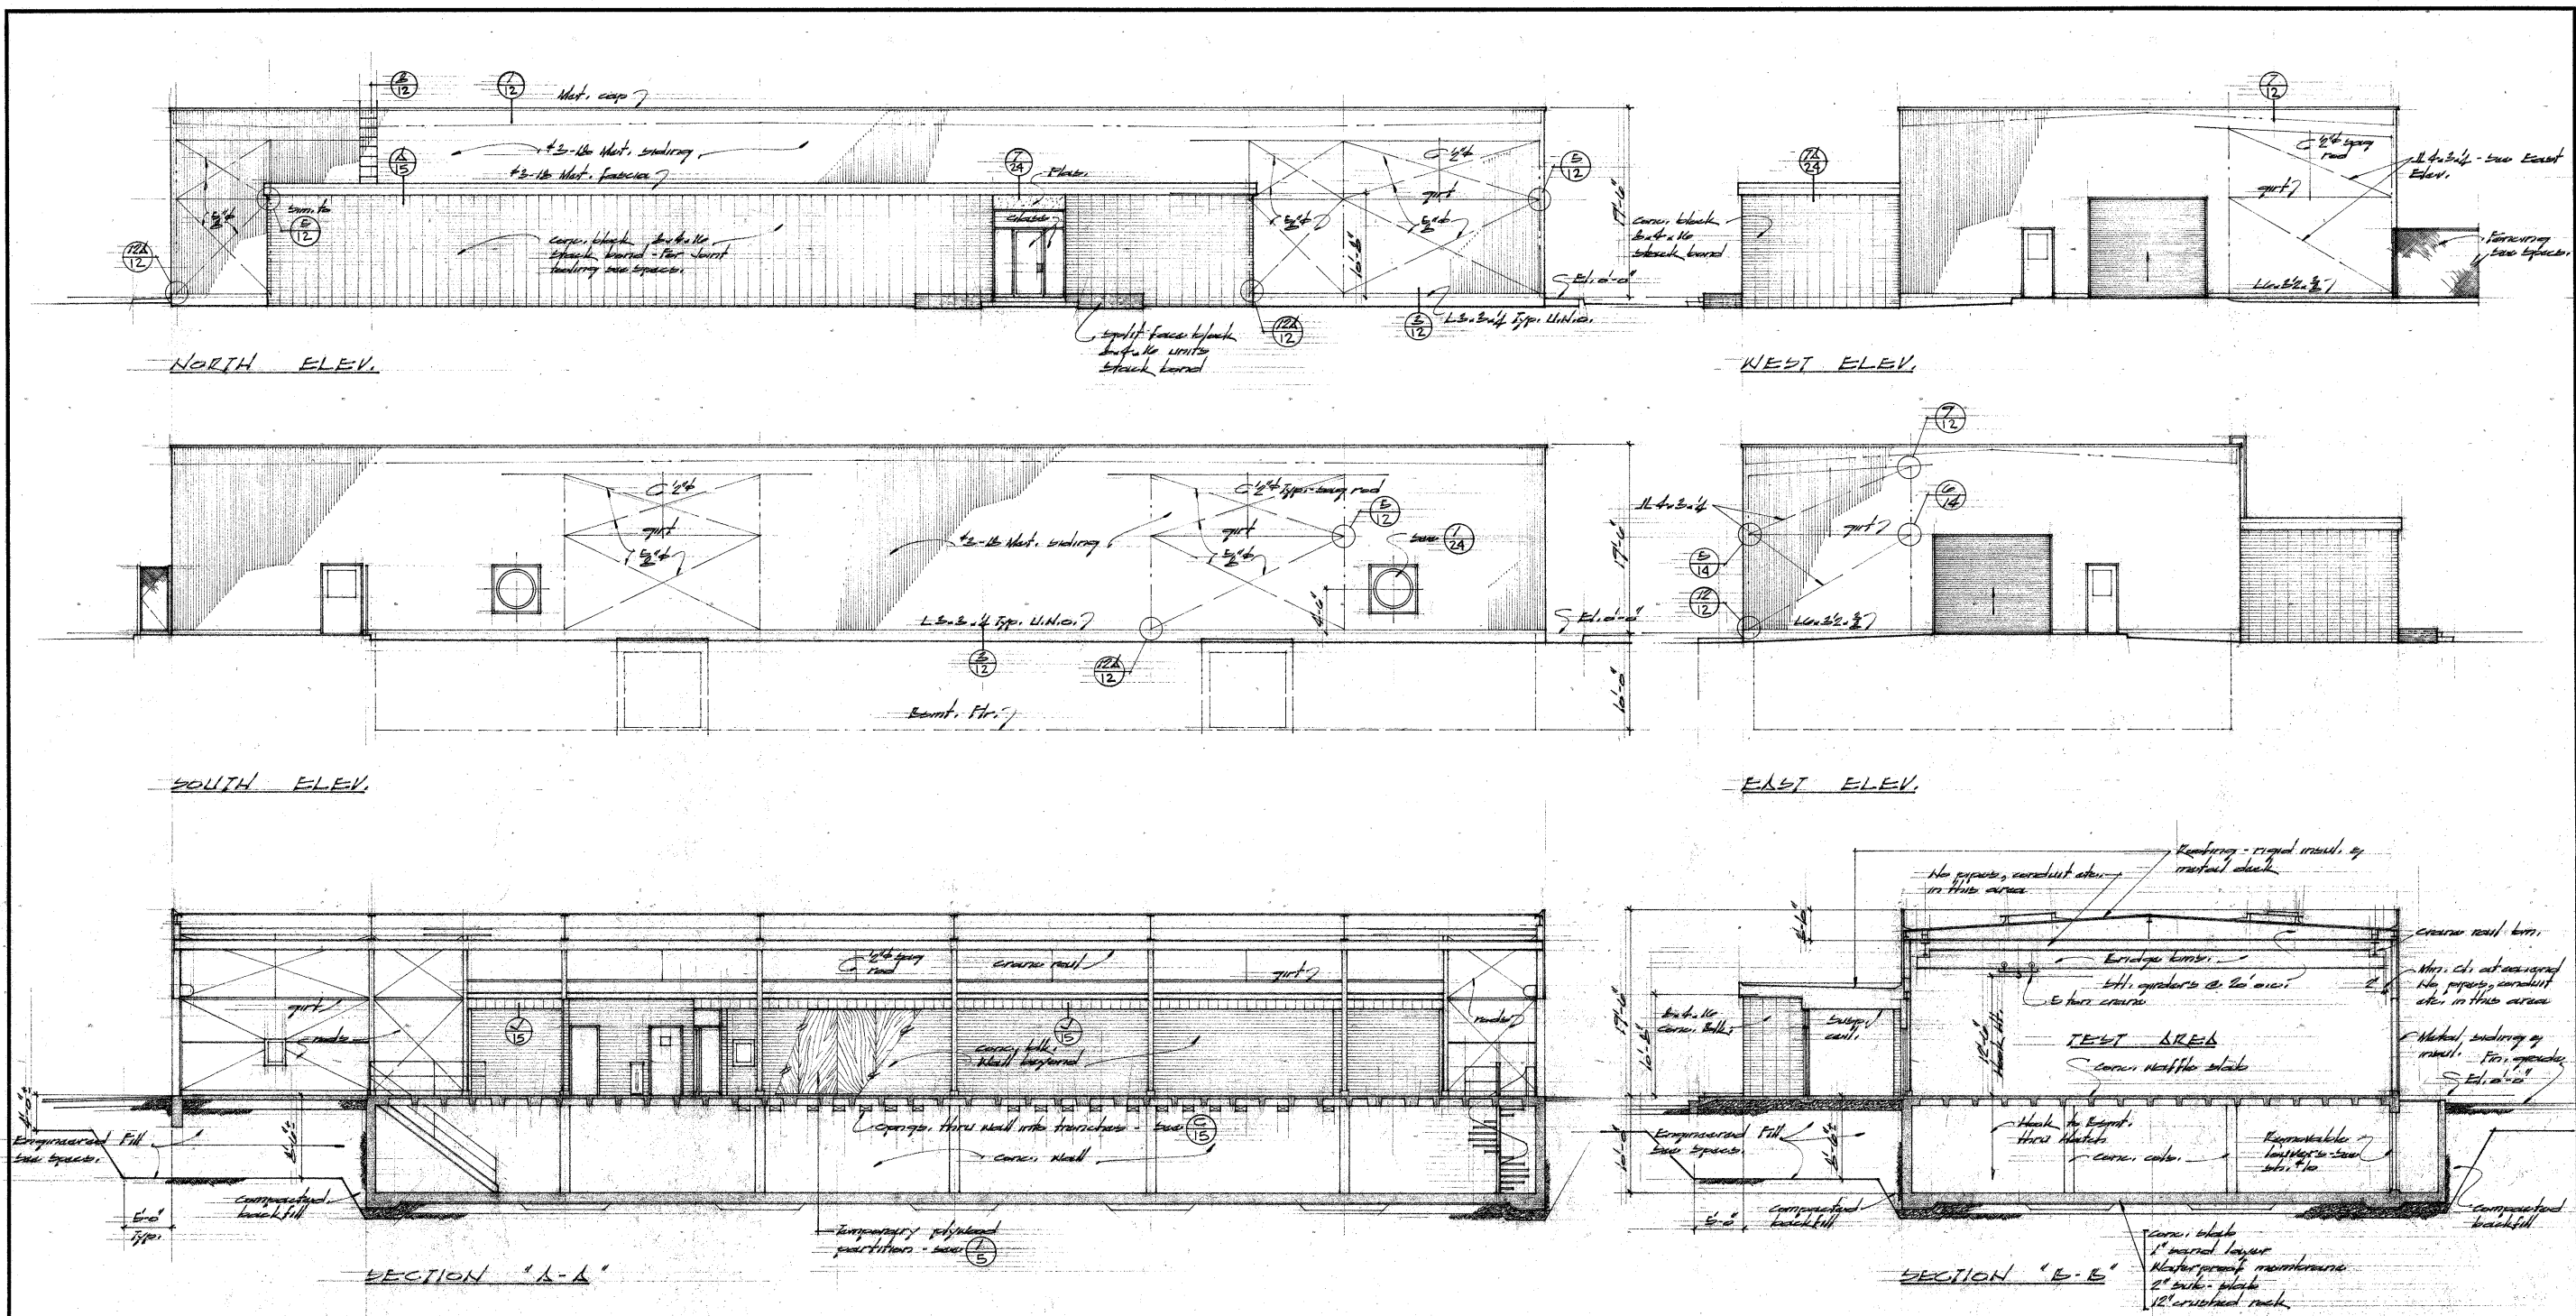

3-83	WAS 238-6201-A-6	15 238-6201-A-6	JNS	ML
A	4/82	WAS 12092.06	JCR	ML
LETTER	DATE	REVISION DESCRIPTION	DRAWN	APP
NATIONAL AERONAUTICS AND SPACE ADMINISTRATION				
AMES RESEARCH CENTER				
MOFFETT FIELD, CALIFORNIA				
BUILDING N-238 ARC JET FACILITY				
EXTERIOR ELEVATIONS				
DRAWN	CHECKED	INDEX	MATERIAL	LIMITS UNLESS NOTED
JM	3/30/83			
DESIGN ENGINEER	BRANCH		1-14-GS	TRAC
APPROVED	ASSIGNED			
J. BARUC				
APPROVED	SCALE			
1-21-83	3/8" = 1'-0"			

ROBERT E. JONES
 STRUCTURAL ENGINEER
 2180 SCOTT STREET, SAN JOSE, CALIFORNIA

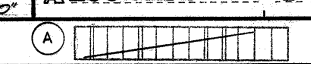

Additional Images:

N-240: Airborne Missions and Applied Life Sciences Experiments

N-240A: Life Sciences Flight Experiments



N-240 and N-240A, Aerial photograph
(Source: NASA Ames Research Center, AC77-0846-51)



N-240, Ground-breaking ceremony for the new Life Sciences building, 13 April 1964
(Source: NASA Ames Research Center, A-32424)



Space Life Sciences Payloads Office (SLSPO)
office manual cover, September 1983.
(Source: NASA Ames Research Center, AC83-0645.3)



N-240/N-240A, north facade, main entrance
(Source: Page & Turnbull)



N-240/N-240A, west end of south facade
(Source: Page & Turnbull)



N-240/N-240A, south facade, main entrance
(Source: Page & Turnbull)

Architectural Drawings for N-240 and N-240A

Space Environment Research Facility, Site Plan and Details
Architect: Garretson, Elmendorf, Klein, Reiben, Architects & Engineers
Date: 13 March 1964
Sheet: A 12363-A2
NASA EDC # 240-6301-A2

Space Environment Research Facility, Ground Floor Plan
Architect: Garretson, Elmendorf, Klein, Reiben, Architects & Engineers
Date: 13 March 1964
Sheet: A 12363-A3
NASA EDC # 240-6301-A3

Space Environment Research Facility, Second Floor Plan
Architect: Garretson, Elmendorf, Klein, Reiben, Architects & Engineers
Date: 13 March 1964
Sheet: A 12363-A4
NASA EDC # 240-6301-A4

Space Environment Research Facility, Exterior Elevations
Architect: Garretson, Elmendorf, Klein, Reiben, Architects & Engineers
Date: 13 March 1964
Sheet: A 12363-A6
NASA EDC # 240-6301-A6

Space Environment Research Facility, Exterior Elevations
Architect: Garretson, Elmendorf, Klein, Reiben, Architects & Engineers
Date: 13 March 1964
Sheet: A 12363-A7
NASA EDC # 240-6301-A7

Space Environment Research Facility, Longitudinal Section and High Bay Laboratory Elevations
Architect: Garretson, Elmendorf, Klein, Reiben, Architects & Engineers
Date: 13 March 1964
Sheet: A 12363-A8
NASA EDC # 240-6301-A8

Life Sciences Flight Experiments Facility (Addition to Building N-240), Site Plan
Architect: Reid & Tarics Associates, Architects & Engineers
Date: 16 July 1980
Sheet: A 240-7903-A2
NASA EDC # 240-7903-A2

Life Sciences Flight Experiments Facility (Addition to Building N-240), First Floor Plan

Architect: Reid & Tarics Associates, Architects & Engineers

Date: 16 July 1980

Sheet: A 240-7903-A7

NASA EDC # 240-7903-A7

Life Sciences Flight Experiments Facility (Addition to Building N-240), Second Floor Plan

Architect: Reid & Tarics Associates, Architects & Engineers

Date: 16 July 1980

Sheet: A 240-7903-A8

NASA EDC # 240-7903-A8


Life Sciences Flight Experiments Facility (Addition to Building N-240), Exterior Elevations

Architect: Reid & Tarics Associates, Architects & Engineers

Date: 16 July 1980

Sheet: A 240-7903-A9

NASA EDC # 240-7903-A9

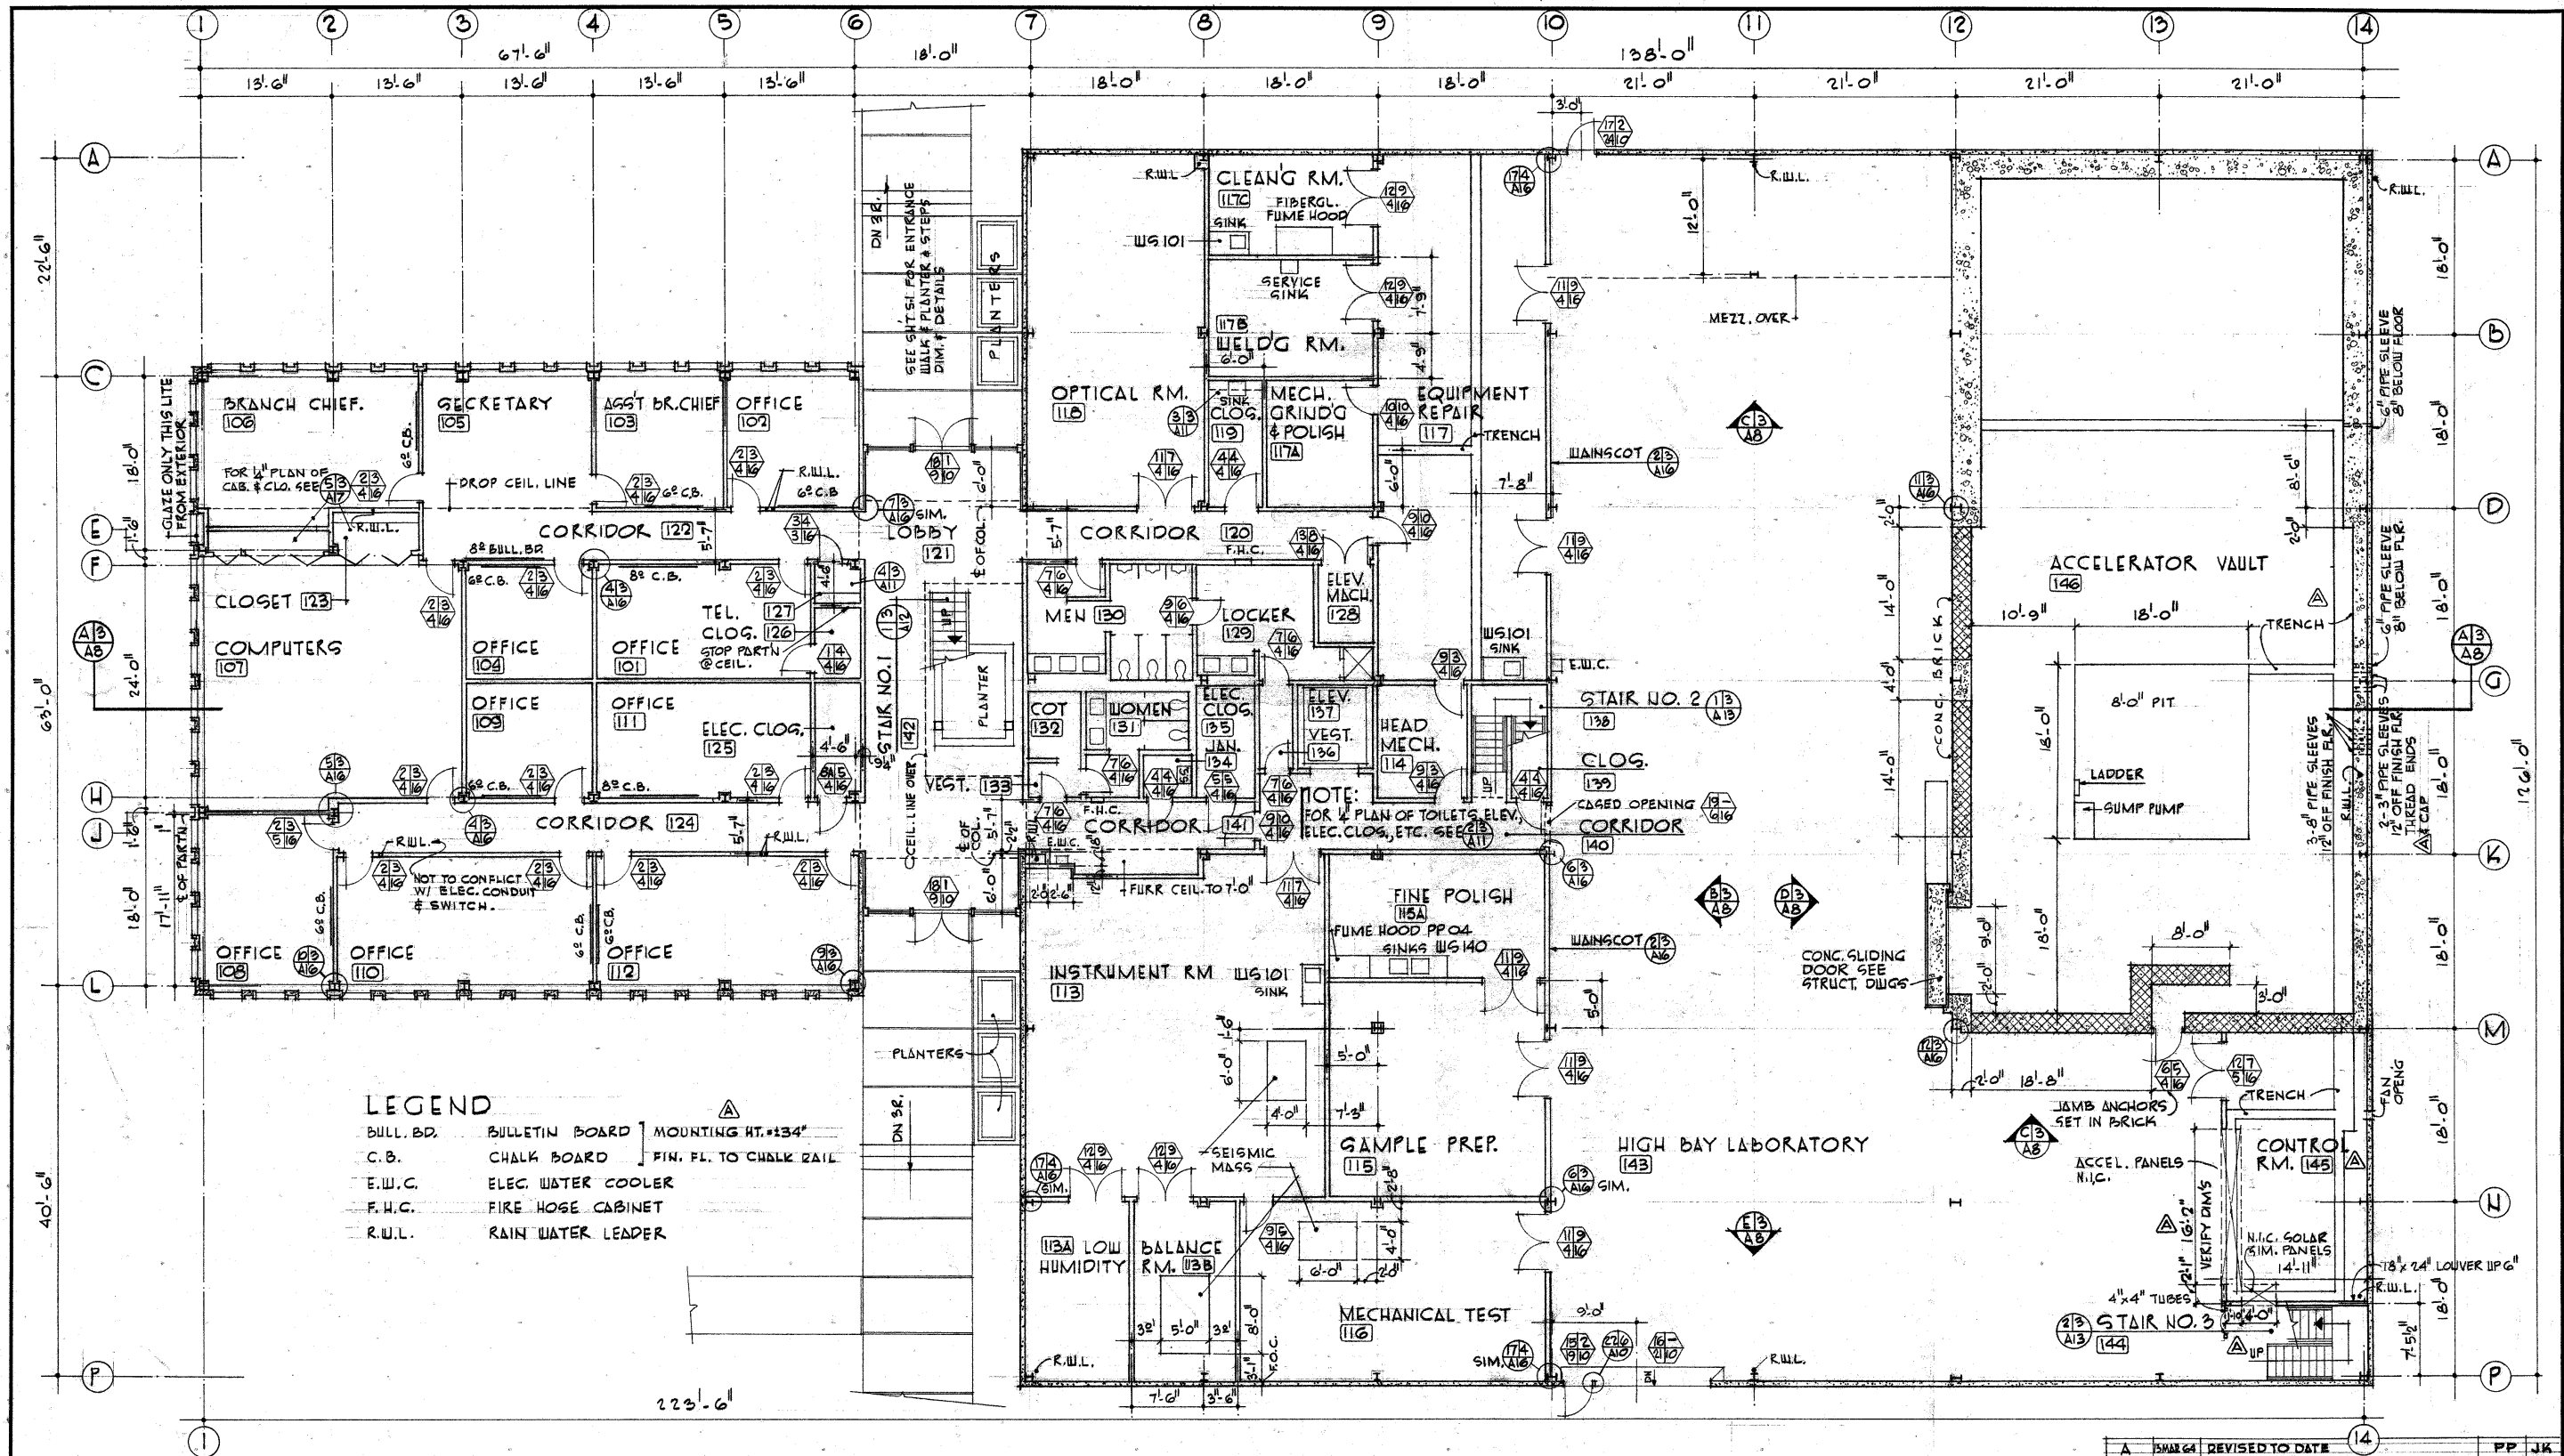


GROUND FLOOR PLAN

NOTE:

ALL STUDS TERMINATING AT METAL DECK SEE DETAILS

13/23 AIG AIG

NORTH

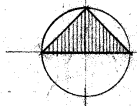

GARRETSON · ELMENDORF · KLEIN · REIBIN
ARCHITECTS · ENGINEERS

216 MARKET STREET, SAN FRANCISCO 11, CALIFORNIA

APPROVED BY:

DESIGNED BY: JK

DATE: 3 FEB 64

404

3 FEB 64


AS NOTED

AS NOTED

AS NOTED

LETTER	DATE	REVISION DESCRIPTION	PP	JK
A	5 MAR 64	REVISED TO DATE		
NATIONAL AERONAUTICS AND SPACE ADMINISTRATION				
AMES RESEARCH CENTER				
MOFFETT FIELD, CALIFORNIA				
SPACE ENVIRONMENT RESEARCH FACILITY				
GROUND FLOOR PLAN				
DRAWN	CN	CHECKED	INDEX	MATERIAL
DESIGN ENGINEER	BRANCH	APPROVED	ASSEMBLY	LIMITS UNLESS NOTED
APPROVED	DATE	APPROVED	DATE	APPROVED
3 FEB 64	3 FEB 64	3 FEB 64	3 FEB 64	3 FEB 64
A12363-A3 A				


240-6301A-3
S.E.R.F. GROUND FLOOR PLAN

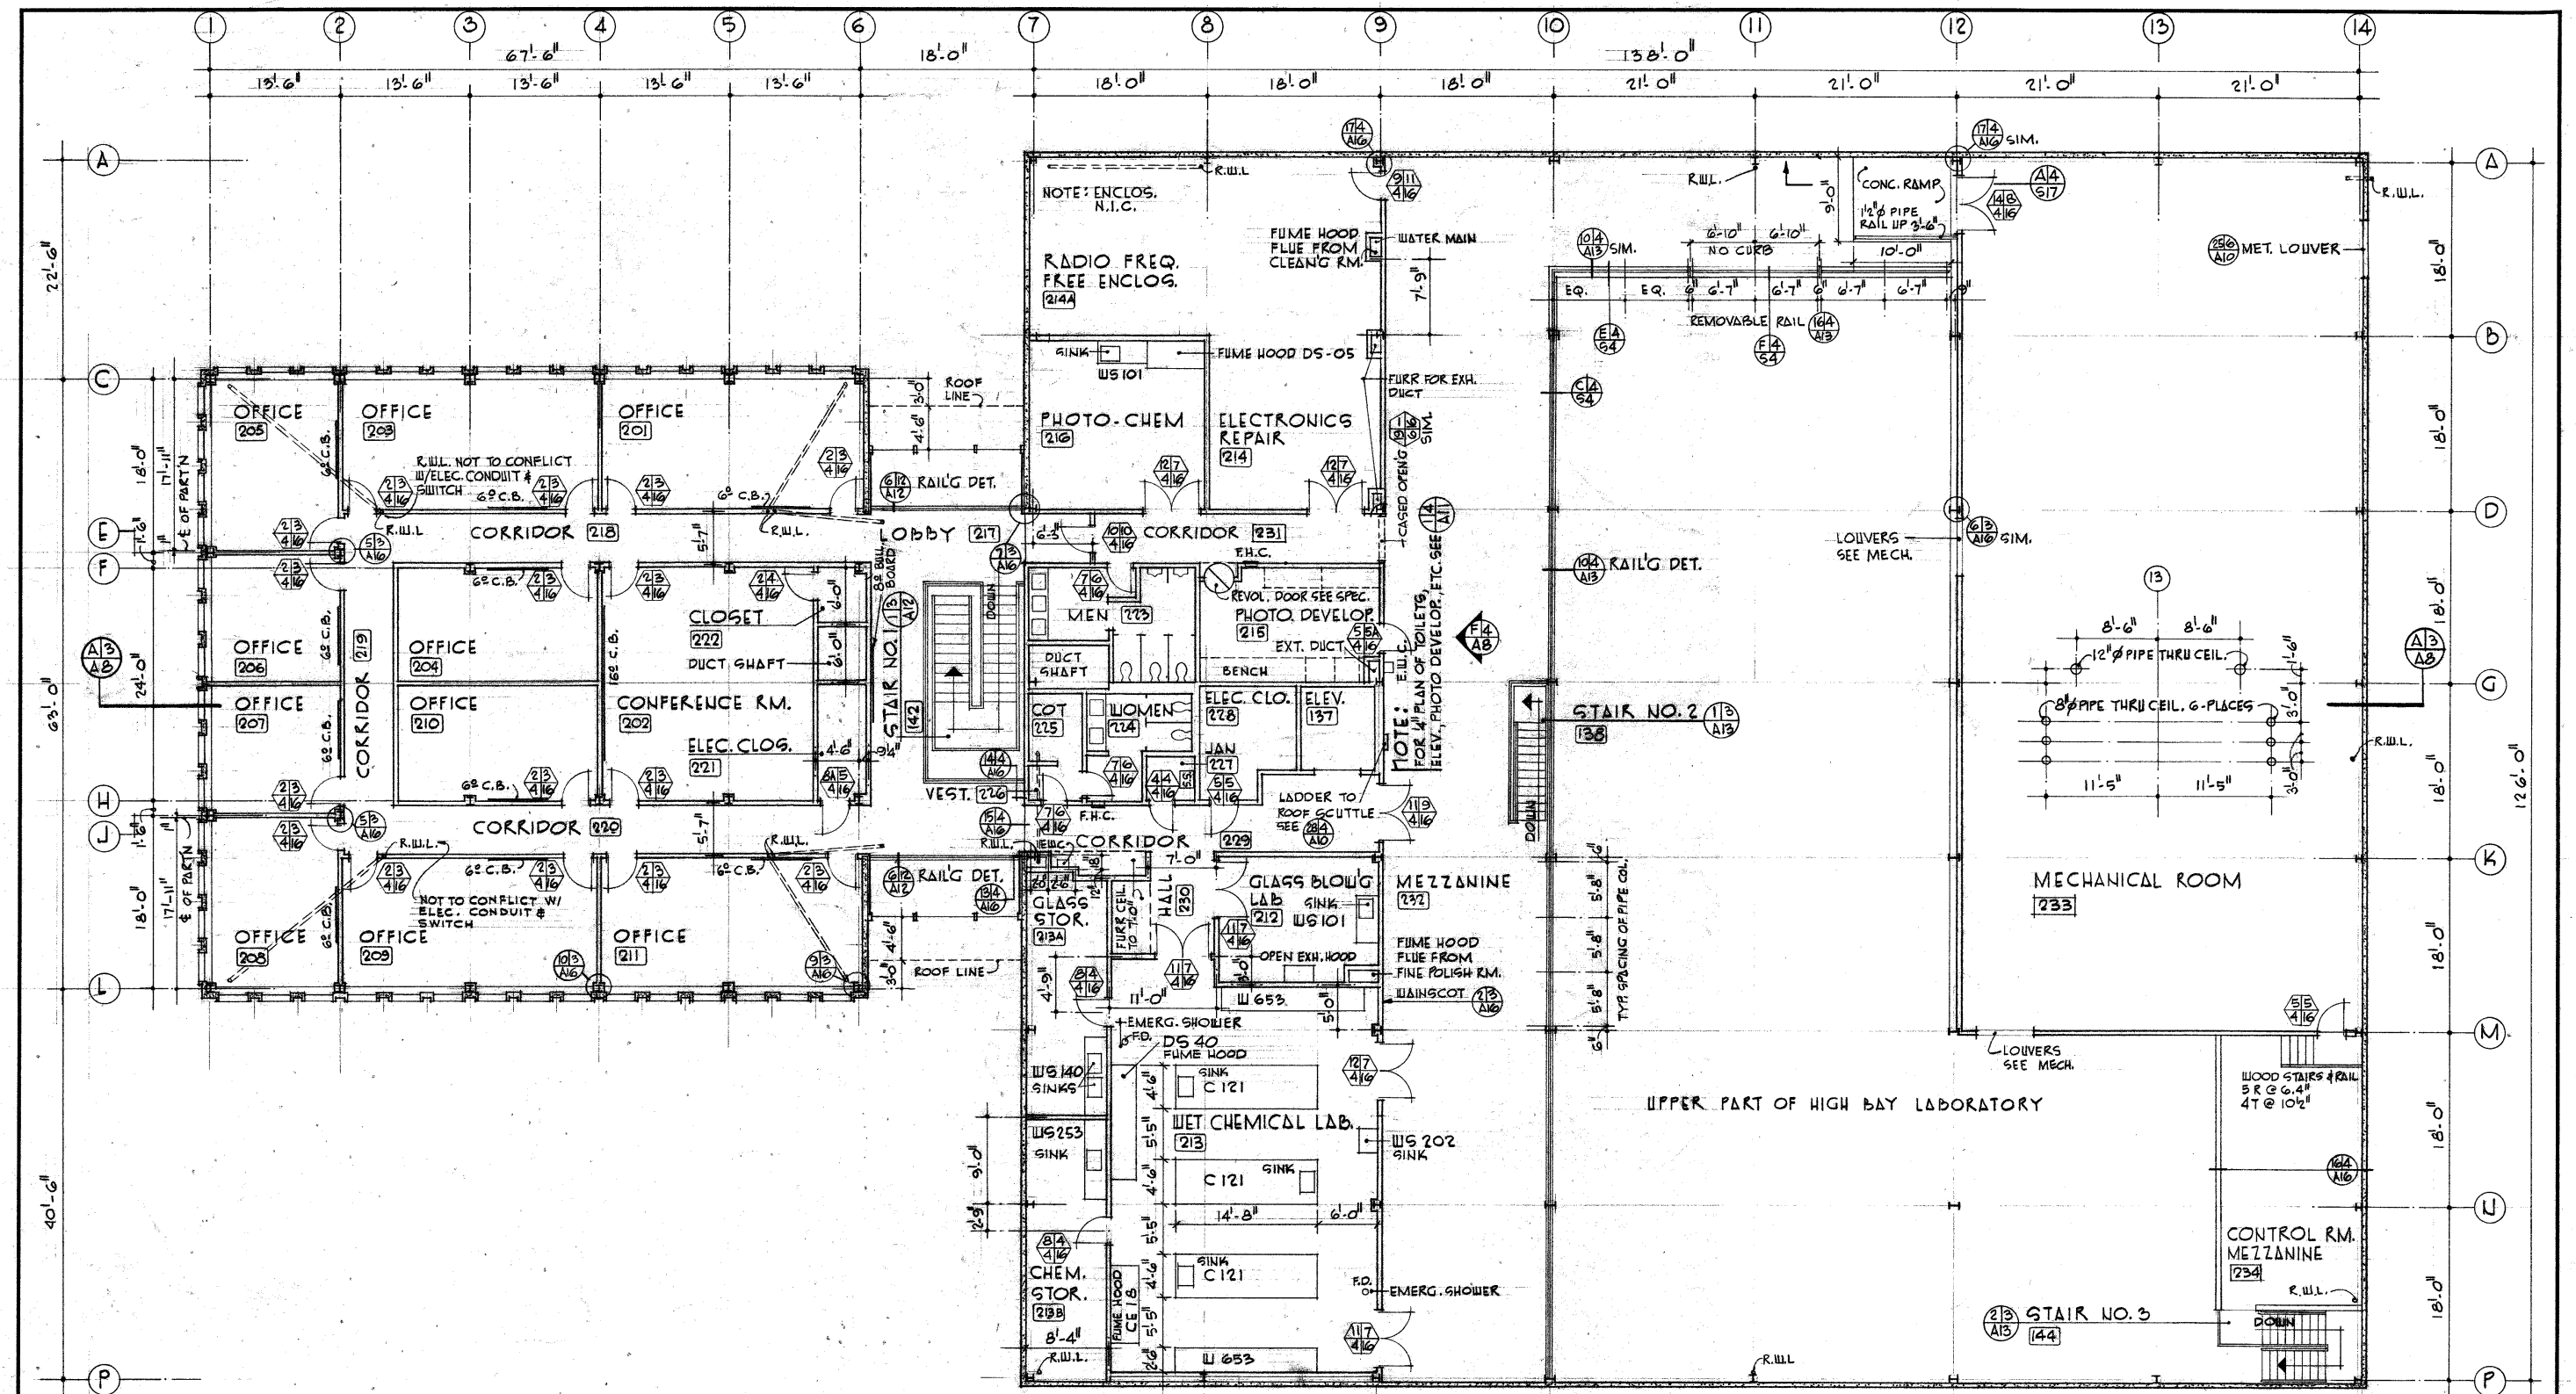

SECOND FLOOR PLAN

18'-0" 1'-0"

NORTH

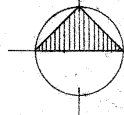

GARRETSON · ELMENDORF · KLEIN · REIBIN
ARCHITECTS · ENGINEERS


216 MARKET STREET, SAN FRANCISCO 11, CALIFORNIA

APPROVED BY: *[Signature]* DESIGNED BY: *[Signature]*
JOB NO. 404 DATE: 3 FEB 64


LETTER	DATE	REVISION DESCRIPTION	DRAWN	APP
NATIONAL AERONAUTICS AND SPACE ADMINISTRATION AMES RESEARCH CENTER MOFFETT FIELD, CALIFORNIA				
SPACE ENVIRONMENT RESEARCH FACILITY				
SECOND FLOOR PLAN				
DRAWN CN	CHECKED YH	INDEX YH	MATERIAL	LIMITS UNLESS NOTED
DESIGN ENGINEER	BRANCH	ASST. DRG. ENG.	FRAC.	DEC.
APPROVED	DATE	SCALE	REV.	
APPROVED 30-64	DATE 3 FEB 64	SCALE AS NOTED	REV.	

A12363-A4


240-6301A-1-14

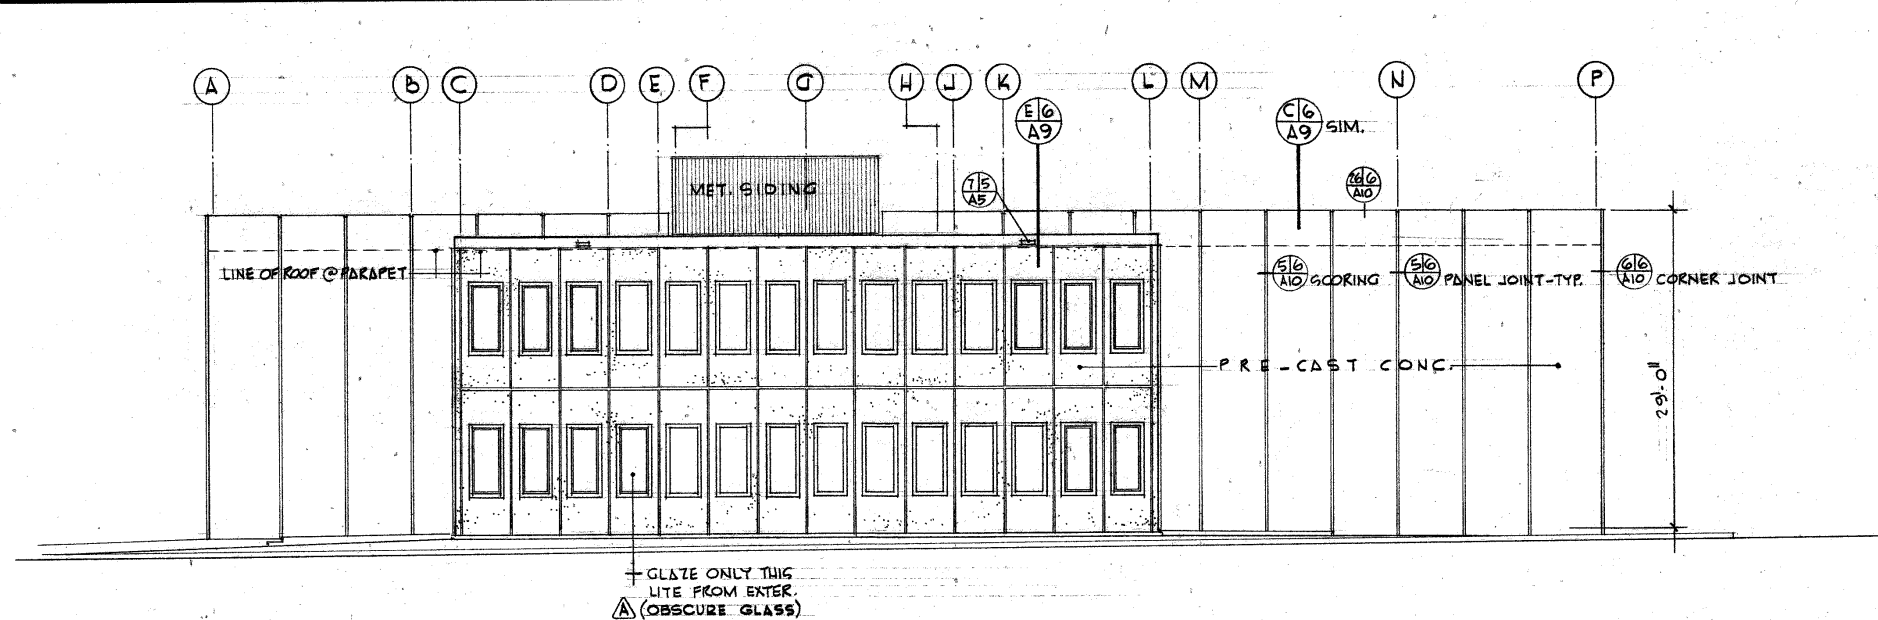


WEST ELEVATION

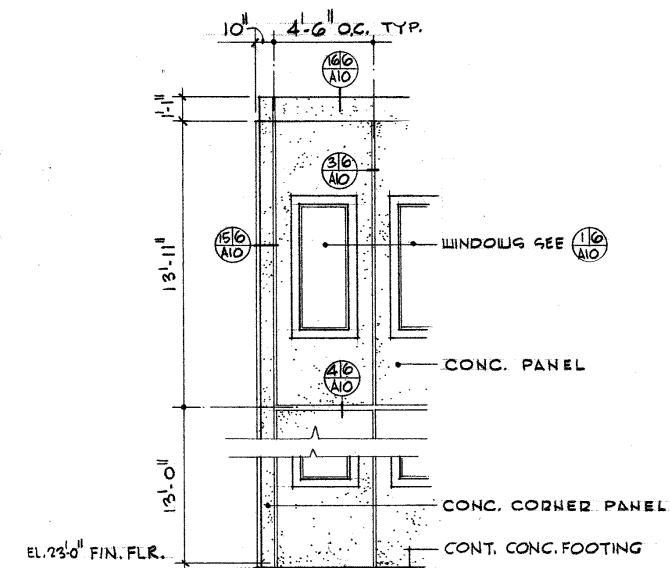


TYPICAL OFFICE PANEL BAY ELEV. 4'-10"

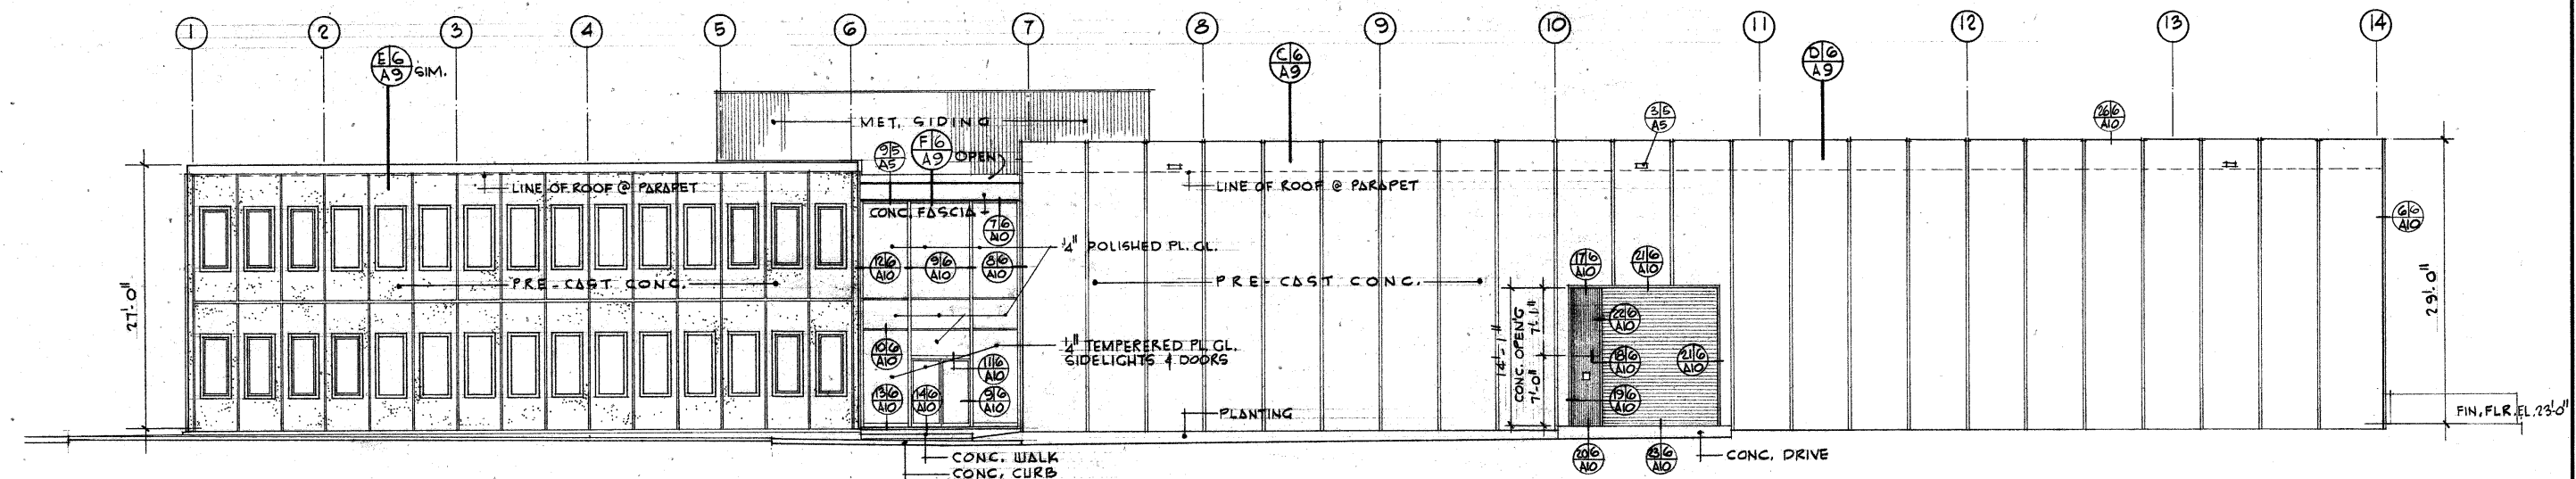


SOUTH ELEVATION

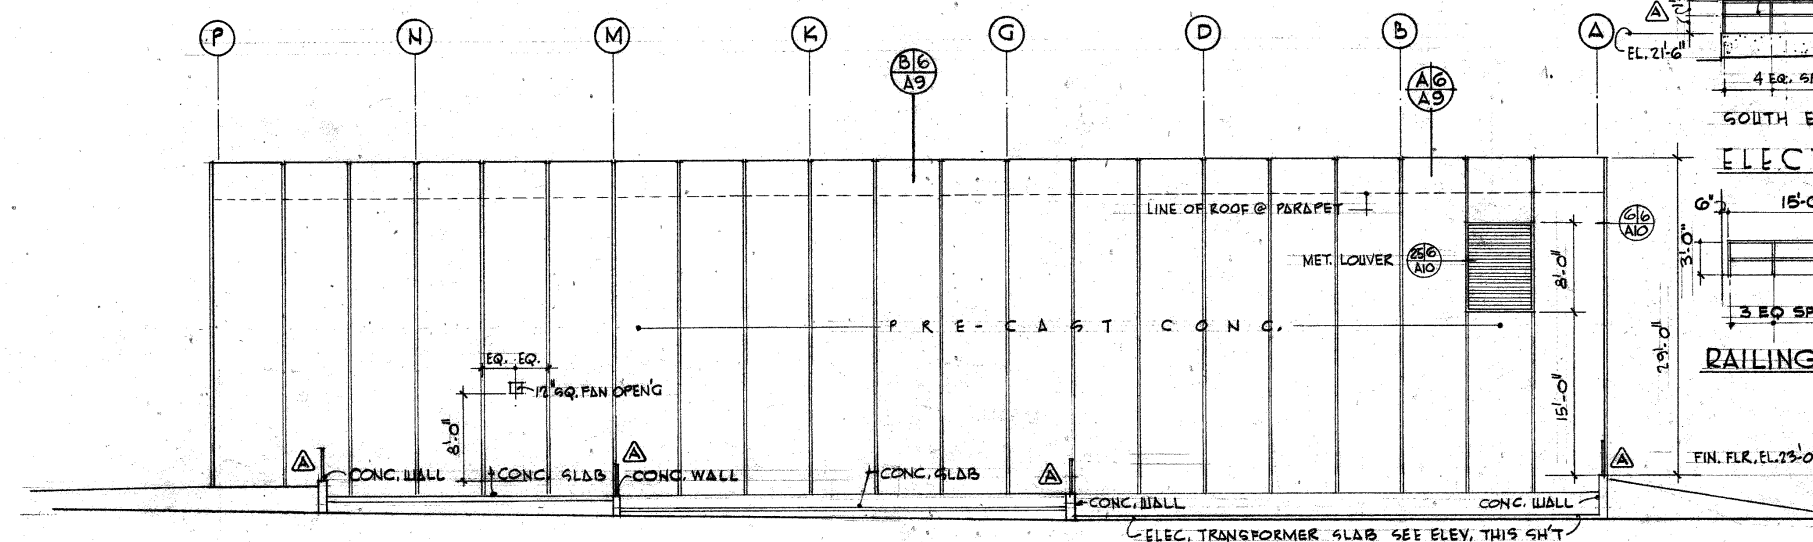

EAST ELEVATION

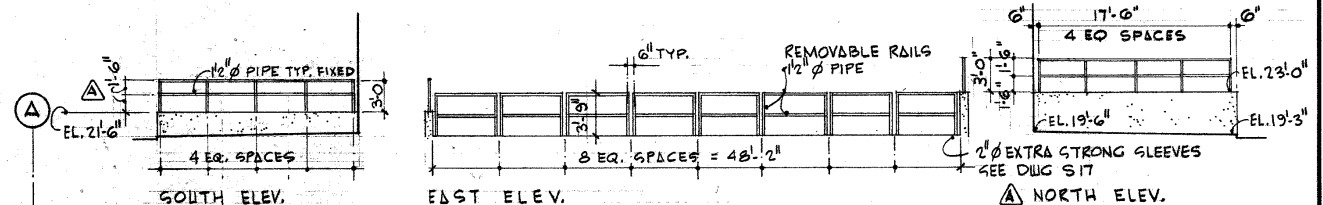

ELECTRICAL TRANSFORMER SLAB ELEV. 5'-10"

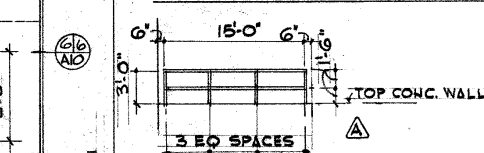


RAILING-EA. SIDE COOLING TOWER PAD

GARRETSON · ELMENDORF · KLEIN · REIBIN
ARCHITECTS · ENGINEERS
216 MARKET STREET, SAN FRANCISCO 11, CALIFORNIA
APPROVED BY: *[Signature]* DATE: 3-FEB-64
JOB NO: 404 DESIGNED BY: JK-PP


LETTER	DATE	REVISION DESCRIPTION	PP	JK
A	3-MAR-64	REVISED TO DATE		
NATIONAL AERONAUTICS AND SPACE ADMINISTRATION				
AMES RESEARCH CENTER				
MOFFETT FIELD, CALIFORNIA				
SPACE ENVIRONMENT RESEARCH FACILITY				
EXTERIOR ELEVATIONS				
DRAWN C.N.	CHECKED J.M.	INDEX J.M.	MATERIAL	LIMITS UNLESS NOTED
DESIGN ENGINEER	BRANCH			
APPROVED	ASSN. ENGR.			
APPROVED J.B. 1-30-64	SCALE AS NOTED			

A12363-A6 A


240-6301A-1-16

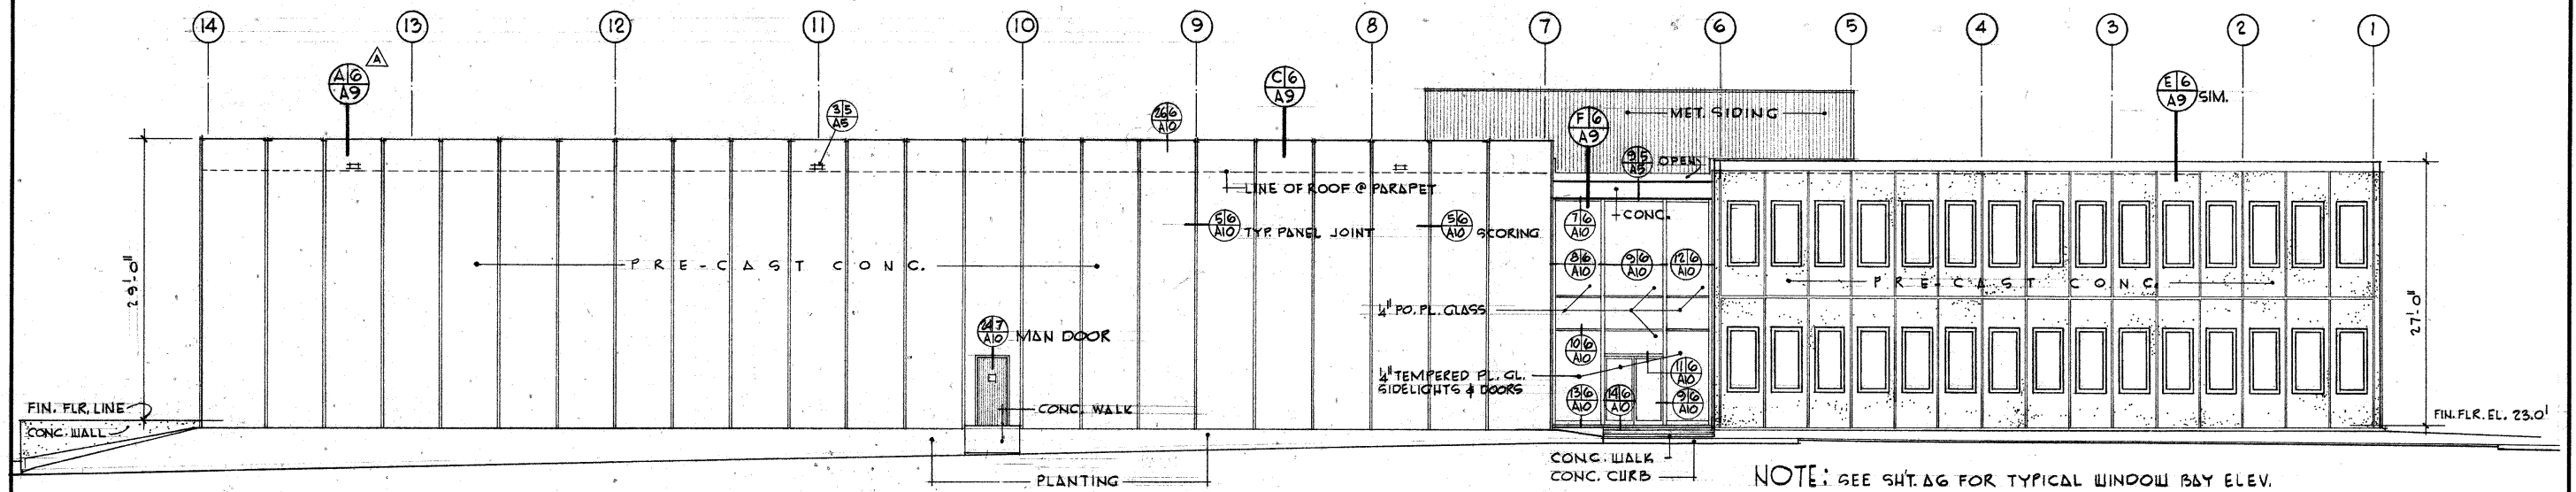

NORTH ELEVATION

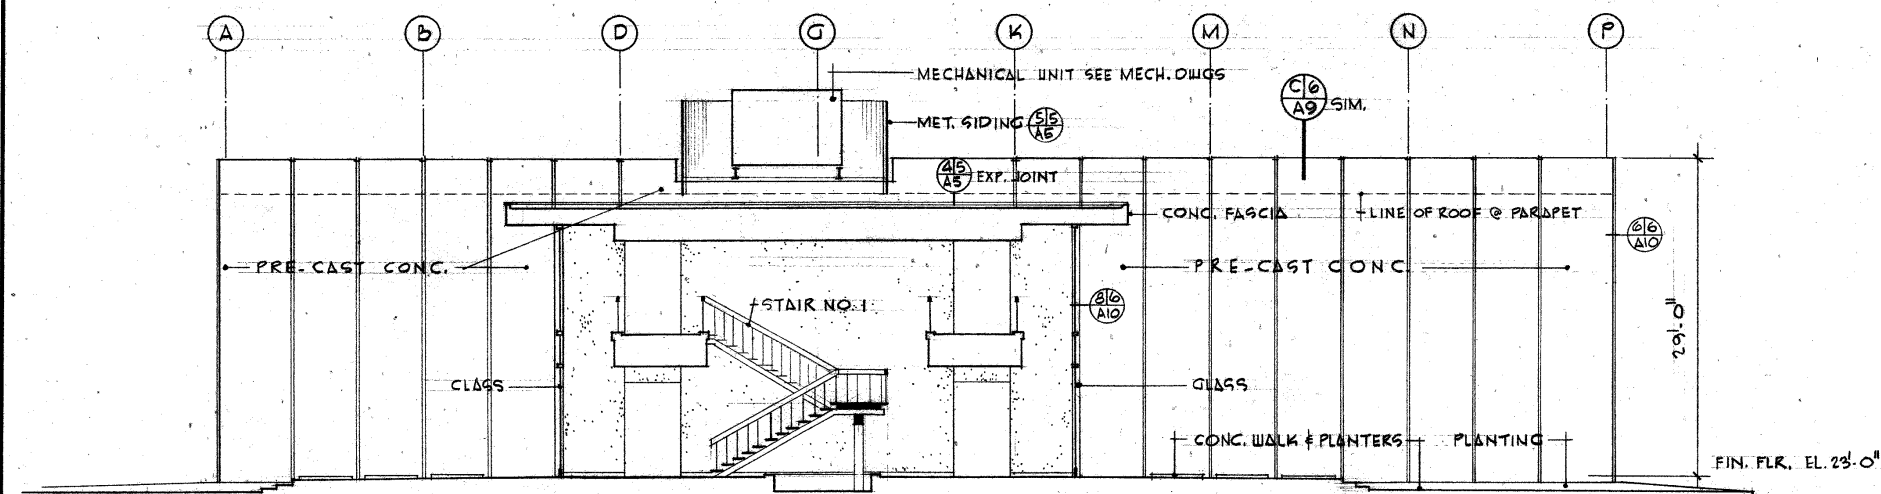

WEST ELEVATION OF LABORATORY WING

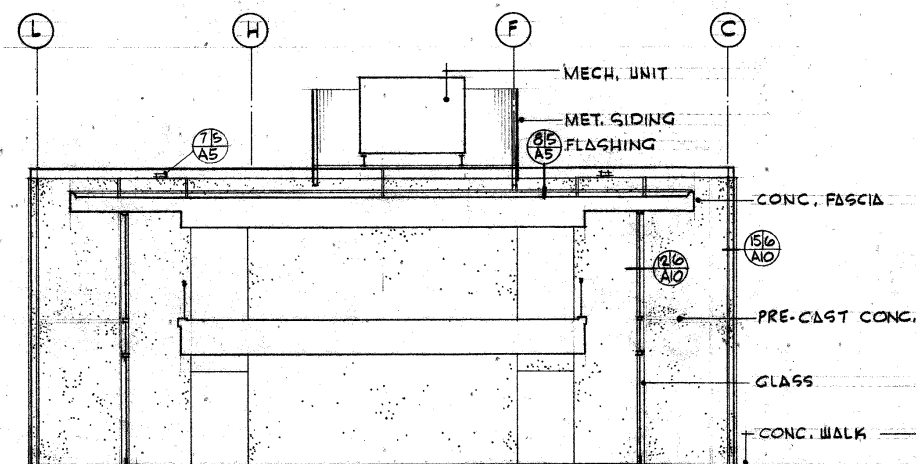







EAST ELEVATION OF OFFICE WING

GARRETSON • ELMENDORF • KLEIN • REIDIN
ARCHITECTS • ENGINEERS
216 MARKET STREET, SAN FRANCISCO 11, CALIFORNIA

APPROVED BY: *[Signature]* DESIGNED BY: *[Signature]* DATE: 3-FEB-64
JOB NO. 404

LETTER	DATE	REVISION DESCRIPTION	PP	JK
A	15-MAR-64	REVISED TO DATE		
NATIONAL AERONAUTICS AND SPACE ADMINISTRATION				
AMES RESEARCH CENTER				
MOFFETT FIELD, CALIFORNIA				
SPACE ENVIRONMENT RESEARCH FACILITY				
EXTERIOR ELEVATIONS				
DRAWN CN	CHECKED CN	INDEX CN	MATERIAL	LIMITS UNLESS NOTED
DESIGN ENGINEER	BRANCH	BRANCH	PRAC	DEC
APPROVED	ASSAULTING	SCALE	AS NOTED	
APPROVED JSARAF	DATE 1-30-64	SCALE AS NOTED	A 12363-A7 A	

101-14301/17-1-17

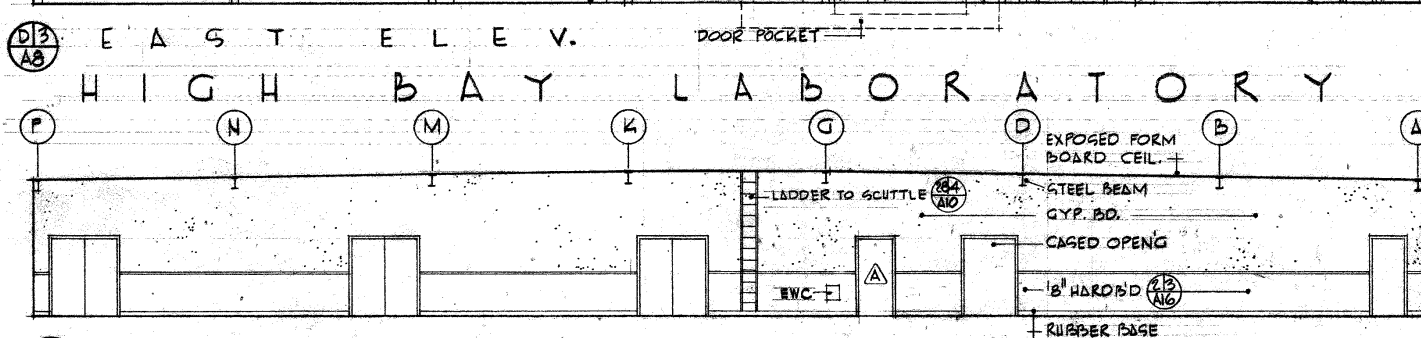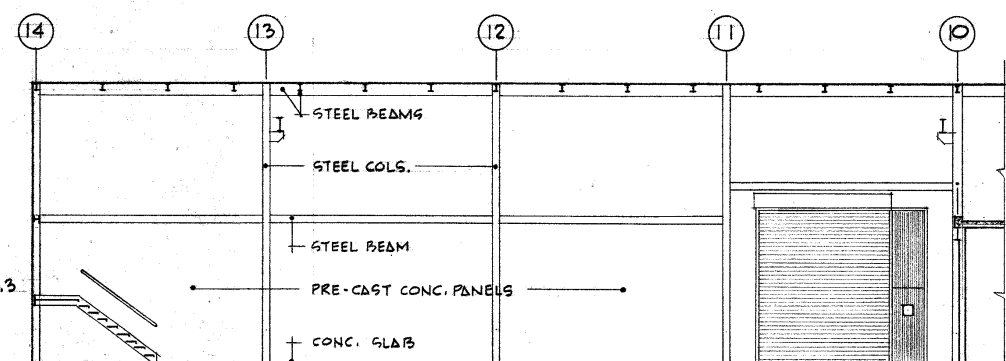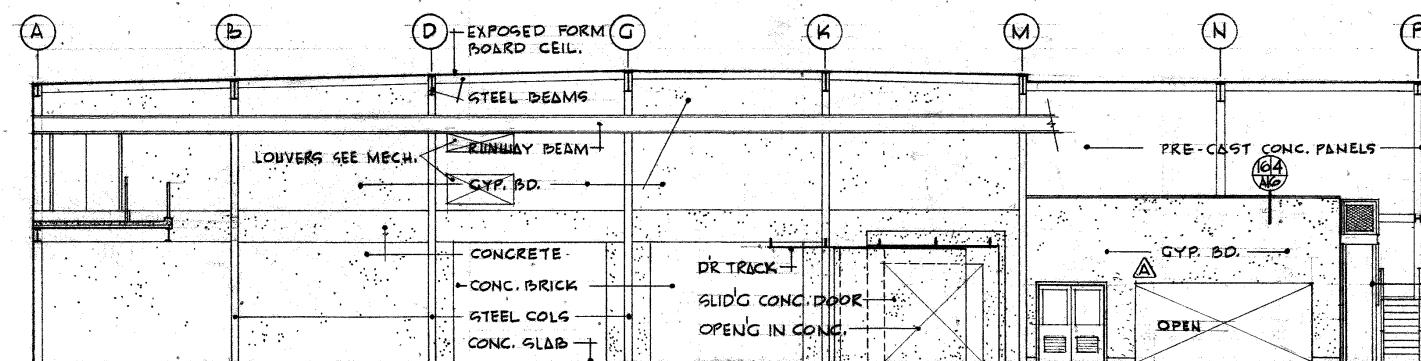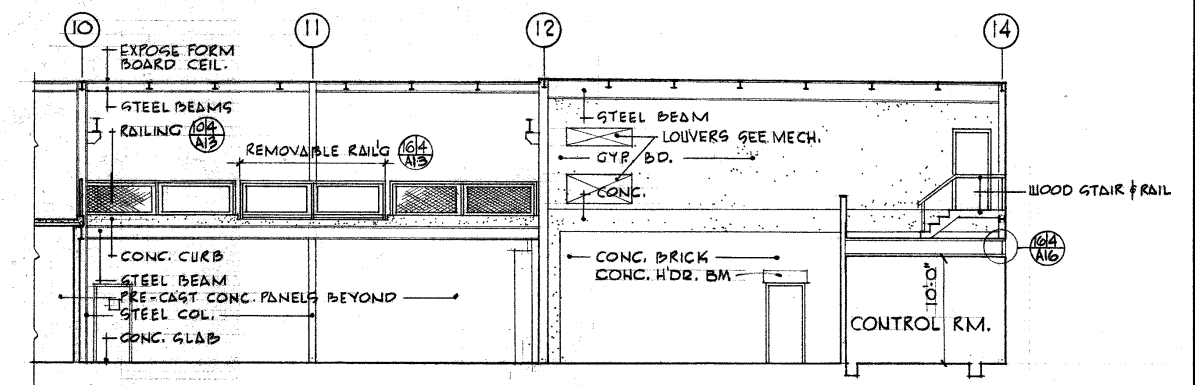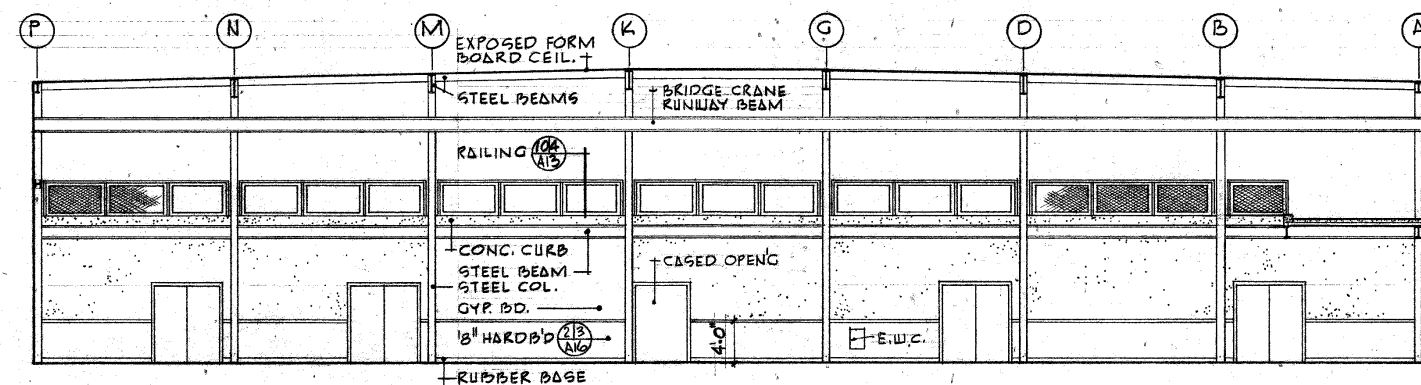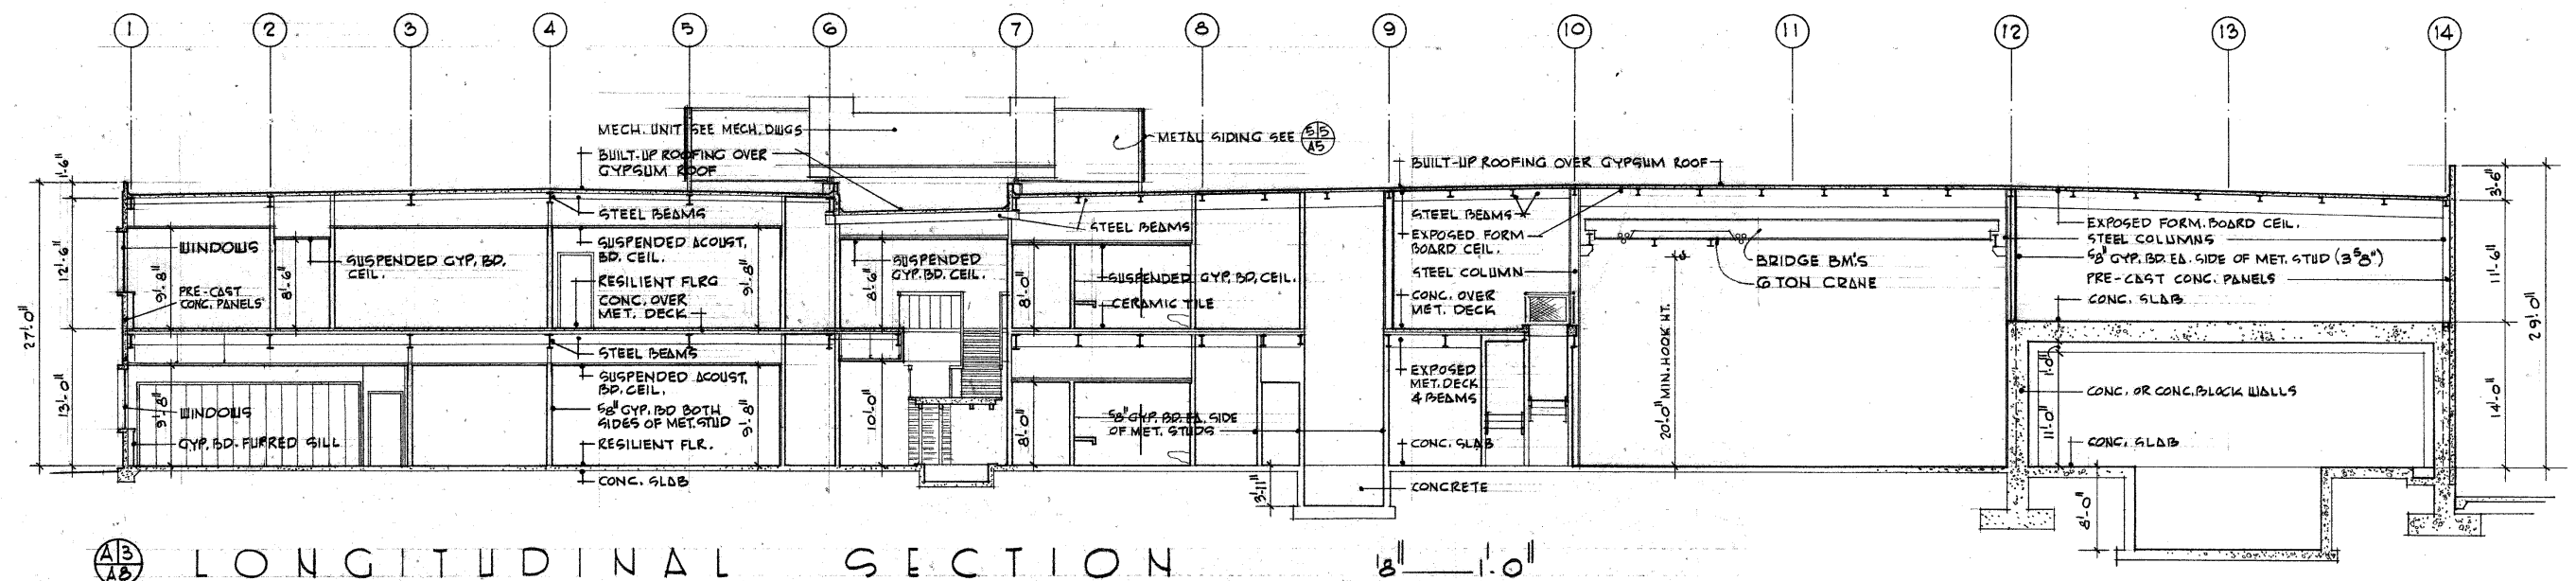

SOUTH ELEV.
 ELEVATION S
 SCALE 1"=1.0'

GARRETSON • ELMENDORF • KLEIN • REIBIN
ARCHITECTS • ENGINEERS
 216 MARKET STREET, SAN FRANCISCO 11, CALIFORNIA

A		13MAR68		REVISED TO DATE		PP		JK	
LETTER		DATE		REVISION DESCRIPTION		DRAWN		APP	
NATIONAL AERONAUTICS AND SPACE ADMINISTRATION AMES RESEARCH CENTER MOFFETT FIELD, CALIFORNIA									
SPACE ENVIRONMENT RESEARCH FACILITY LONG SECTION AND HIGH BAY LAB, ELEVATIONS									
DRAWN C.N.		CHECKED		INDEX yuu		MATERIAL		LIMITS UNLESS NOTED	
DESIGN ENGINEER		BRANCH							
APPROVED		ASSN. CHG. NO.				FRAC		DEC.	
								ANL. REV.	
APPROVED J.B. BARNES 1-30-68		SCALE AS NOTED		A12363-A8				A	

240-6301A--8

MCCORD AVE.

WALCOTT RD.

NAVY
WAREHOUSE

Legend

- 17E EXISTING GRADES
- 17 NEW GRADES
- 17.31 EXIST. SPOT ELEVATION
- 18.5 NEW SPOT ELEVATION
- EMH ELECTRICAL MANHOLE
- EXIST. CORRUGATED 12" PIPE
- NEW CORRUGATED 12" PIPE

NOTE: FOR SITE DEMOLITION WORK SEE DEMOLITION PLAN, SHT. A-4
- FOR LANDSCAPING SEE SHT. L-1
- FOR SPRINKLER PLAN SEE SHT. L-2
- FOR SITE UTILITIES SEE MECH, ELEC & PLUMBING DRAWINGS.

SEVERYNS AVE.

SO. WAREHOUSE RD.

NEW
LIFE SCIENCES
FLIGHT EXPERIMENTS
FACILITY

EXIST. BLDG. REMODELED
TO LIFE SCIENCES

EXIST. MATERIALS SCIENCES LAB
TO REMAIN


EXIST. AIRBORN MISSION
& APPLICATIONS DIV.


 




site plan

RTA
REID & TARIC ASSOCIATES
ARCHITECTS & ENGINEERS
1019 MARKET STREET
SIXTH FLOOR
SAN FRANCISCO, CA 94103
(415) 863-2420

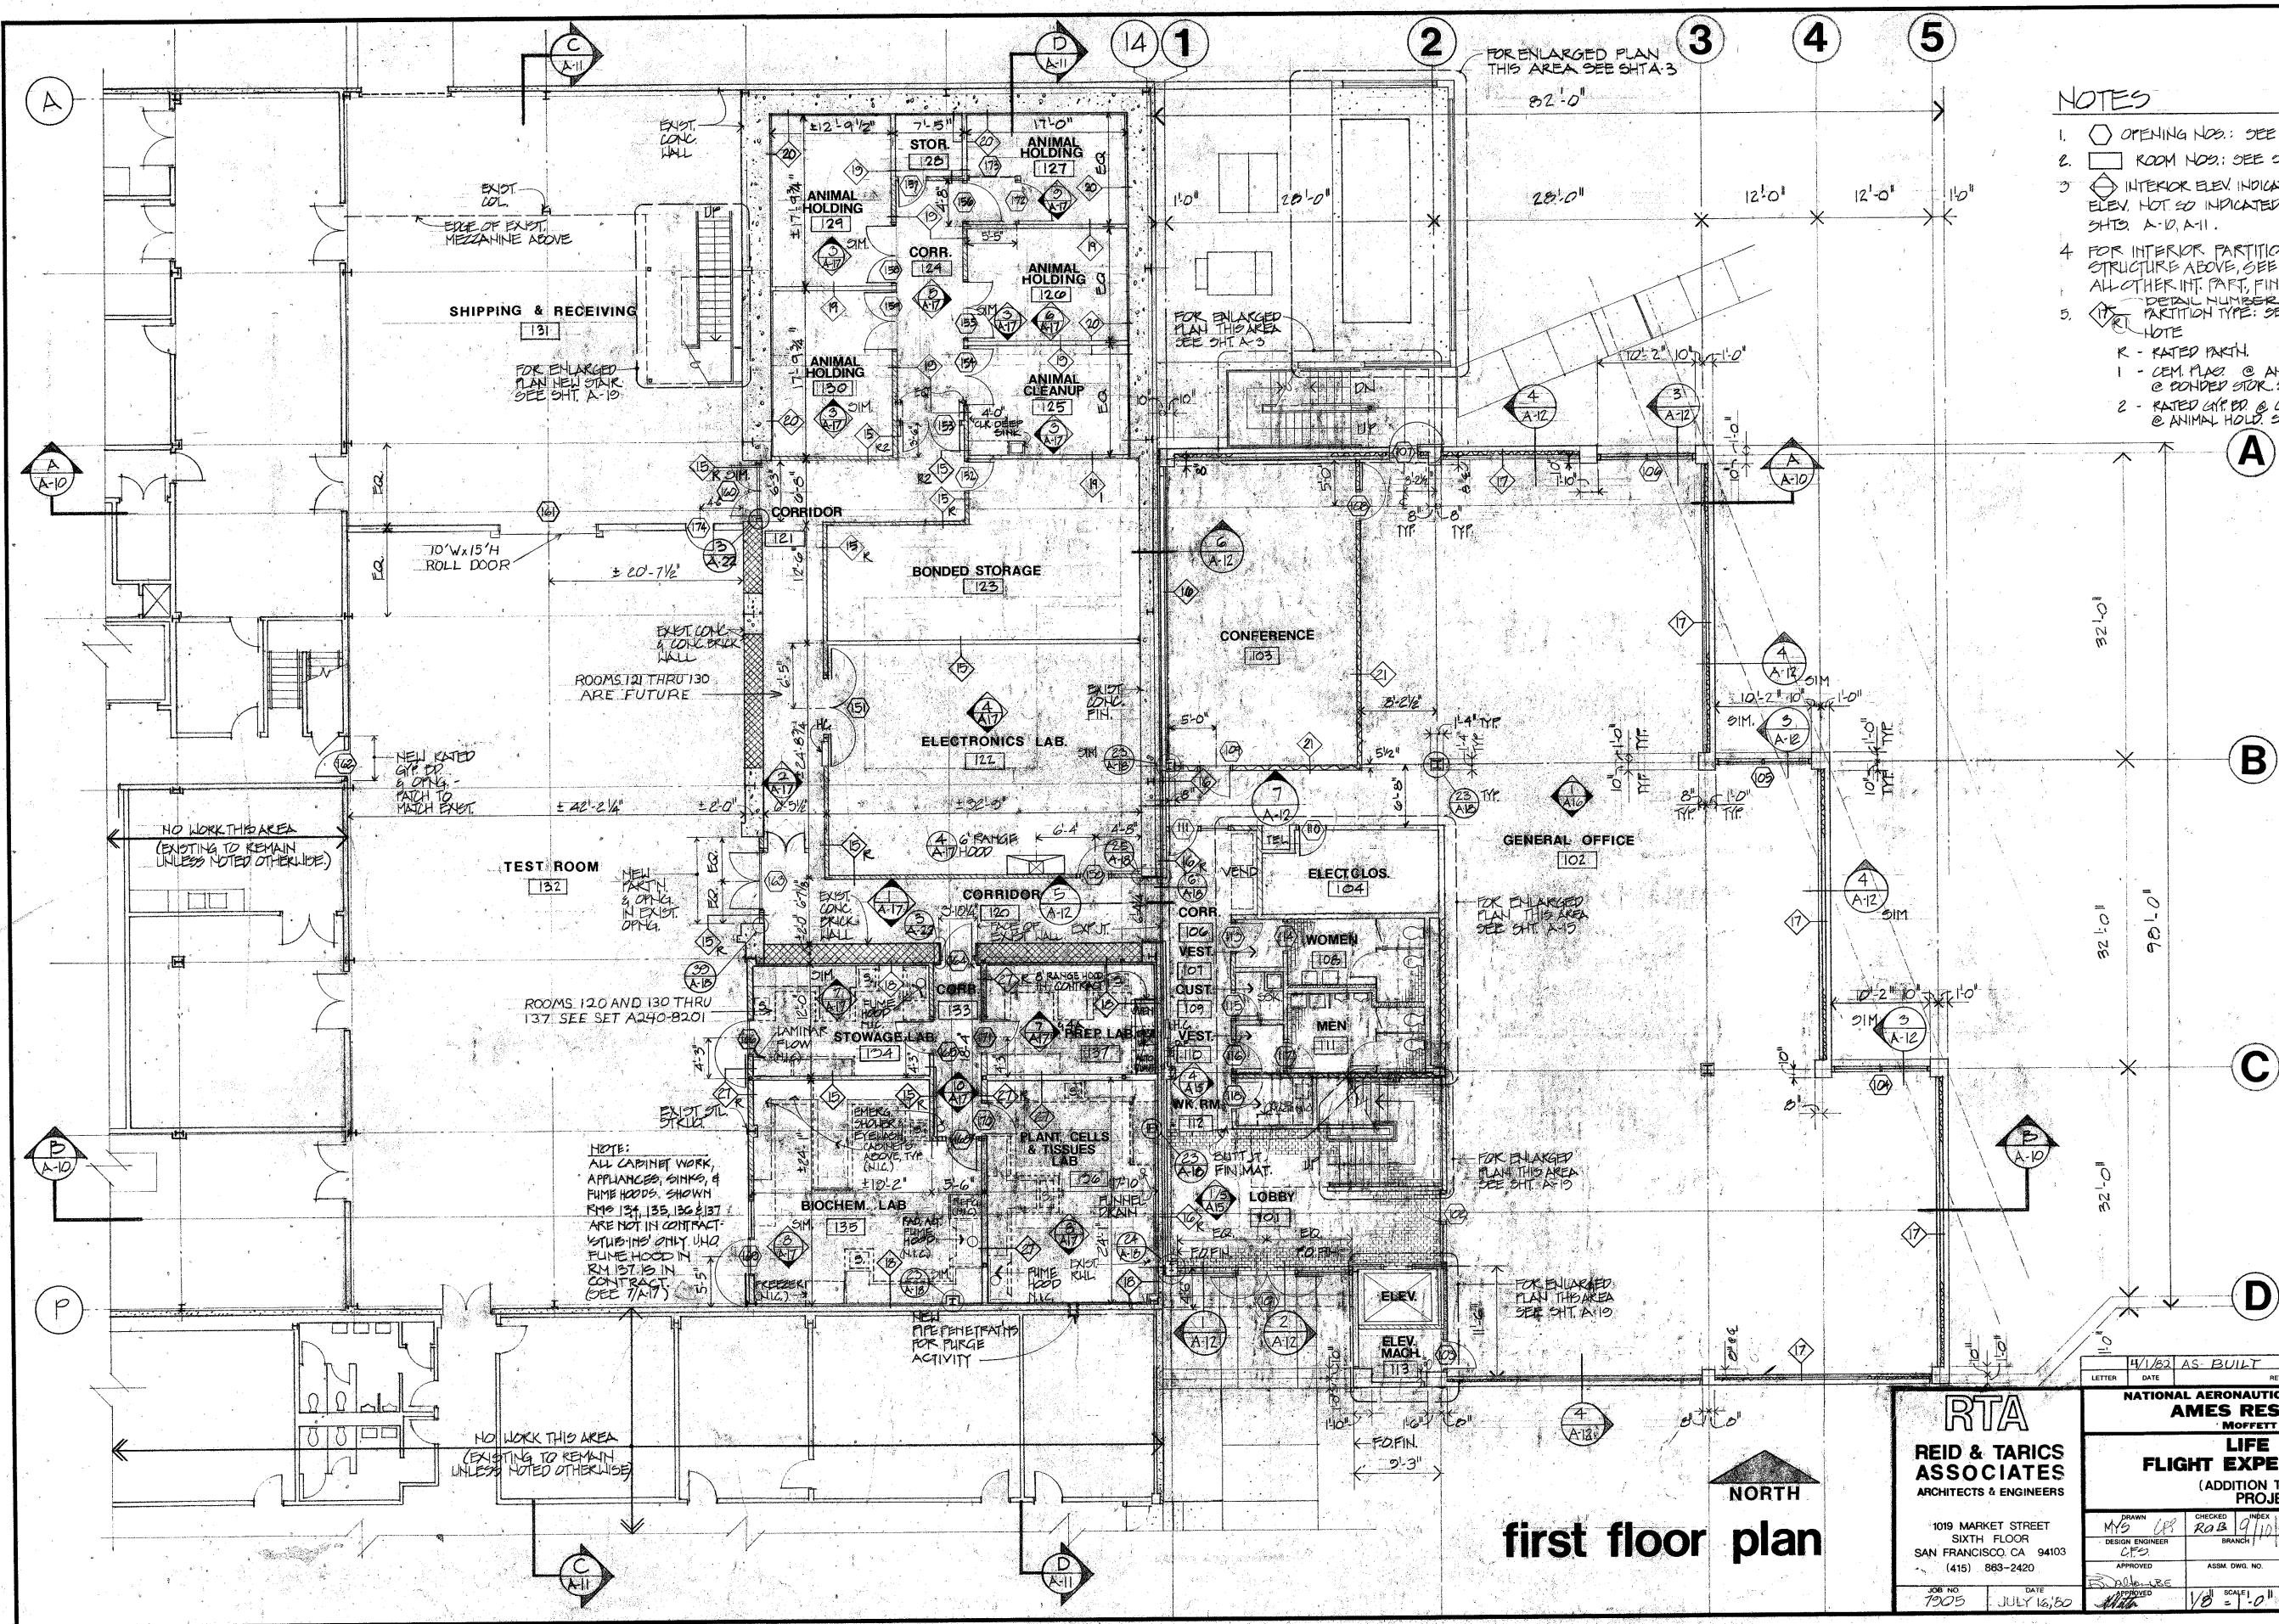
LETTER	DATE	REVISION DESCRIPTION	DRAWN	APP.
NATIONAL AERONAUTICS AND SPACE ADMINISTRATION AMES RESEARCH CENTER MOFFETT FIELD, CALIFORNIA				
LIFE SCIENCES FLIGHT EXPERIMENTS FACILITY (ADDITION TO BUILDING N-240) PROJECT NO. 2171				
DRAWN MYS, KD	CHECKED RUB 9/1/80	MATERIAL 7/25/80	LIMITS UNLESS NOTED	
DESIGN ENGINEER CFS	APPROVED MYS	ASSN. DWG. NO.	FRAC.	DEC.
JOB NO. 7905	DATE JULY 14, 80	SCALE 1/16" = 1'-0"	A240-7903 A2	







- # NOTES
1.  OPENING NOS.: SEE SHT.A21 FOR SCHEDULE.
 2.  ROOM NOS.: SEE SHT.A22 FOR FIN. SCHED.
 3.  INTERIOR ELEV. INDICATOR. FOR MANY INT. ELEV. NOT SO INDICATED SEE BLDG. SECTIONS SHTS. A-10, A-11.
 4. FOR INTERIOR PARTITIONS W/ FINISH TO STRUCTURE ABOVE, SEE REF. CLG. PLAN, SHT.A-13. ALL OTHER INT. PART. FINISH TO MIN 4" ABOVE CLG.
 5.  ^{DETAIL NUMBER} PARTITION TYPE: SEE DETAIL, SHEET A-10.
NOTE
K - RATED PARTN. =====
 - 1 - CEM. FLAS. @ ANIMAL HOLD SIDE, GYP. BR @ CONCRETE SIDE. SEE 13/A-10.
 - 2 - RATED GYP. BR @ CORR. SIDE, CEM. FLAS. @ ANIMAL HOLD SIDE. SEE 13/A-10.

A circular professional seal for a registered architect in the state of California. The outer ring contains the text "REGISTERED ARCHITECT" at the top and "STATE OF CALIFORNIA" at the bottom. Inside the ring, the name "CHARLES F. SCHRADER" is printed in an arc. Below the name, the number "No. C4812" is printed. A handwritten signature, "Charles F. Schrader", is written across the center of the seal, overlapping the name and number. Two small five-pointed stars are positioned on either side of the number "No. C4812".

141/62		AS BUILT		REVISION DESCRIPTION		E.S.T.		DRAWN		APP.	
LETTER		DATE									
NATIONAL AERONAUTICS AND SPACE ADMINISTRATION AMES RESEARCH CENTER MOFFETT FIELD, CALIFORNIA											
LIFE SCIENCES FLIGHT EXPERIMENTS FACILITY (ADDITION TO BUILDING N-240) PROJECT, NO. 2171											
DRAWN		CHECKED		INDEX		MATERIAL		LIMITS UNLESS NOTED			
MYS		RAB		9/11/58		7/25/80		FRAC.		DEC.	
DESIGN ENGINEER		BRANCH									
CPS		ASSM DWG. NO.									
APPROVED											
240-7903		1/8" (SCALE)		1:10"		A 240-7903		A-7			

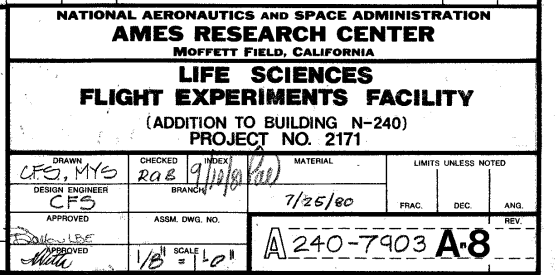

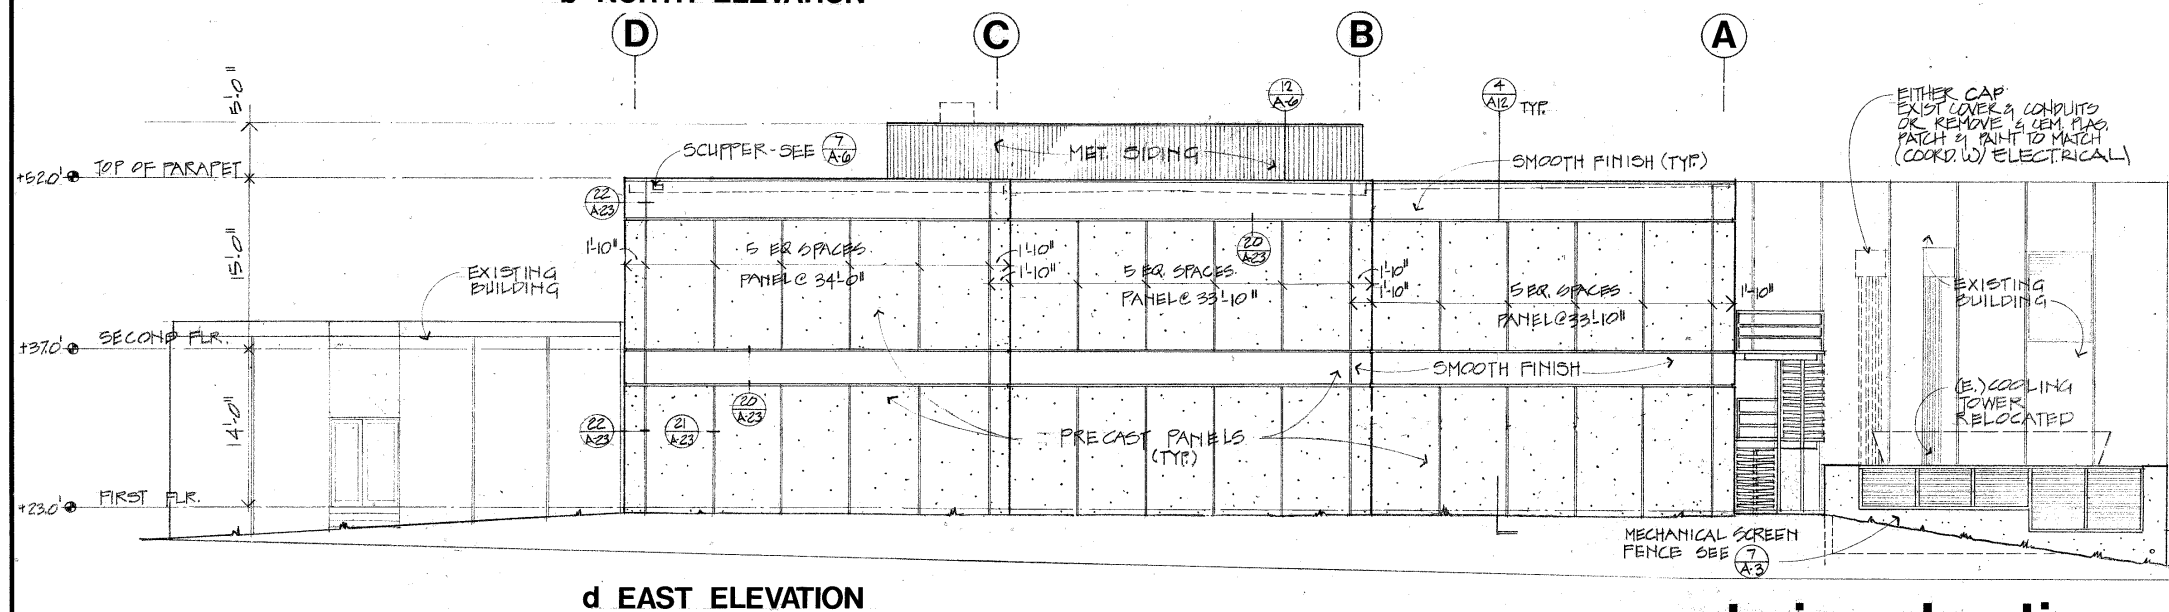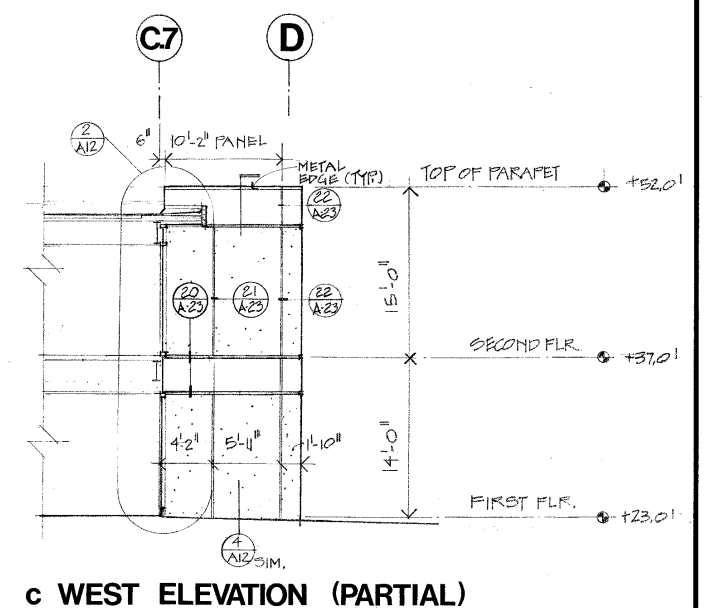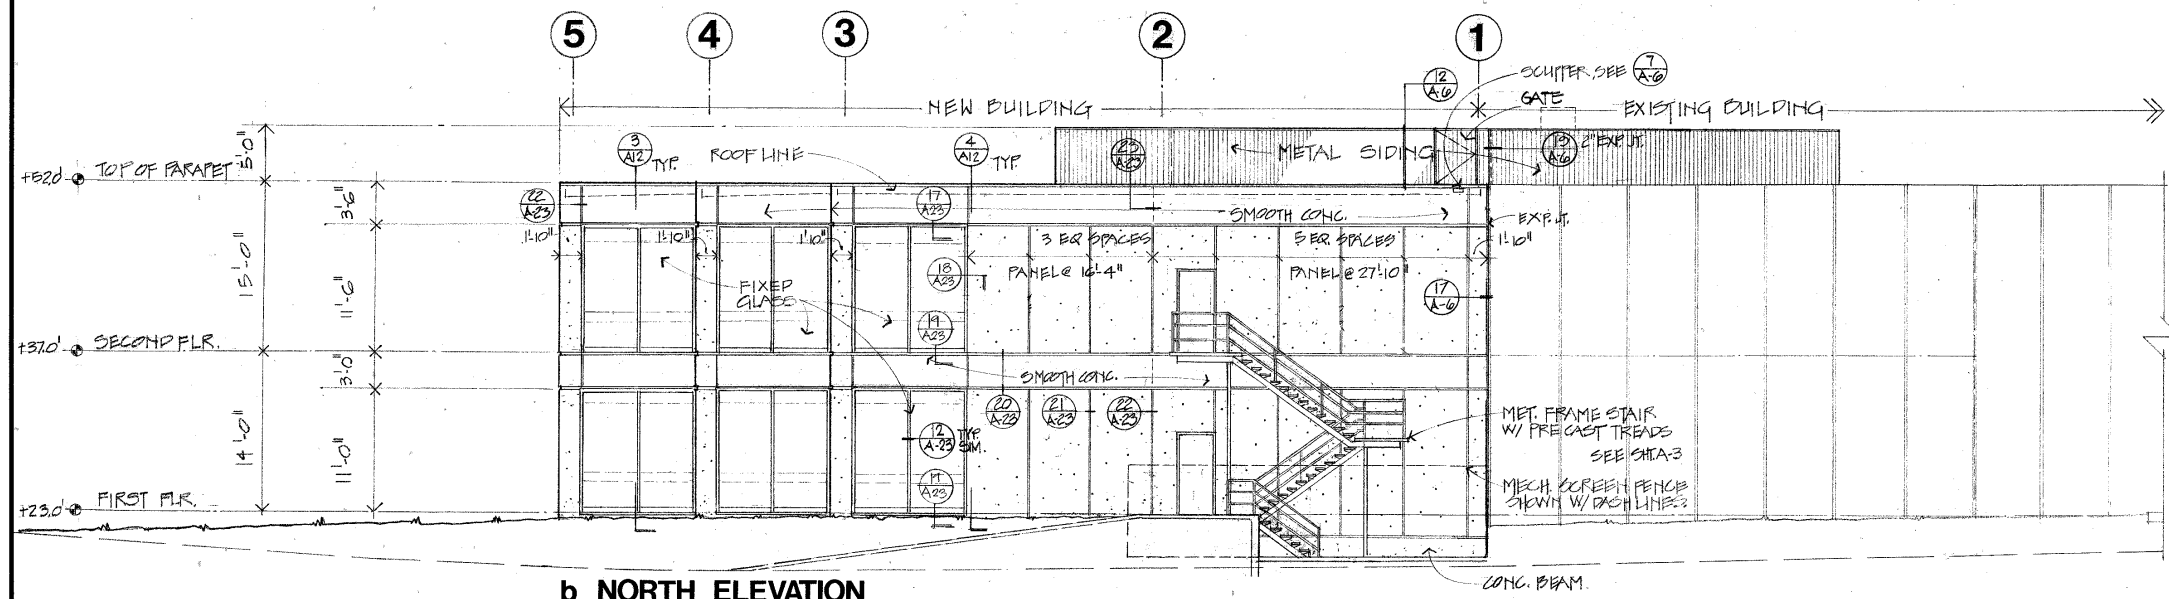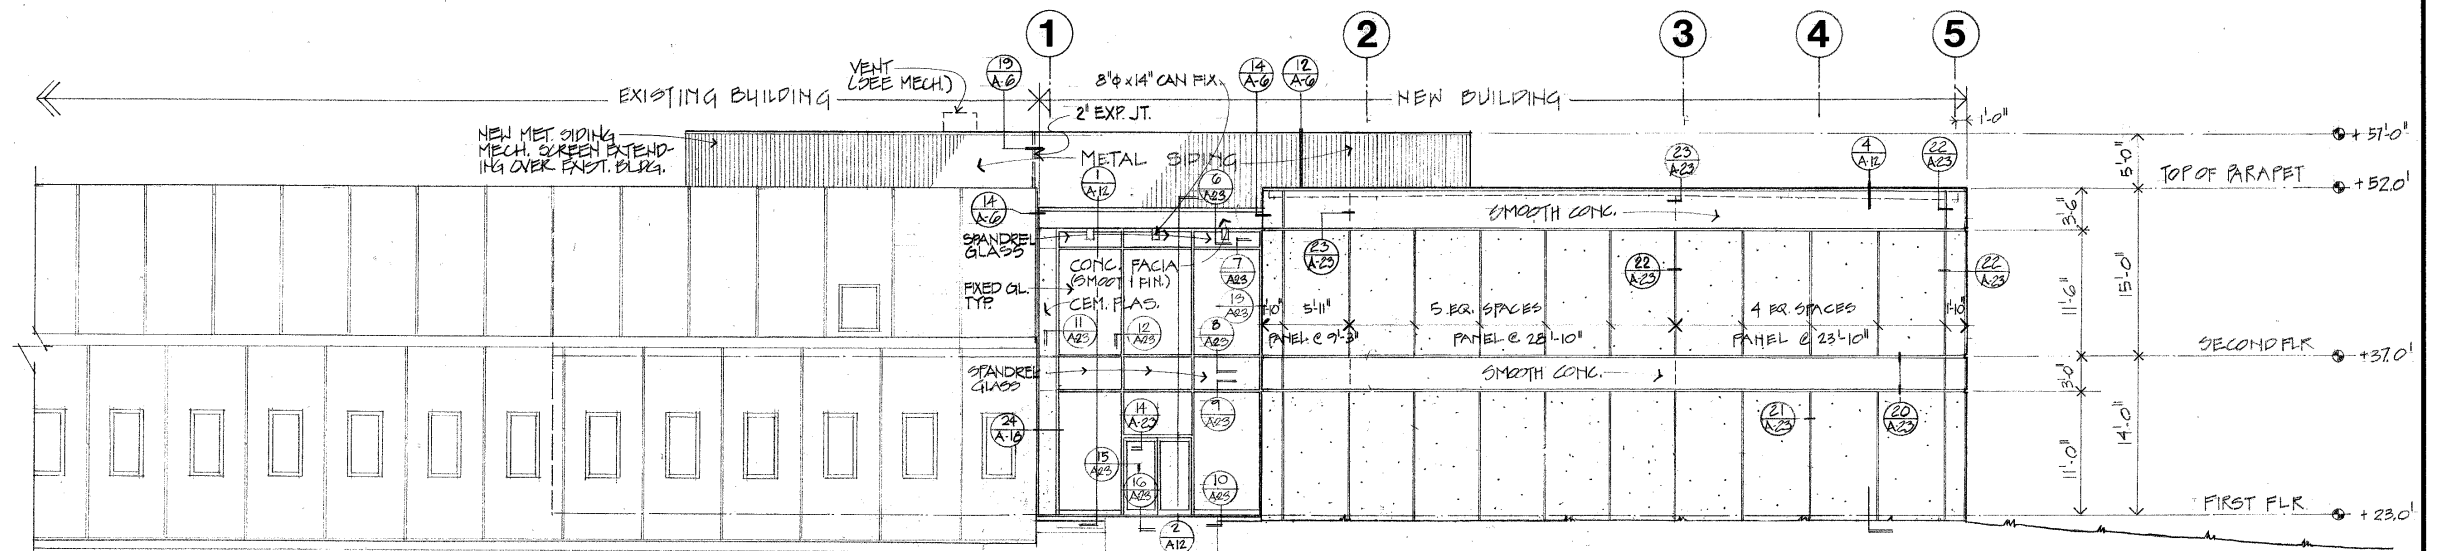

exterior elevations



4/2/82 AS-BUILT		AST	
LETTER	DATE	REVISION DESCRIPTION	DRAWN APP.
NATIONAL AERONAUTICS AND SPACE ADMINISTRATION AMES RESEARCH CENTER MOFFETT FIELD, CALIFORNIA			
LIFE SCIENCES FLIGHT EXPERIMENTS FACILITY (ADDITION TO BUILDING N-240) PROJECT NO. 2171			
DRAWN CPS		CHECKED RJB	INDEX 100
DESIGN ENGINEER CPS		MATERIAL BRANCH	
APPROVED PAUL L. BSE		ASSM. DWG. NO.	
JULY 1982		SCALE 1/8" = 1'-0"	
JULY 1982		A 240-7903 A-9	

Additional Images:


N-243: Flight and Guidance Simulation Laboratory




N-243 under construction, 4 October 1965
(Source: NASA Ames Research Center, A-35531)



N-243, Aerial photograph, 5 July 1977
(Source: NASA Ames Research Center, AC77-0846-40)

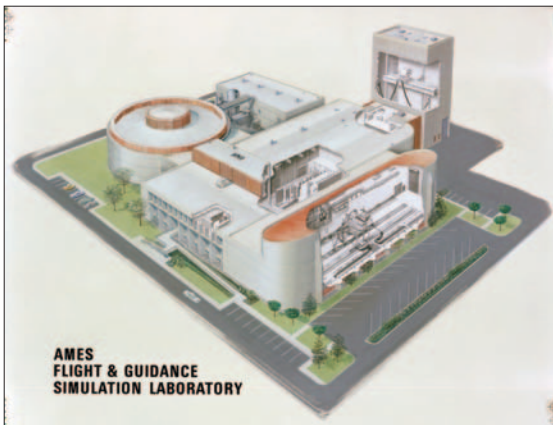


N-243, Diagram of Flight and Guidance Simulation Laboratory, 25 January 1978
(Source: NASA Ames Research Center, AC78-0070)

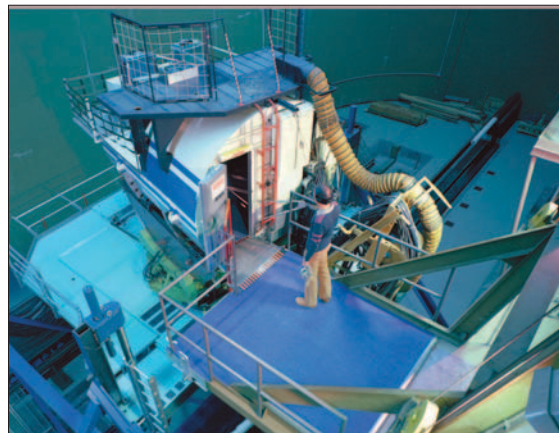


N-243, FSAA Flight Simulator for Advanced Aircraft, 7 March 1989
(Source: NASA Ames Research Center, AC79-0198-11)



N-243, VMS R-Cab: Civil Tiltrotor Simulation
Software Screen, 1 December 1994
(Source: NASA Ames Research Center,
AC94-0503-7)

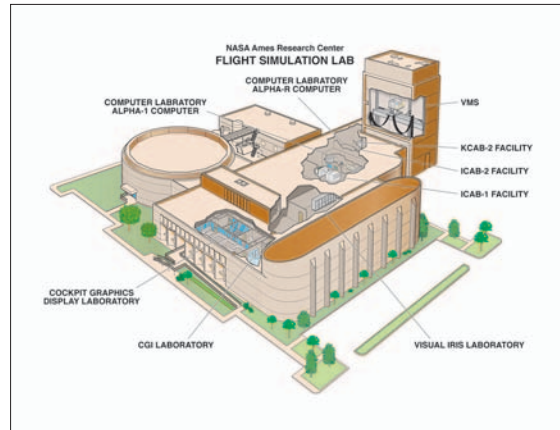

N-243, Diagram of Flight and Guidance Simu-
lation Laboratory, July 1998
(Source: NASA Ames Research Center,
ACD98-0142)

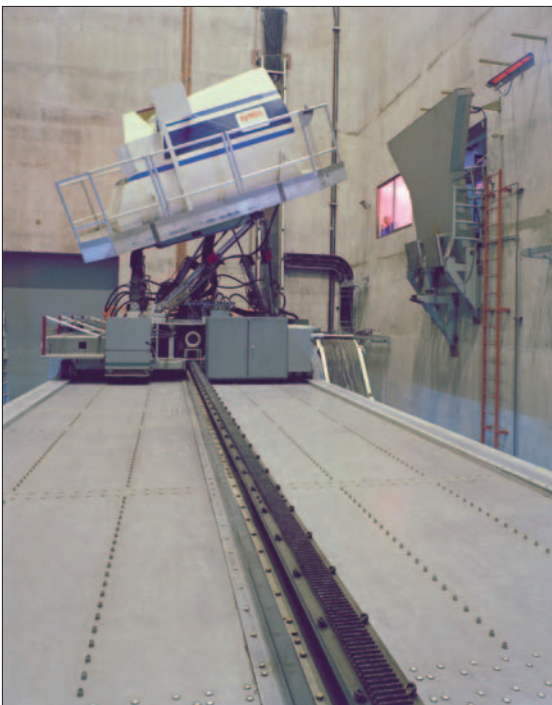

N-243, Vertical Motion Simulator,
9 February 1979
(Source: NASA Ames Research Center,
AC79-0126-3)



N-243, Vertical Motion Simulator cab in motion,
24 October 1997
(Source: NASA Ames Research Center,
AC97-0375-1)



**N-243, south facade, east end
(Source: Page & Turnbull)**



**N-243, north facade, centrifuge
(Source: Page & Turnbull)**




**N-243, east facade, tower
(Source: Page & Turnbull)**



**N-243, interior, FSAA high-bay
(Source: Page & Turnbull)**



**N-243, Vertical Motion Simulator
(Source: Page & Turnbull)**

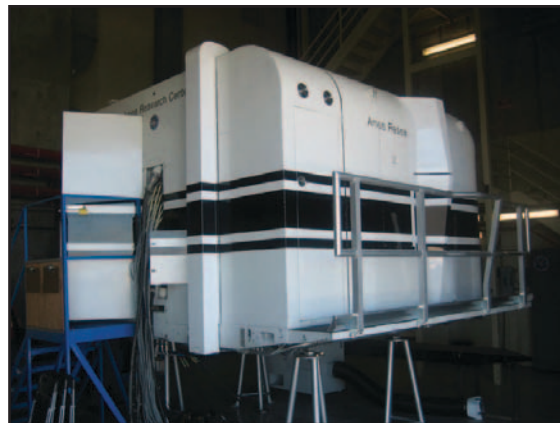

**N-243, simulation cab
(Source: Page & Turnbull)**



**N-243, simulation cab, interior
(Source: Page & Turnbull)**

Architectural Drawings for N-243

Space Flight Guidance Research Facility, Flight Simulator for Advanced Aircraft, Basement Flr Plan

Architect: Skidmore, Owings & Merrill

Date: n.d.

Sheet: N/A

NASA EDC # 243-5603-A2

Space Flight Guidance Research Facility, Flight Simulator for Advanced Aircraft, Ground and First Floor Plan

Architect: Skidmore, Owings & Merrill

Date: n.d.

Sheet: N/A

NASA EDC # 243-5603-A3

Space Flight Guidance Research Facility, Flight Simulator for Advanced Aircraft, Second Floor Plan

Architect: Skidmore, Owings & Merrill

Date: n.d.

Sheet: N/A

NASA EDC # 243-5603-A4

Space Flight Guidance Research Facility, Motion Generator, Plot Plan & Drawing Index

Architect: N/A

Date: 19 June 1979

Sheet: A 12370- D1A

NASA EDC # 243-6301-A1

Space Flight Guidance Research Facility, Elevations

Architect: Skidmore, Owings & Merrill

Date: 5 April 1965

Sheet: A 12486-A10

NASA EDC # 243-6401-A10

Space Flight Guidance Research Facility, Elevations

Architect: Skidmore, Owings & Merrill

Date: 5 April 1965

Sheet: A 12486-A10

NASA EDC # 243-6401-A10

Space Flight Guidance Research Facility, Building Sections

Architect: Skidmore, Owings & Merrill

Date: 5 April 1965

Sheet: A 12486-A11

NASA EDC # 243-6401-A11

Space Flight Guidance Research Facility, Building Sections

Architect: Skidmore, Owings & Merrill

Date: 5 April 1965

Sheet: A 12486-A12

NASA EDC # 243-6401-A12

Space Flight Guidance Research Facility, Building Sections

Architect: Skidmore, Owings & Merrill

Date: 5 April 1965

Sheet: A 12486-A13

NASA EDC # 243-6401-A13

Addition to Building N-243 Vertical Motion Simulator Building, Exterior Elevations, Details

Architect: Anshen & Allen, Architects/Planners

Date: 28 February 1975

Sheet: A243-02-A5

NASA EDC # 243-7502-A5

Addition to Building N-243 Vertical Motion Simulator Building, Exterior Elevations, Details

Architect: Anshen & Allen, Architects/Planners

Date: 28 February 1975

Sheet: A243-02-A6

NASA EDC # 243-7502-A6




Addition to Building N-243 Vertical Motion Simulator Building, Sections, Seismic Details

Architect: Anshen & Allen, Architects/Planners

Date: 28 February 1975

Sheet: A243-02-A7

NASA EDC # 243-7502-A7

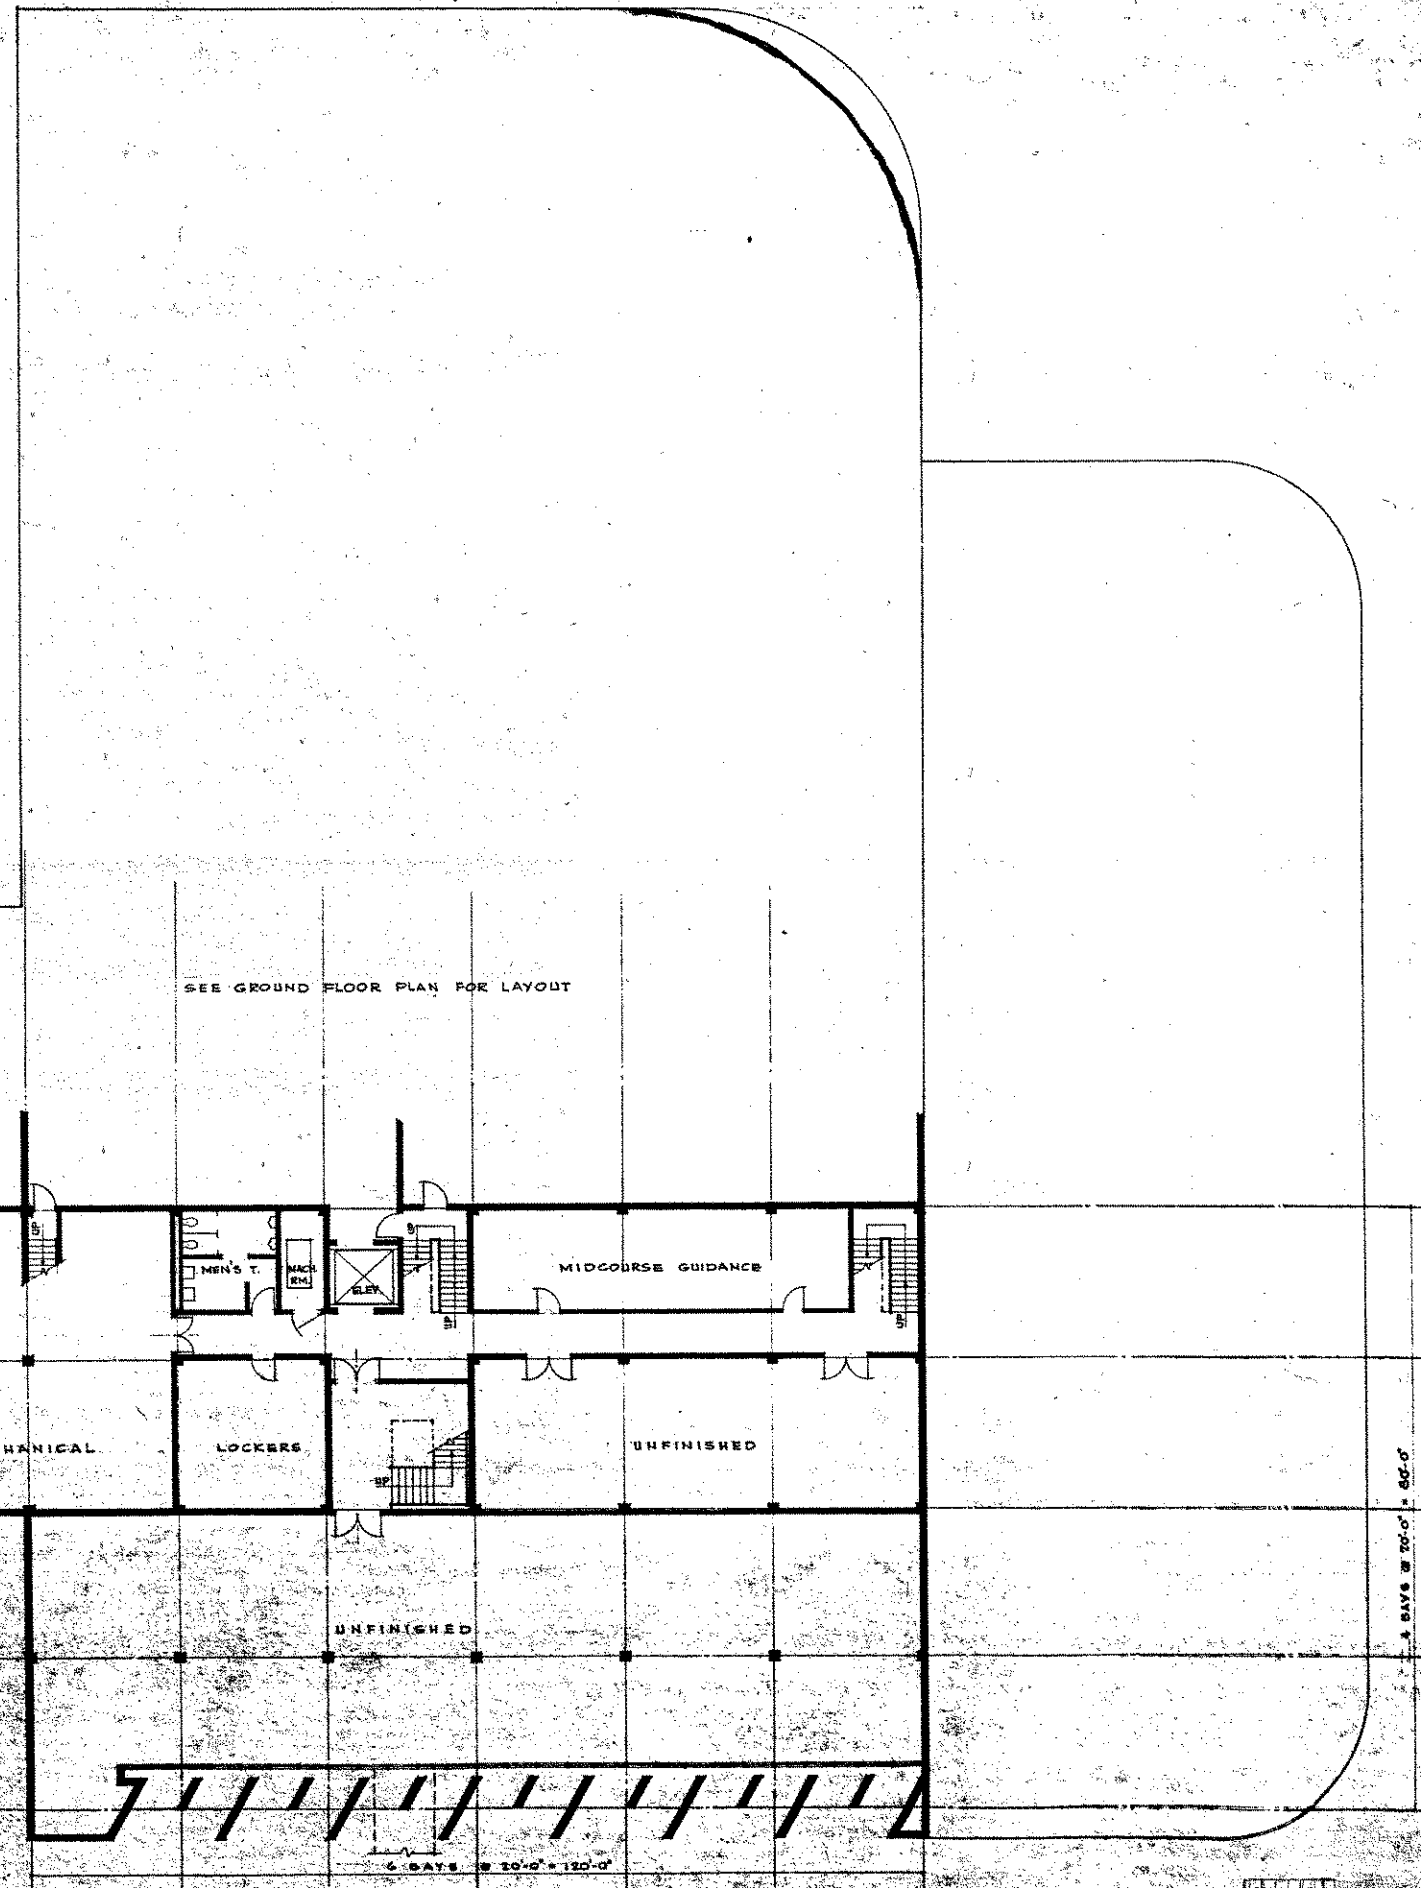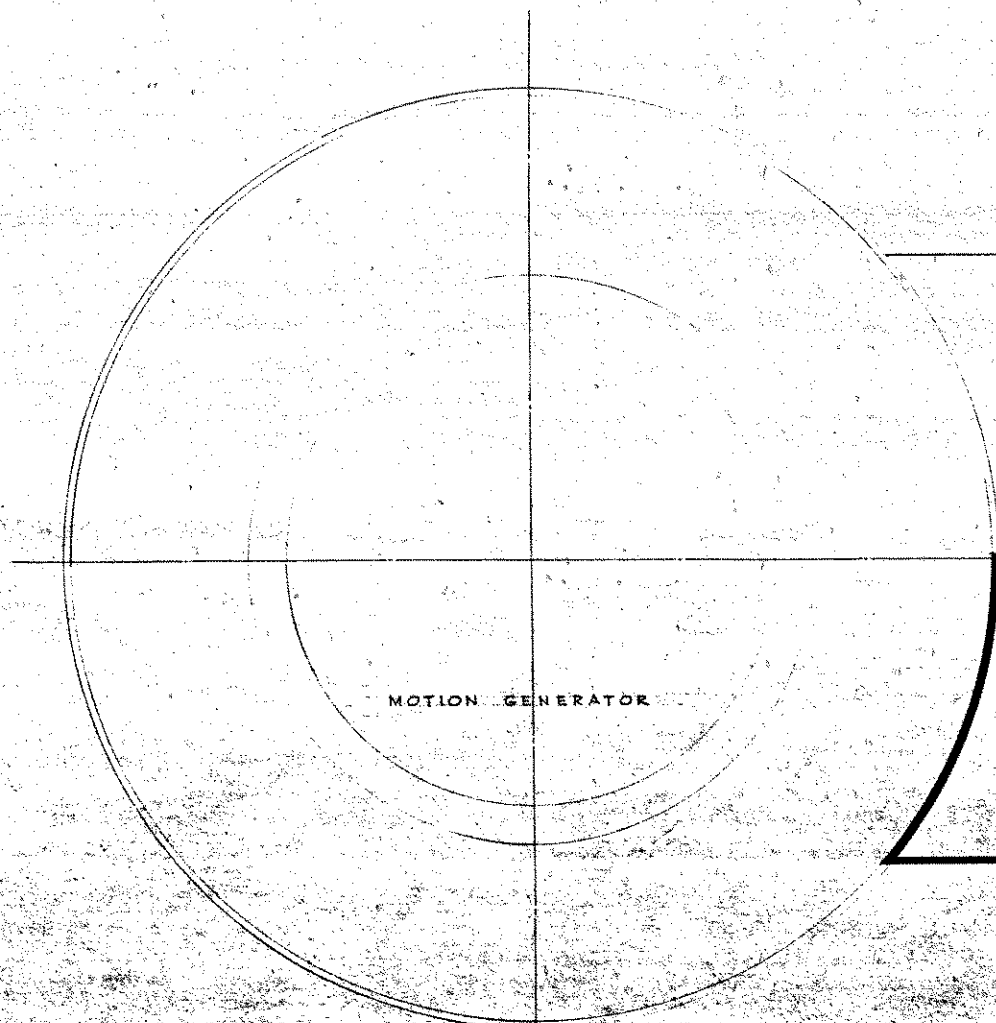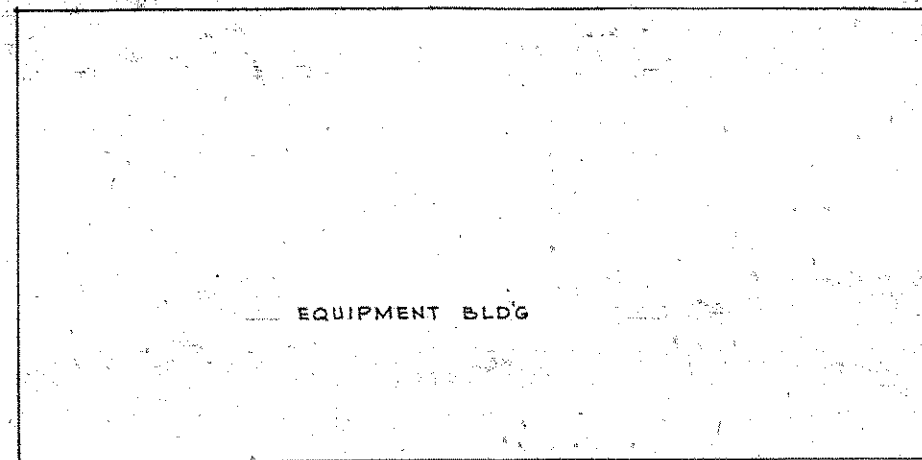


BASEMENT FLOOR PLAN SCALE 1"=10'-0"
SPACE FLIGHT GUIDANCE RESEARCH FACILITY
FLIGHT SIMULATOR FOR ADVANCED AIRCRAFT
NASA
SKIDMORE, OWINGS & MERRILL ARCHITECTS
AMES RESEARCH CENTER


243-8403-A2
BASEMENT FLOOR PLAN

DATE: MAY 1964 DRAWN BY: J. HENDERSON

12/15/64
12/15/64



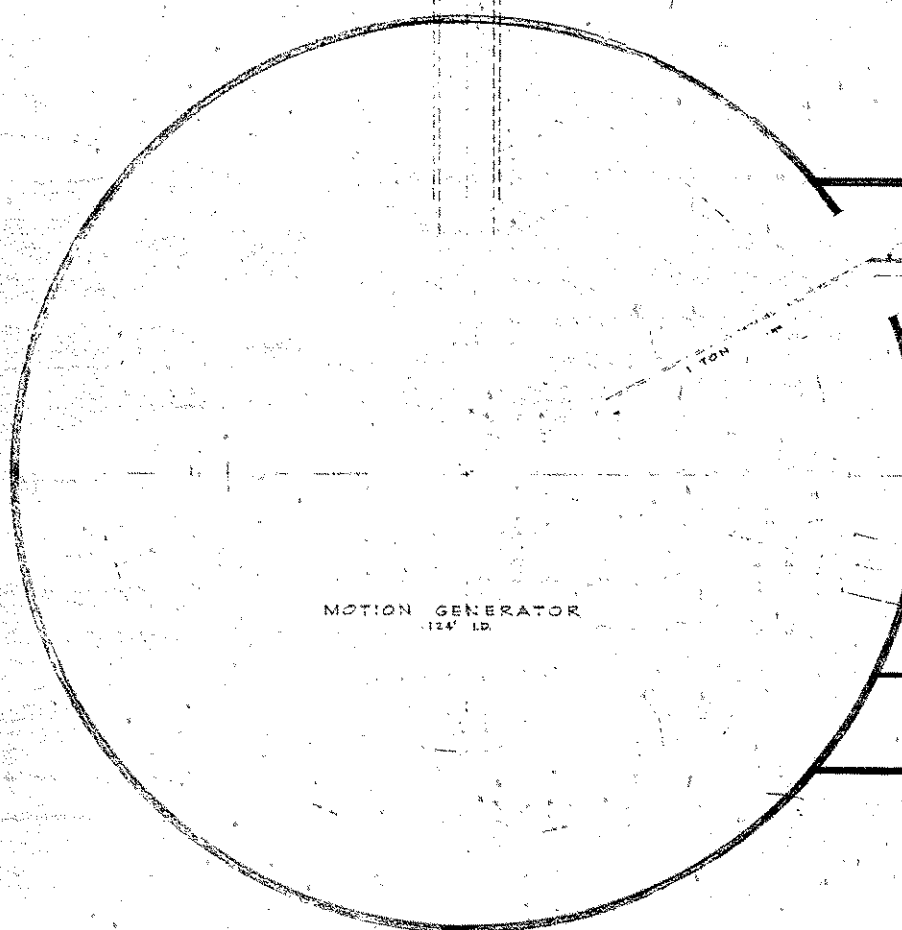


SPACE FLIGHT GUIDANCE RESEARCH FACILITY
FLIGHT SIMULATOR FOR ADVANCED AIRCRAFT
NASA AMES RESEARCH CENTER
SKIDMORE OWINGS & MERRILL ARCHITECTS

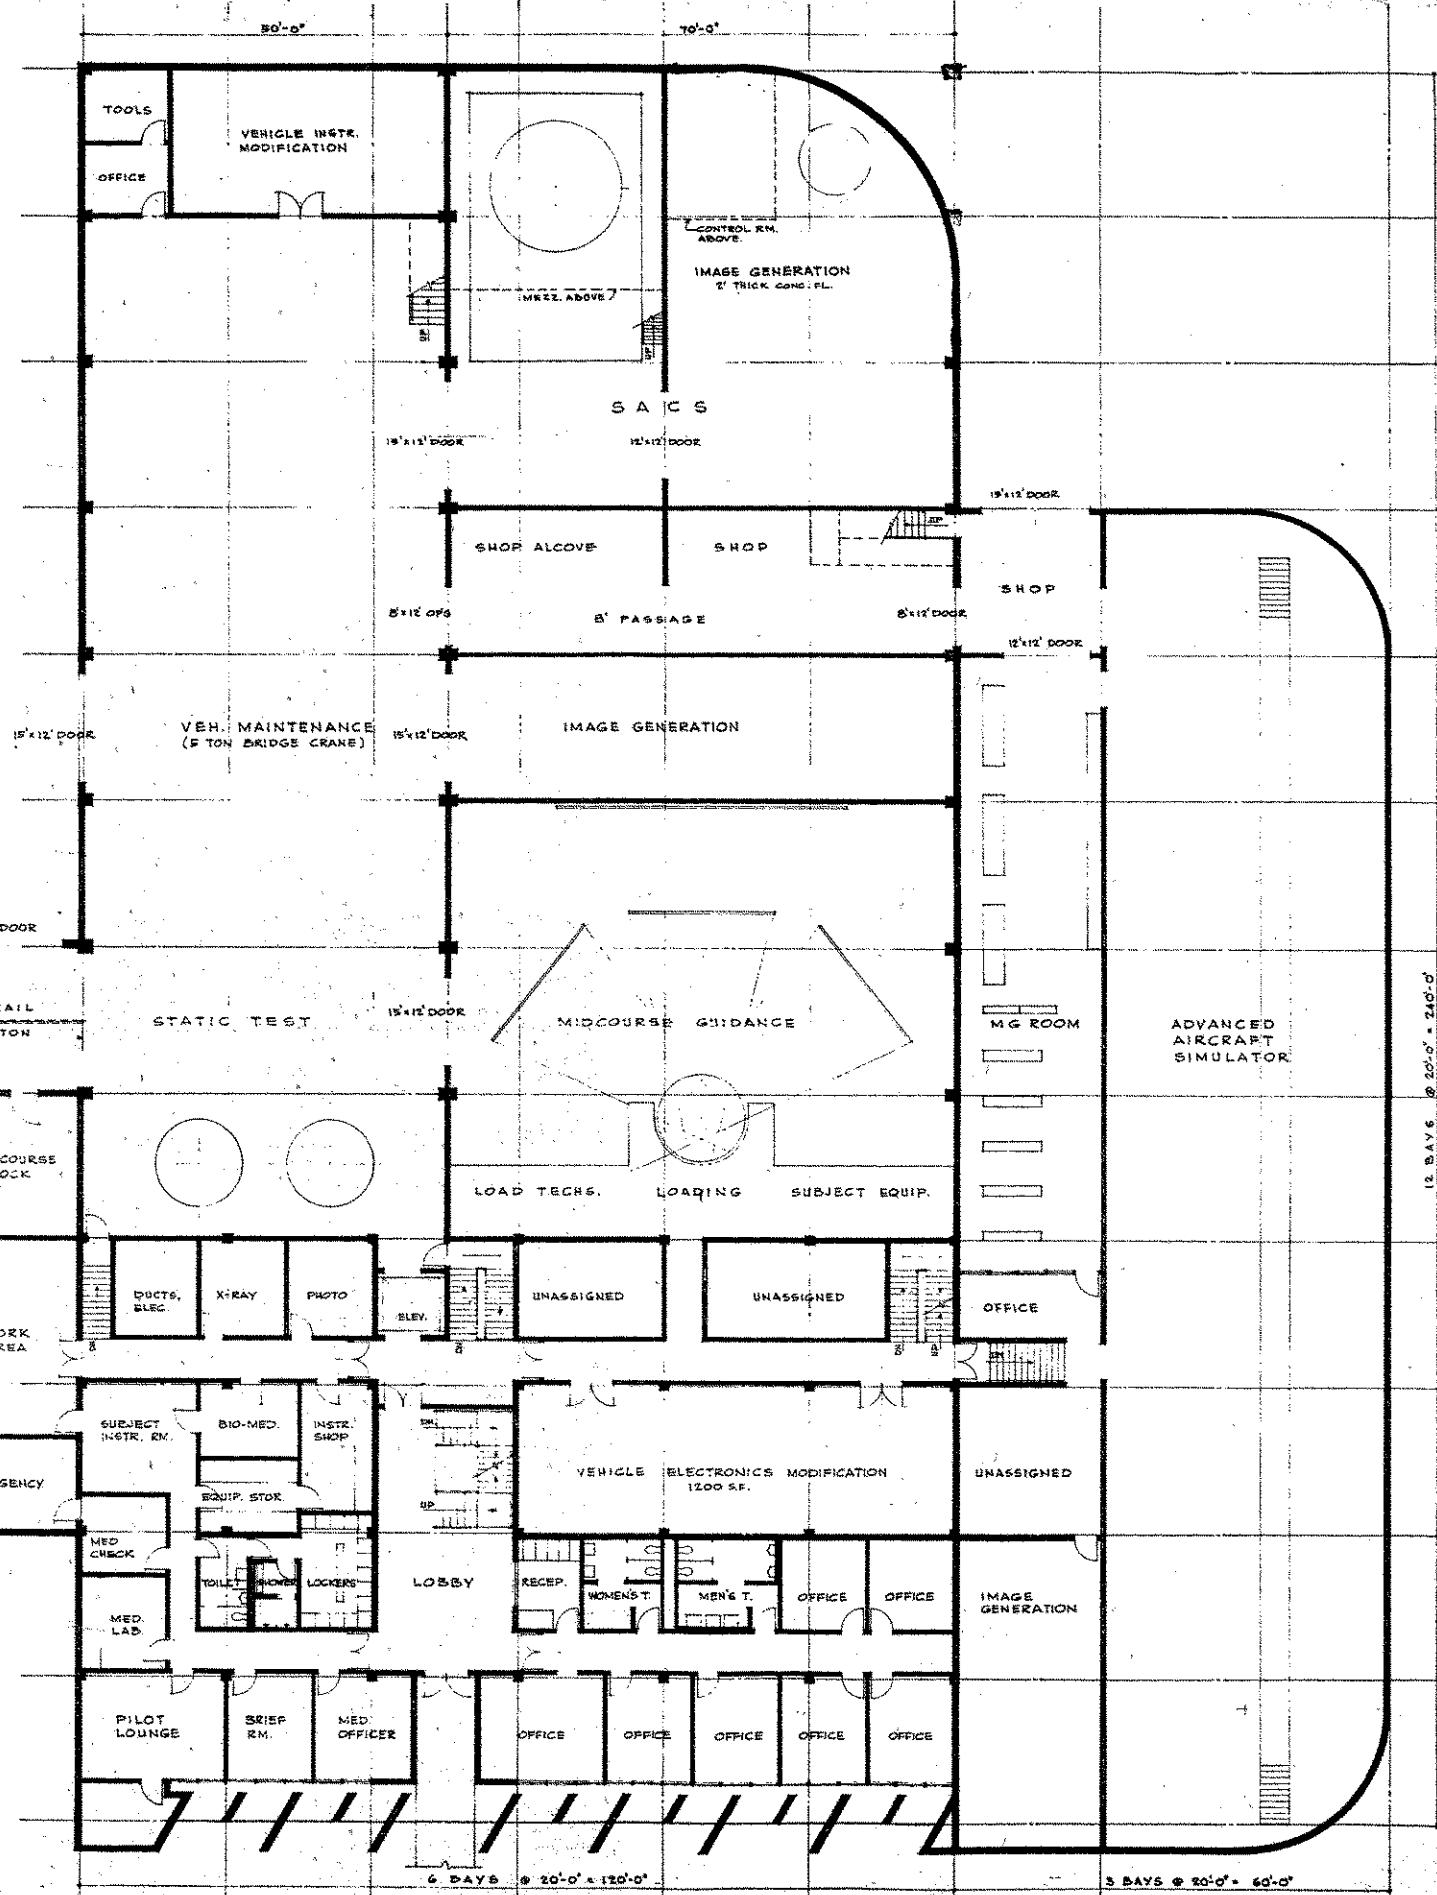


243-5603-A3	
GROUND & FIRST FLOOR	

243 5603A

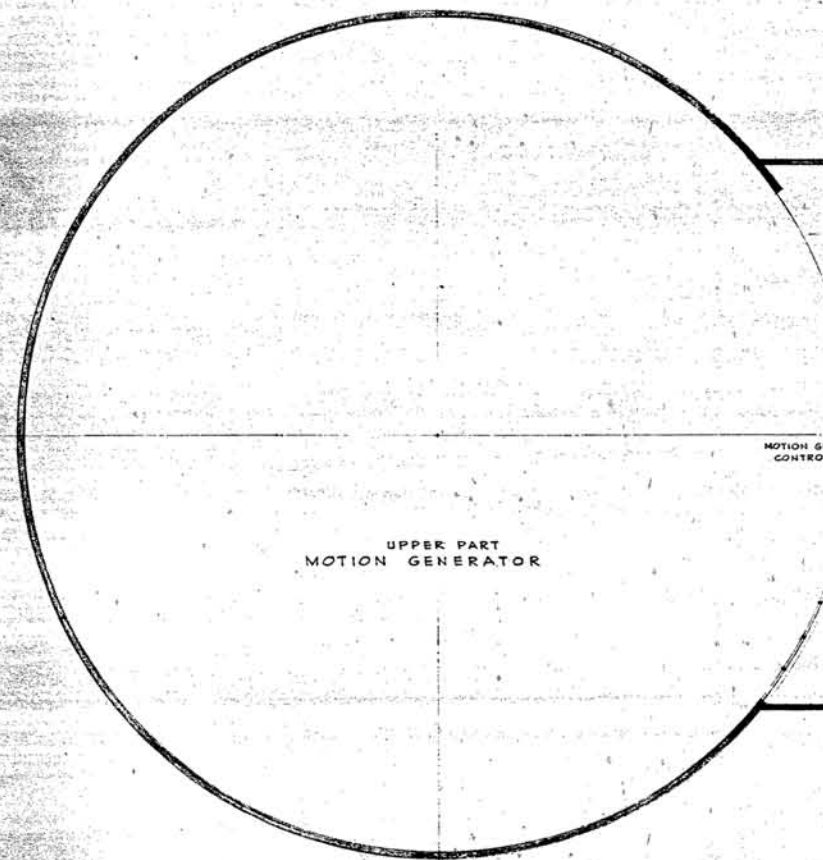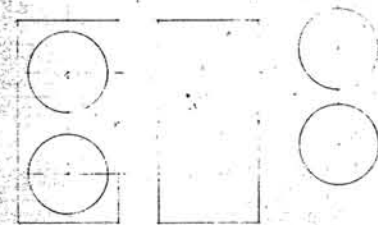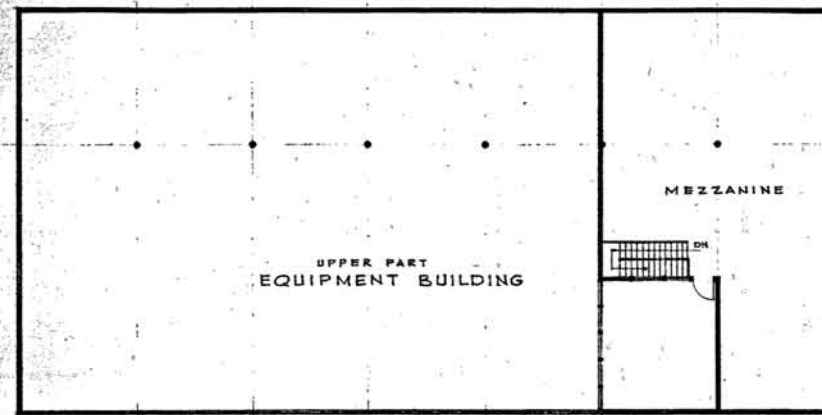

SECOND FLOOR PLAN SCALE 1" = 1'-0"


SPACE FLIGHT GUIDANCE RESEARCH FACILITY
FLIGHT SIMULATOR FOR ADVANCED AIRCRAFT
NASA
SKIDMORE, OWINGS & MERRILL
AMES RESEARCH CENTER
ARCHITECTS

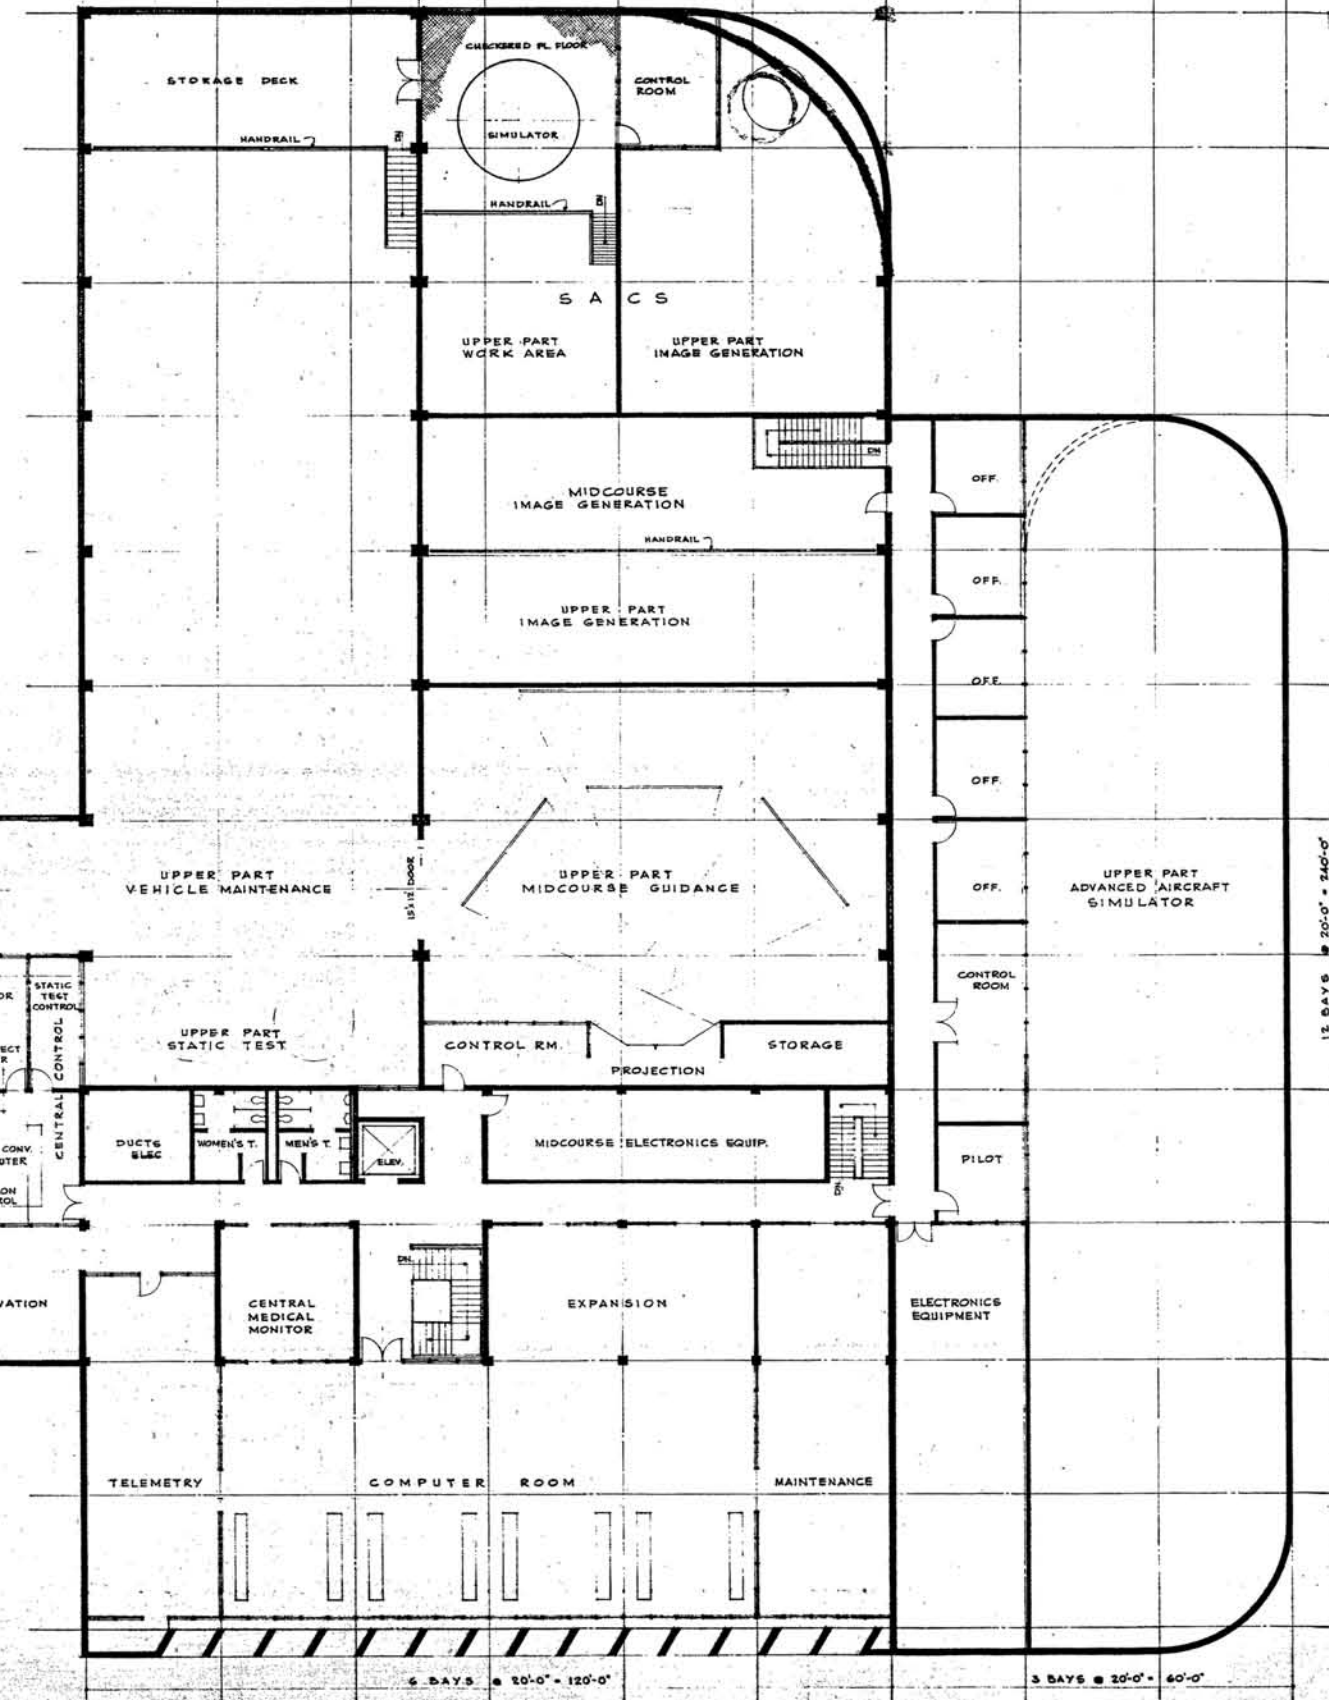


243-5603-A4
SECOND FLOOR PLAN

243-5603-A4

4 AUG 26

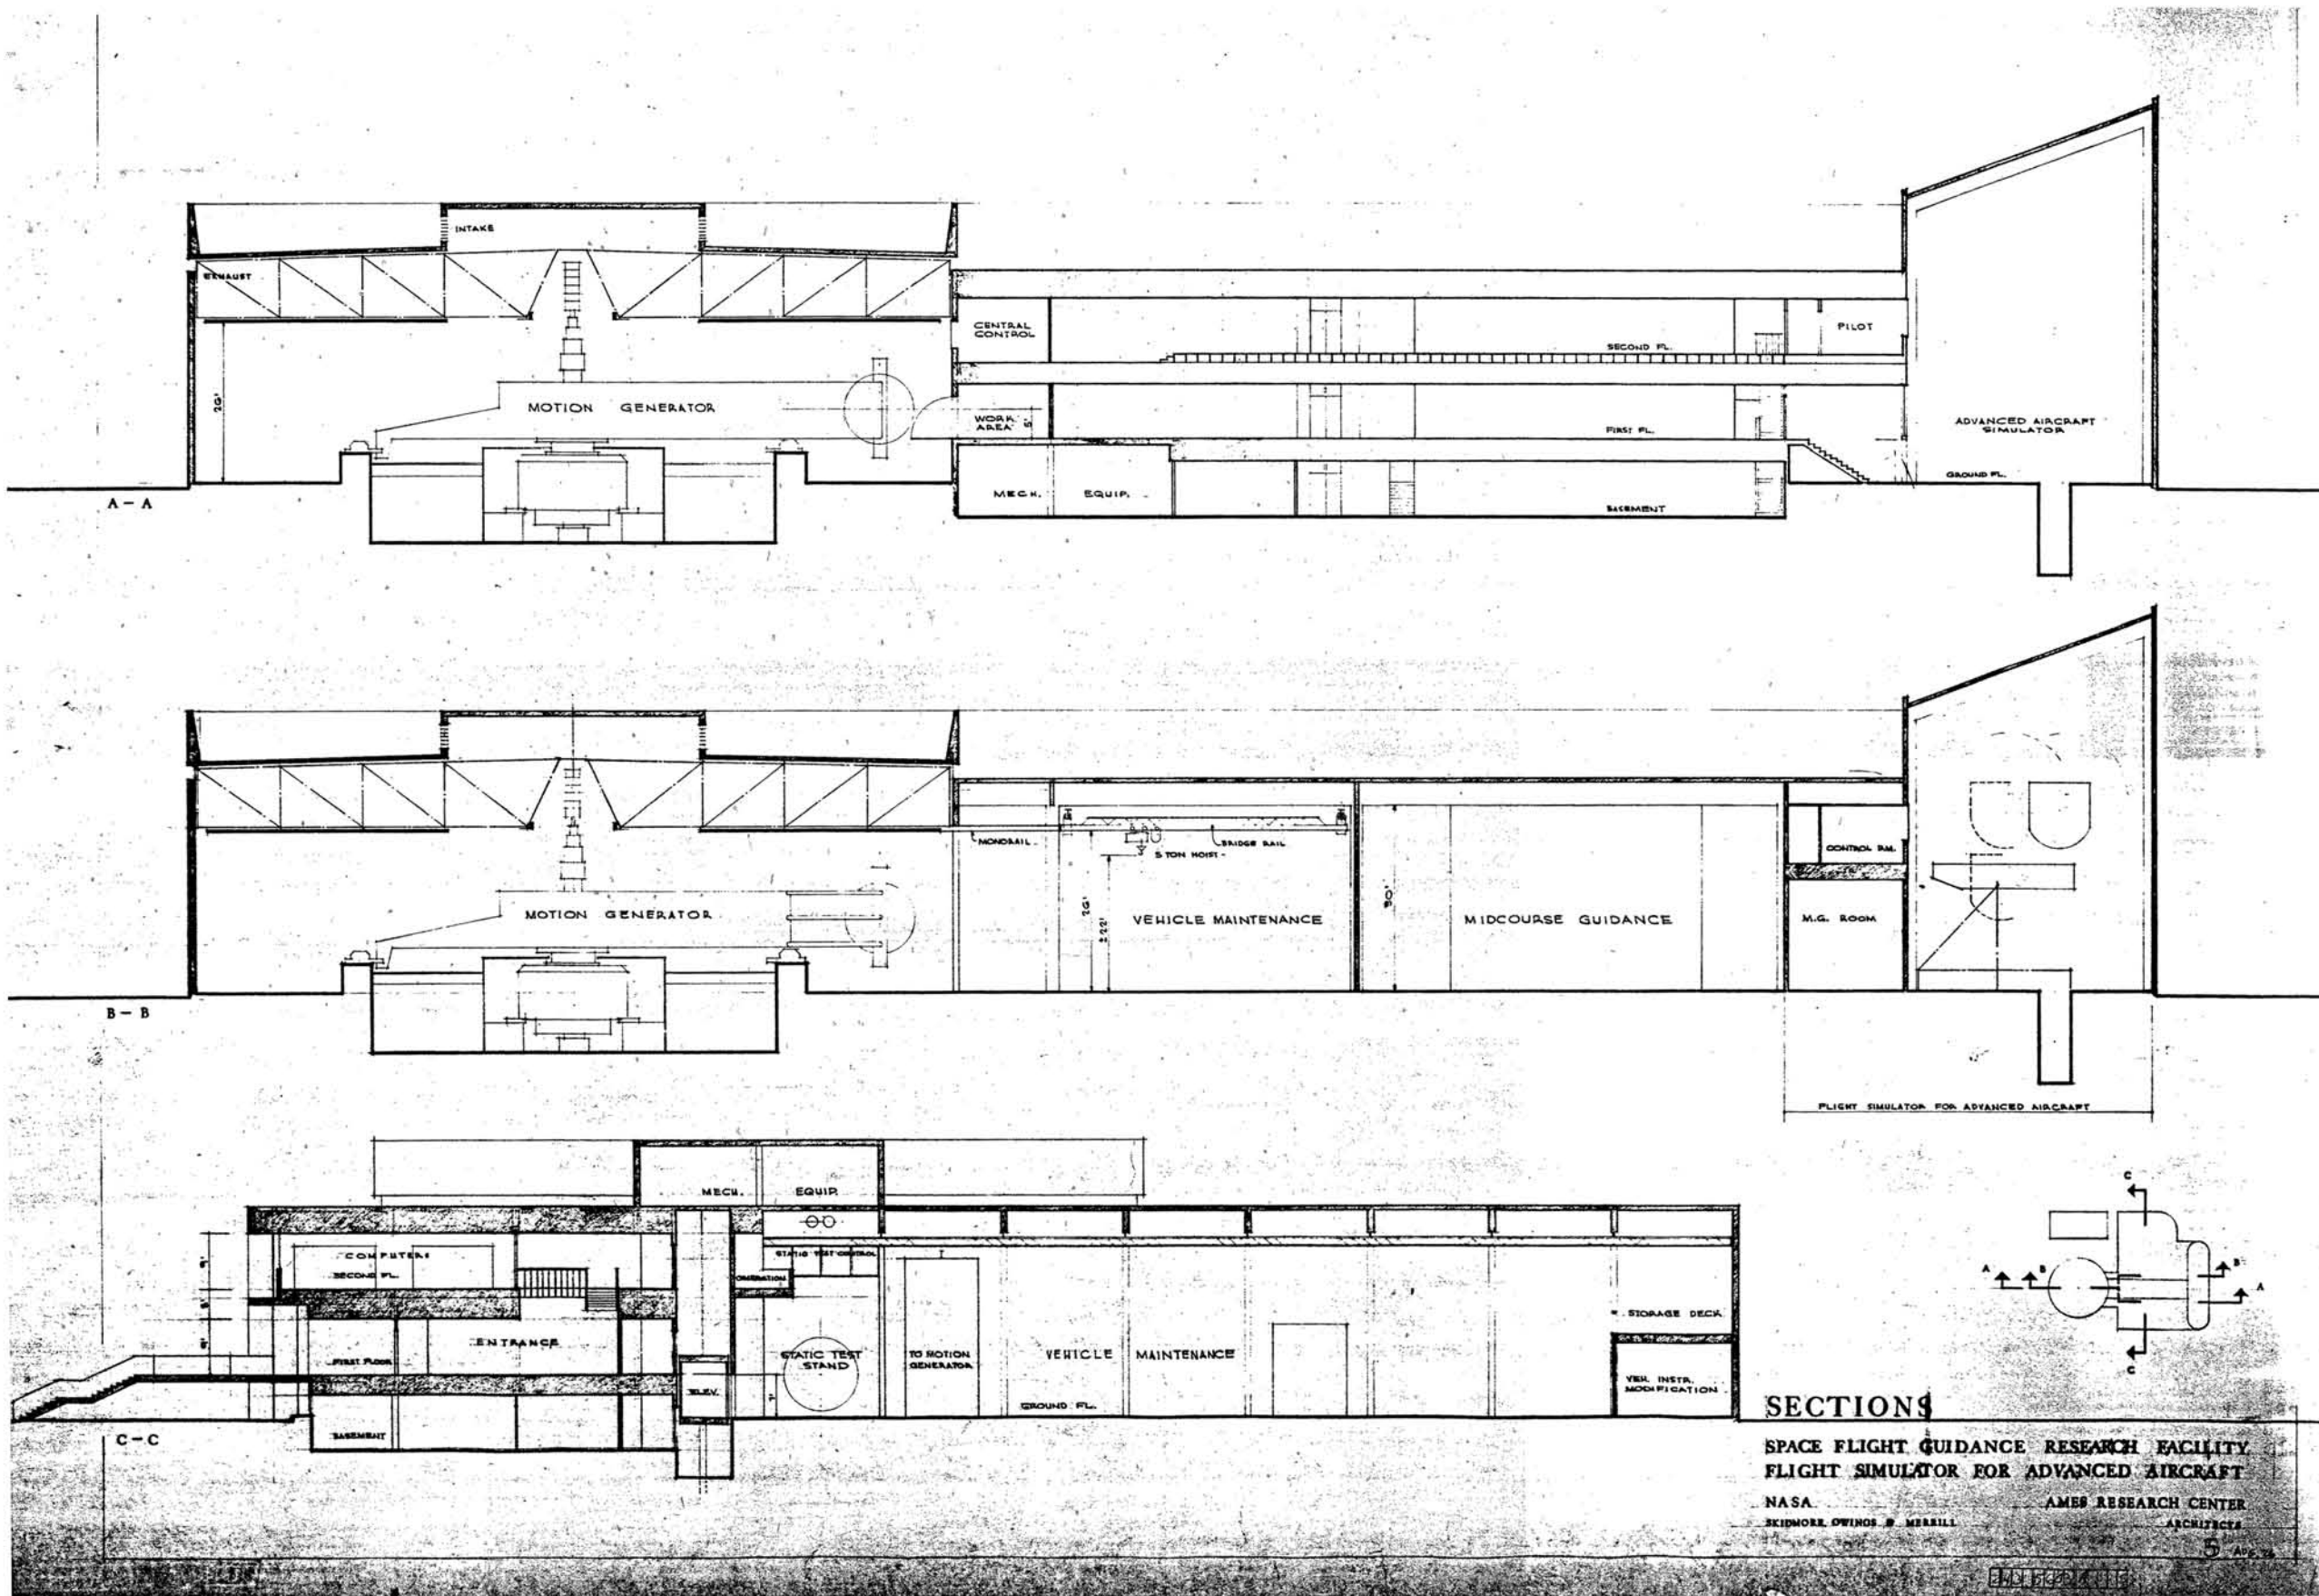

248-5403-A5
SECTIONS

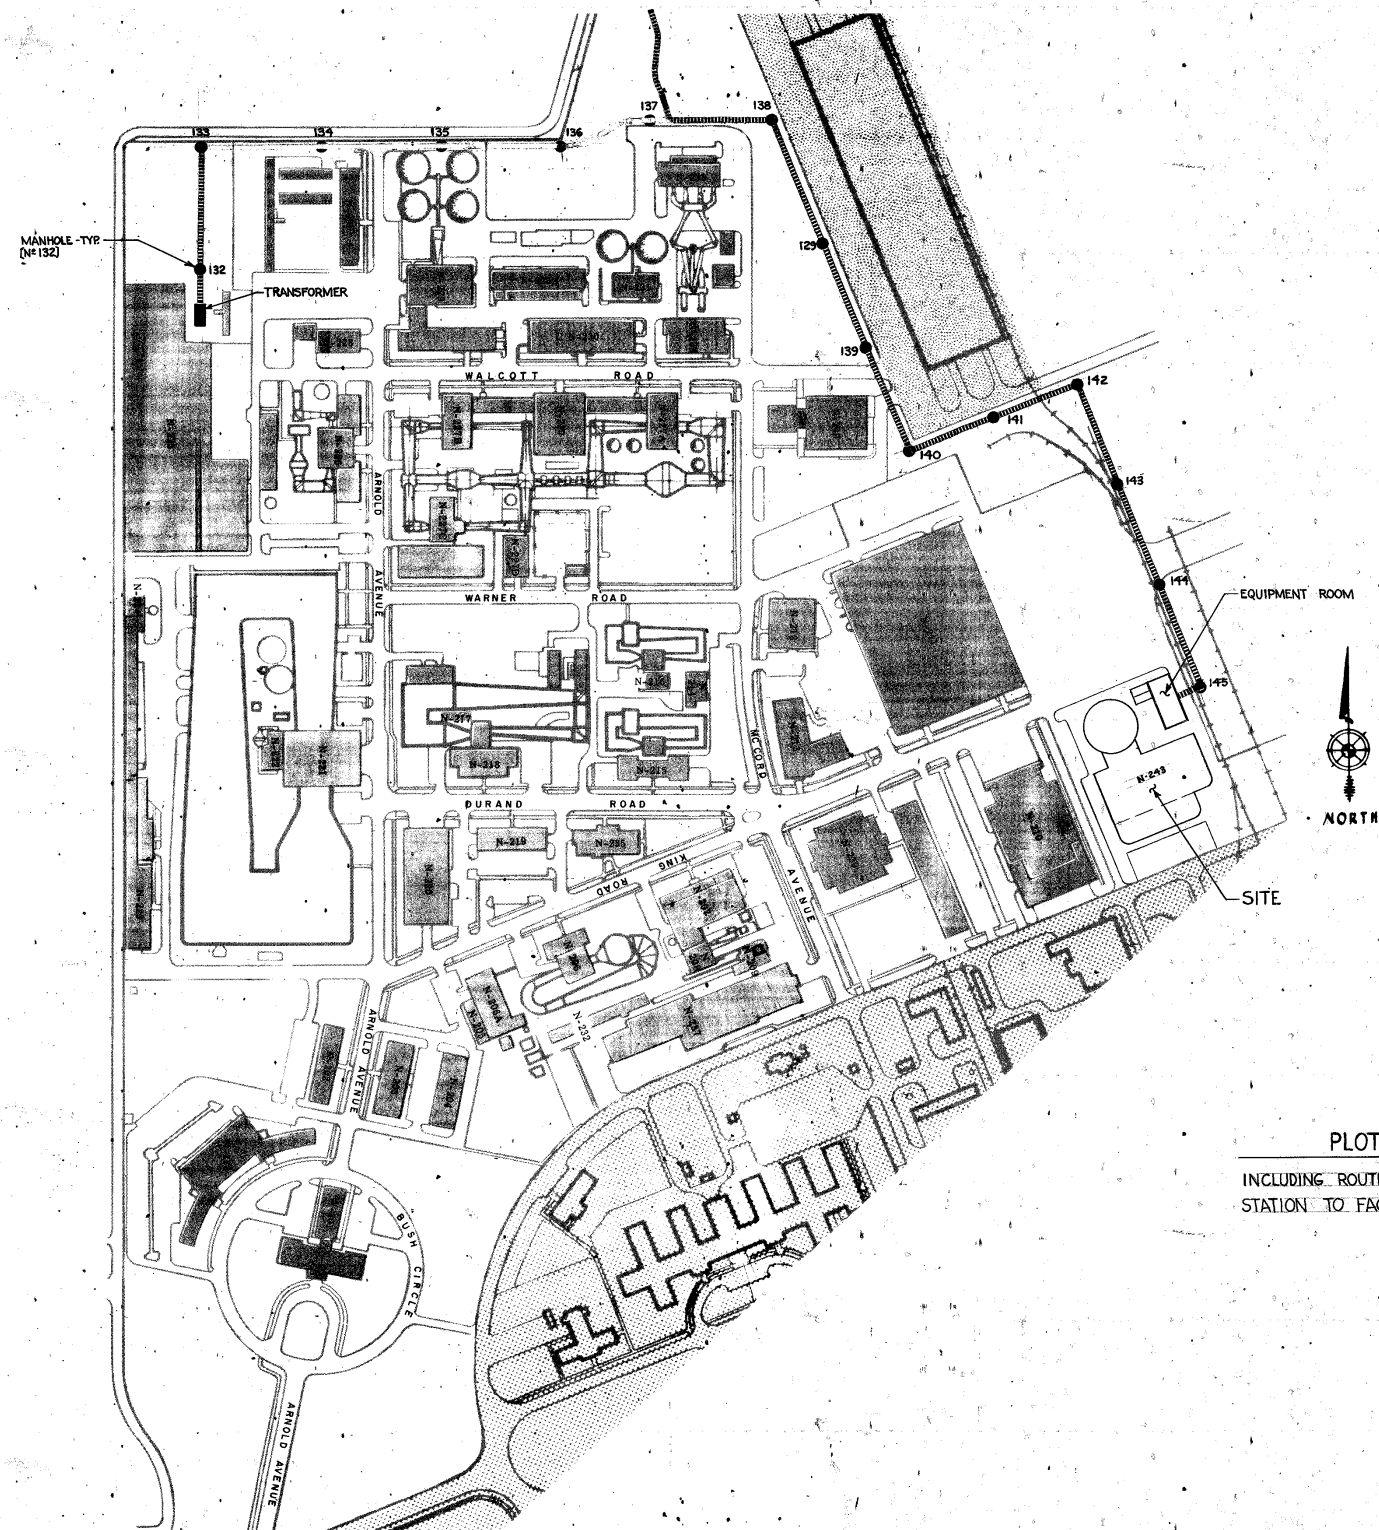


ACTION GENERATOR DRAWING LIST

- A12370-D1 PLOT PLAN & DRAWING INDEX
- D2 CAPSULE GEOMETRY
- D3 VIBRATION ENVELOPE
- D4 VELOCITY LIMITING BOUNDARY CONDITIONS
- D5 ENVIRONMENTAL SYSTEMS CONTROL & LOCATION
- D6 ELECTRICAL ONE-LINE DIAGRAM
- D7 110 K.V. SUBSTATION LAYOUT


LETTER	DATE	REVISION DESCRIPTION	W.W.	APR
A	2-19-65	REDRAWN - RELOCATED DUCT RUNS AND MANHOLES		
NATIONAL AERONAUTICS AND SPACE ADMINISTRATION AMES RESEARCH CENTER MOFFETT FIELD, CALIFORNIA				
SPACE FLIGHT GUIDANCE RESEARCH FACILITY ACTION GENERATOR PLOT PLAN & DRAWING INDEX				
DRAWN	CHECKED	INDEX	MATERIAL	LIMITS UNLESS NOTED
M.B. & W.W.				
DESIGN ENGINEER	BRANCH	RECE.	PRAC.	DEC.
APPROVED	ASSN. DWS. NO.			
APPROVED	SCALE	NOTED		
A12370-D1				A

A12370-D1A


243 6301A

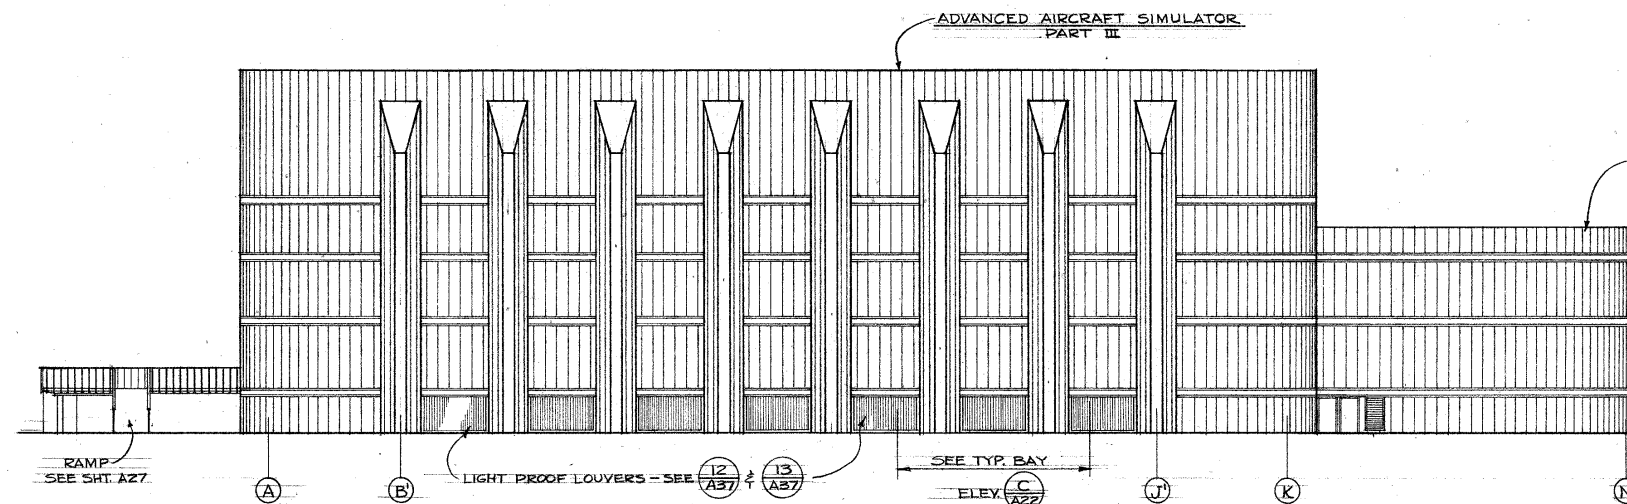


(E) SOUTH ELEVATION

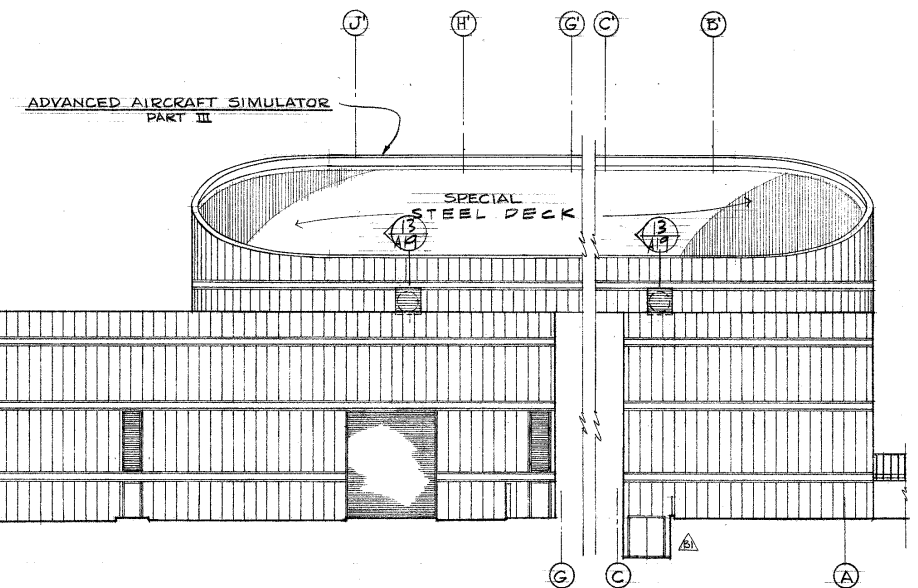

(G) NORTH ELEVATION

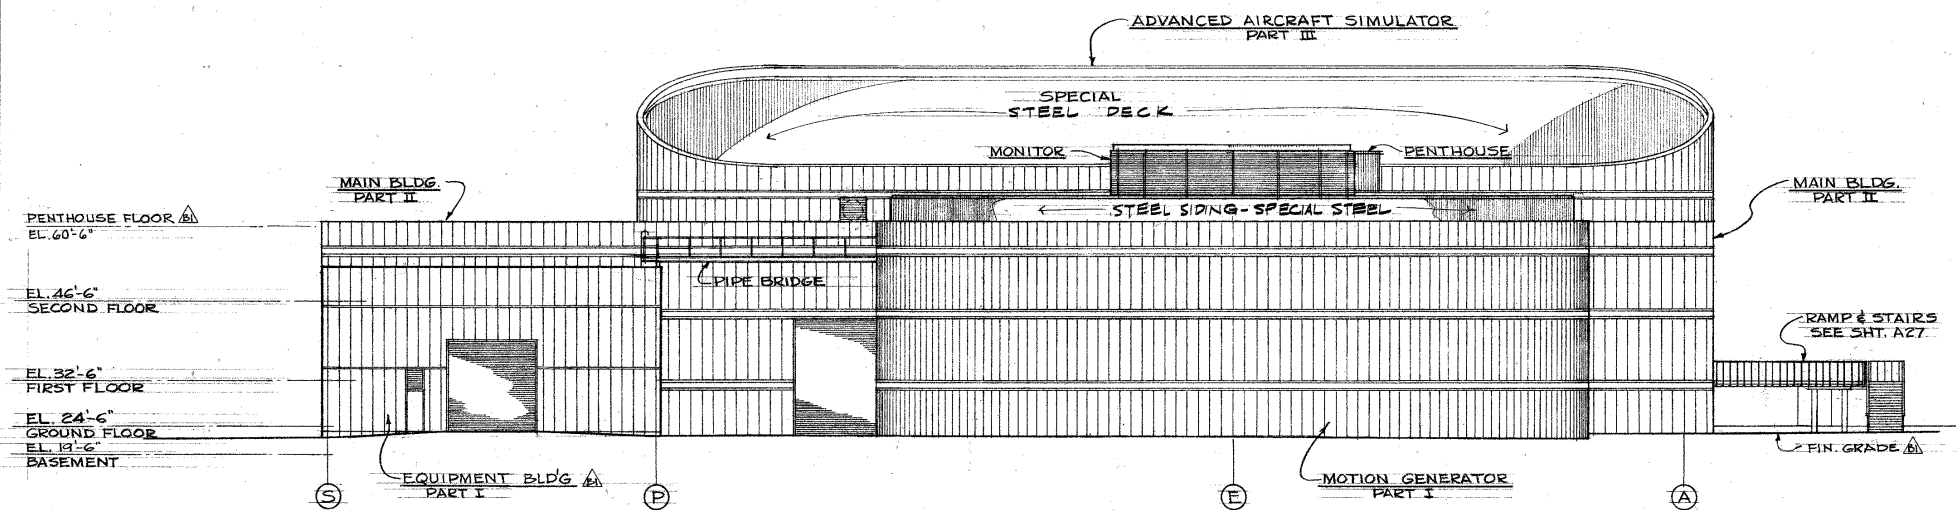


(F) NORTH ELEVATION

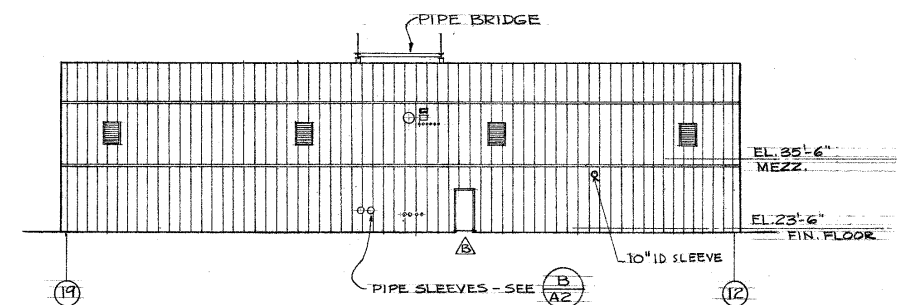

(H) WEST ELEVATION


NOTES -
1. ALL EXTERIOR CONCRETE WALL SURFACES TO HAVE SAND BLASTED FINISH.
2. SEE SHEET A22 FOR TYPICAL EXTERIOR CONCRETE FORMING DETAILS.

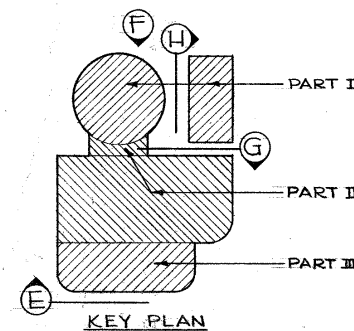


SKIDMORE, OWINGS & MERRILL
ARCHITECTS
ONE BUSH STREET, SAN FRANCISCO, CALIFORNIA
APPROVED FOR THE ARCHITECTS
13470
APR 5 1965

LETTER	DATE	REVISIONS PER APPENDUM	REVISION DESCRIPTION	CM	CM	APR
A	5-17-65	COORDINATION REVISIONS		CM		
B	5-7-65	REVISIONS PER APPENDUM		CM		
NATIONAL AERONAUTICS AND SPACE ADMINISTRATION						
AMES RESEARCH CENTER						
MOFFETT FIELD, CALIFORNIA						
SPACE FLIGHT GUIDANCE RESEARCH FACILITY						
ELEVATIONS						
DRAWN V B	CHECKED M	INDEX PVE	MATERIAL	LIMITS UNLESS NOTED		
DESIGN ENGINEER	BRANCH	BRANCH			PRAC	DEL
APPROVED J. O. Merrill	ASCM DWG. NO.	SCALE 1/8" = 1'-0"				
APPROVED						
A 12486 AIO				B1		


243-6401A-110

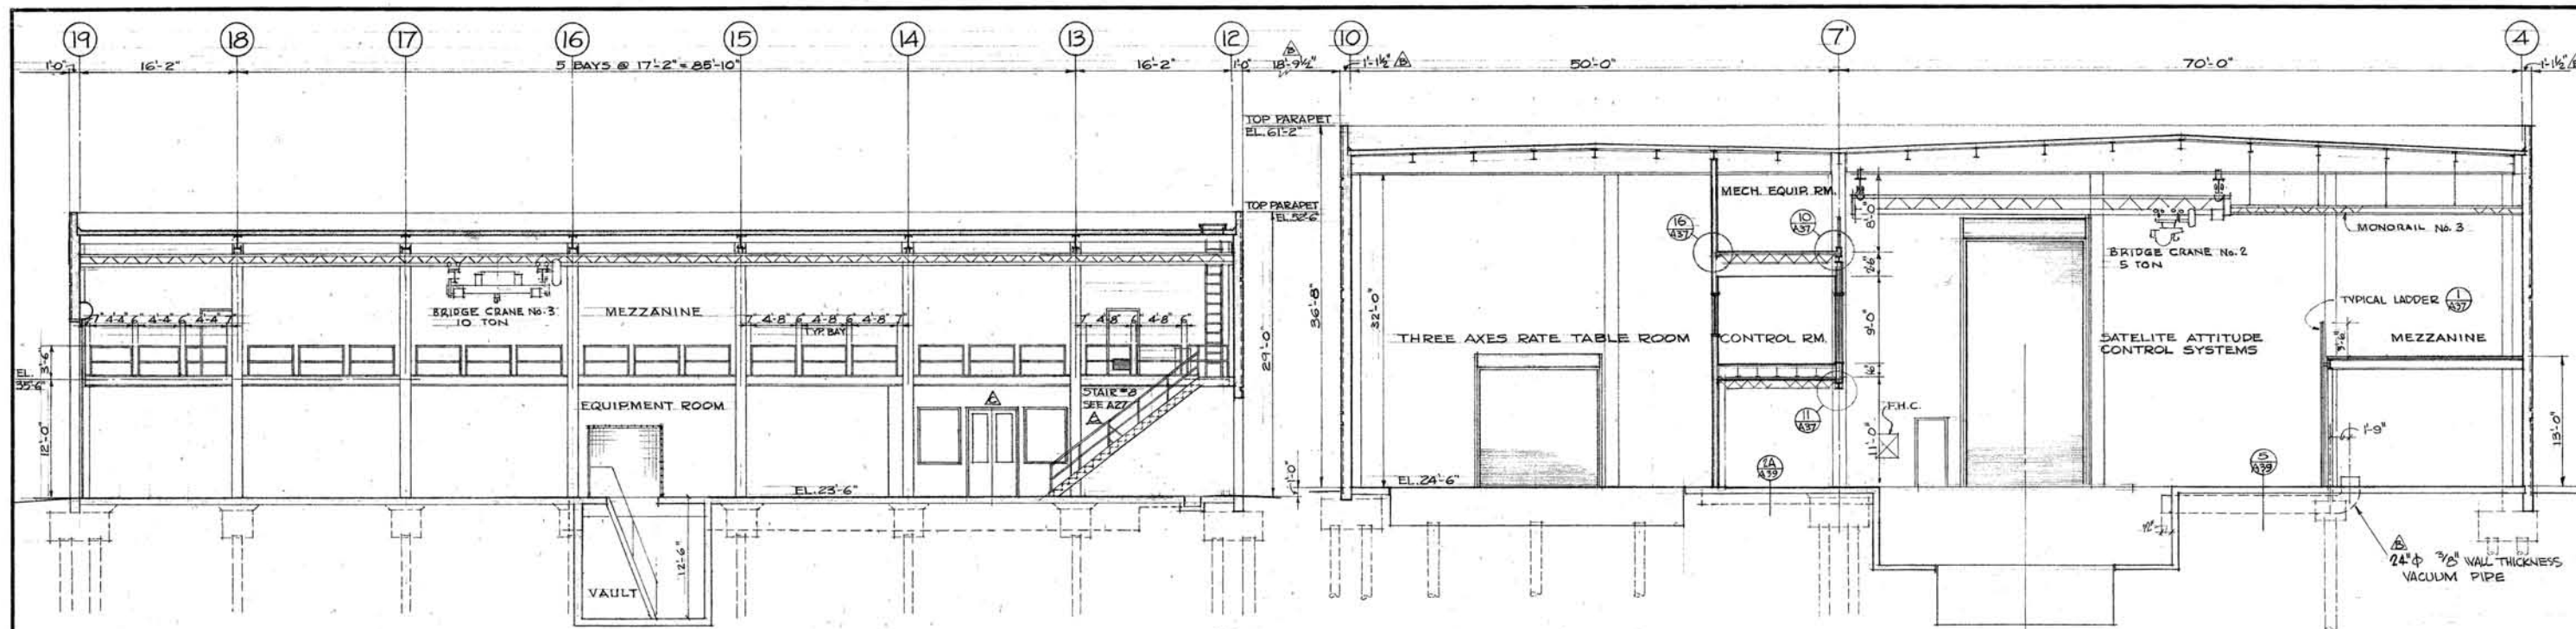

1 SECTION
1/8" = 1'-0"

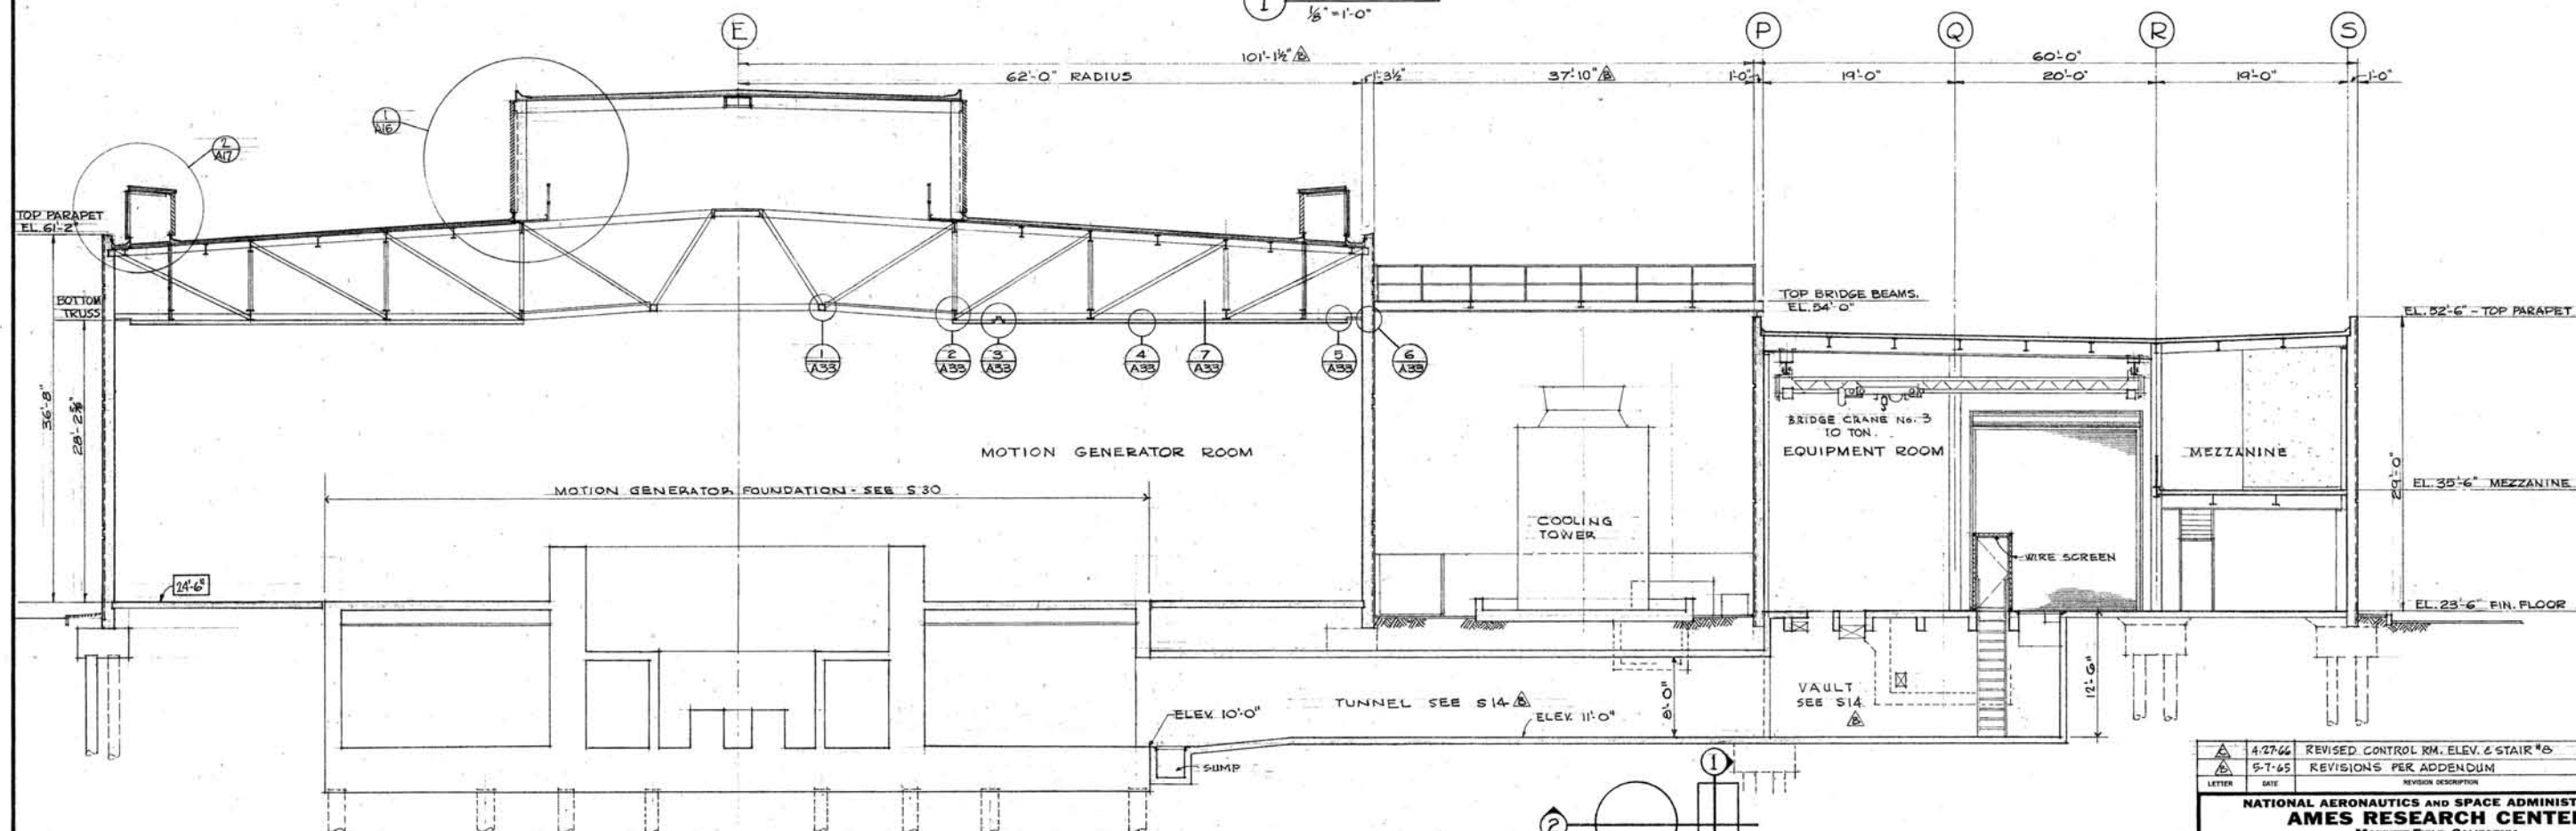


2 SECTION
1/8" = 1'-0"


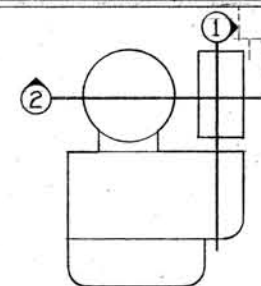


KEY PLAN




 
SKIDMORE, OWINGS & MERRILL
ARCHITECTS
ONE BUSH STREET, SAN FRANCISCO, CALIFORNIA
APPROVED FOR THE ARCHITECTS
DATE APR 5 1965

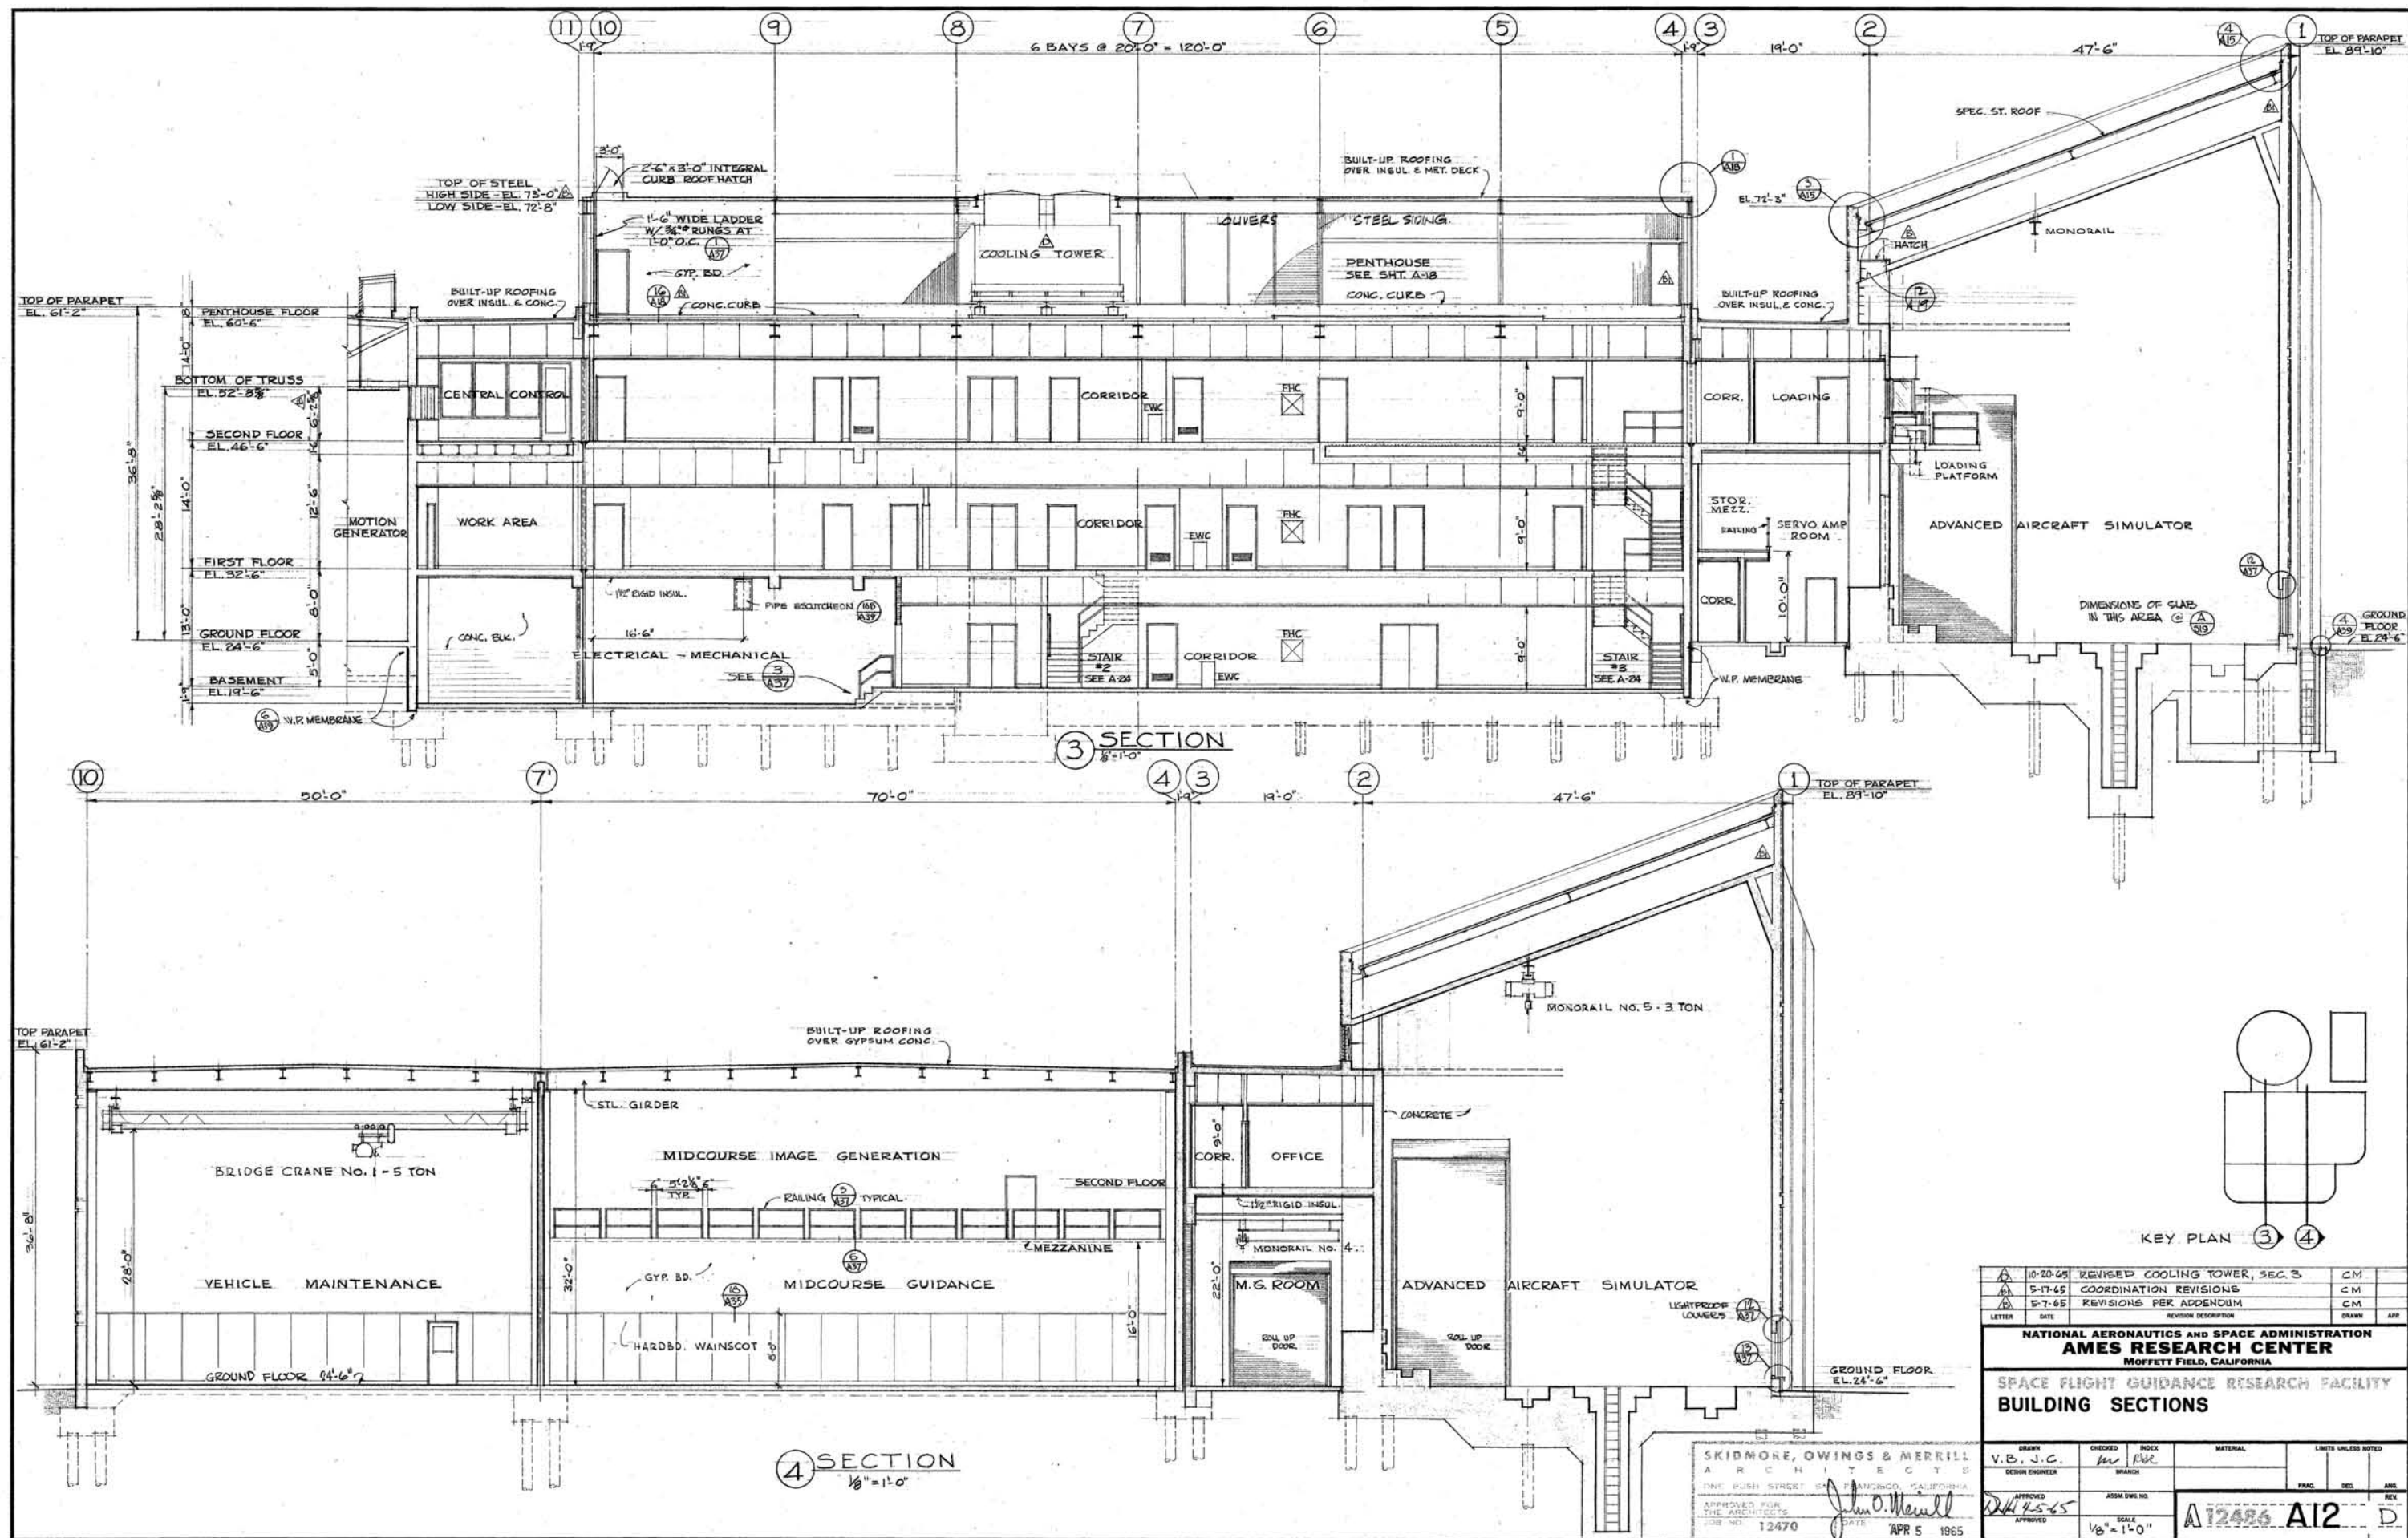4-27-66	REVISED CONTROL RM. ELEV. & STAIR #8	CM	
5-7-65	REVISIONS PER ADDENDUM	CM	
LETTER	DATE	REVISION DESCRIPTION	DRAWN
NATIONAL AERONAUTICS AND SPACE ADMINISTRATION			
AMES RESEARCH CENTER			
MOFFETT FIELD, CALIFORNIA			
SPACE FLIGHT GUIDANCE RESEARCH FACILITY			
BUILDING SECTIONS			
DRAWN	CHECKED	INDEX	MATERIAL
VB, J.C.	M	RAC	
DESIGN ENGINEER	BRANCH		
APPROVED	ASSN. DWS. NO.		
DATE	SCALE		
APR 5 1965	1/8" = 1'-0"		
A12486		A11	

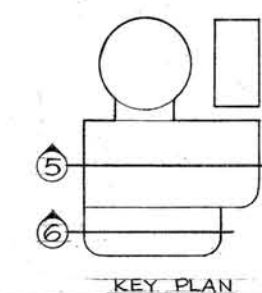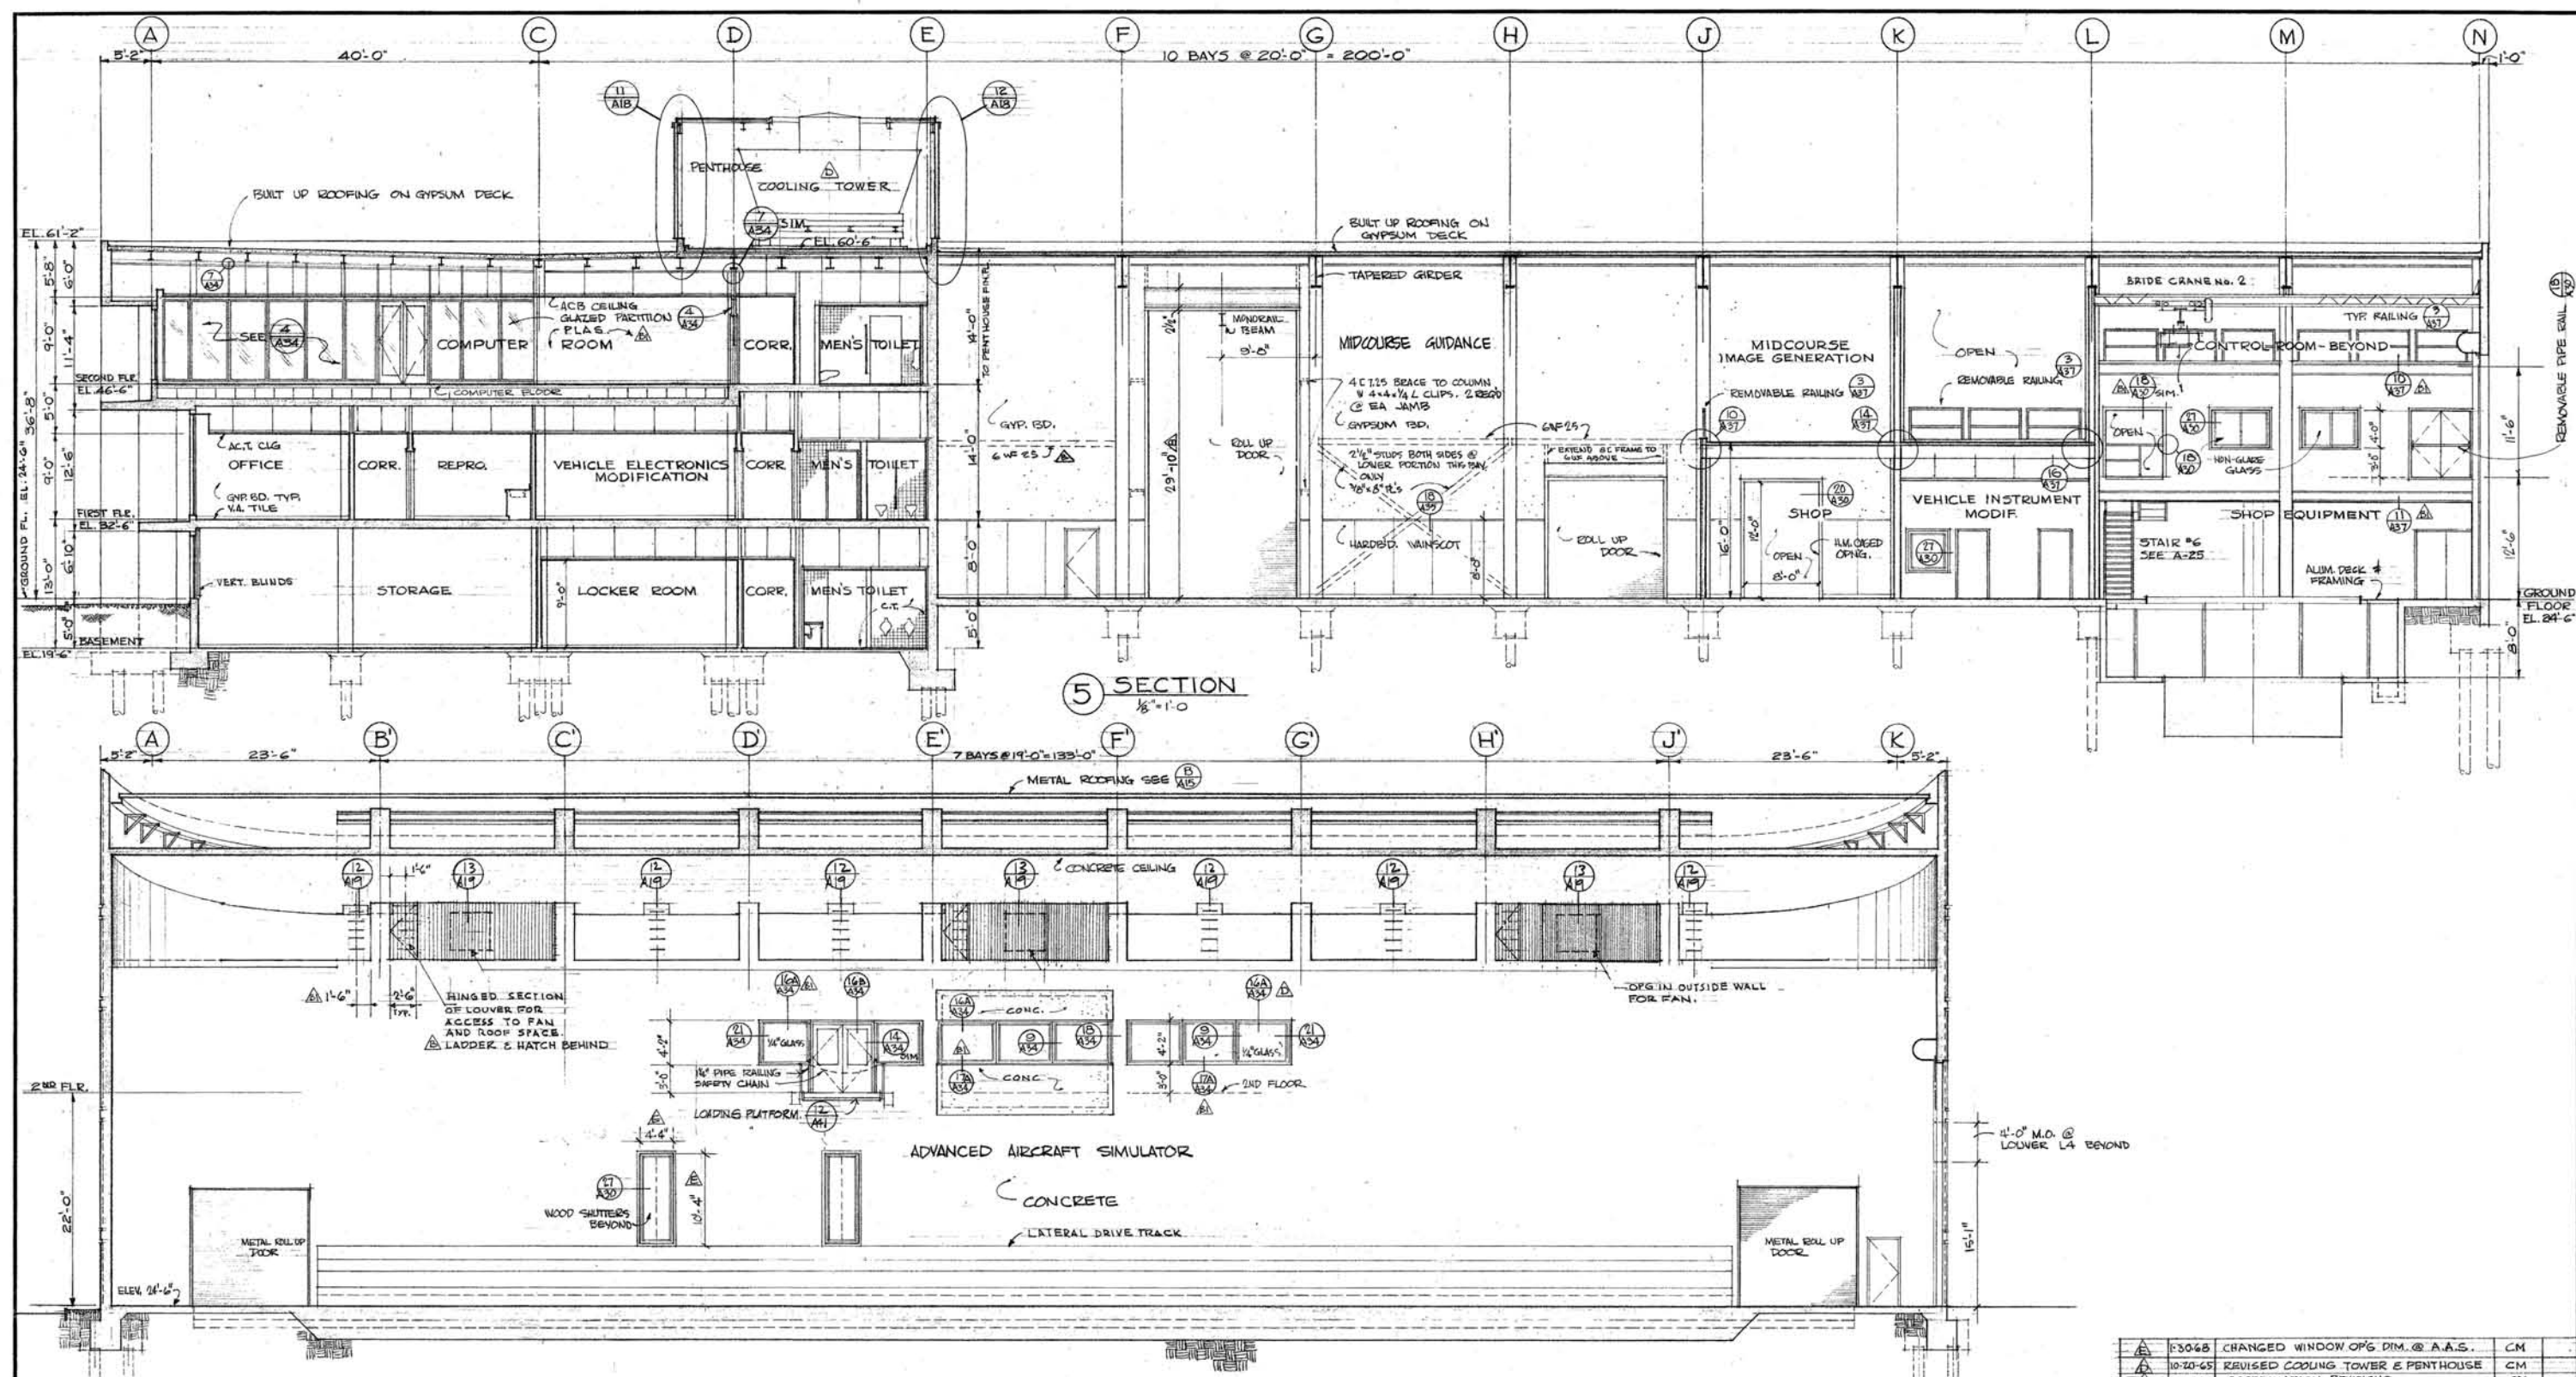




SKIDMORE, OWINGS & MERRILL
ARCHITECTS
ONE BURN STREET, SAN FRANCISCO, CALIFORNIA
APPROVED FOR THE ARCHITECTS
DATE APR 5 1963

	1-30-63	CHANGED WINDOW OPG. DIM. @ A.A.S.	CM	
	10-20-63	REVISED COOLING TOWER & PENTHOUSE	CM	
	5-17-65	COORDINATION REVISIONS	CM	
	5-7-65	REVISIONS PER ADDENDUM	CM	
LETTER	DATE	REVISION DESCRIPTION	DRAWN	APP
NATIONAL AERONAUTICS AND SPACE ADMINISTRATION				
AMES RESEARCH CENTER				
MOFFETT FIELD, CALIFORNIA				
SPACE FLIGHT GUIDANCE RESEARCH FACILITY				
BUILDING SECTIONS				


DRAWN	CHECKED	INDEX	MATERIAL	LIMITS UNLESS NOTED		
VB	ME	RUE				
DESIGN ENGINEER	BRANCH					
APPROVED	DATE	APPROVED	DATE	PRAC	DES	ANS
DNA 4-5-65		ASSN DWG. NO.				
APPROVED		SCALE				REV
	1/8" = 1'-0"					

A 17486 A13		E
-------------	--	---


243-6401A-113

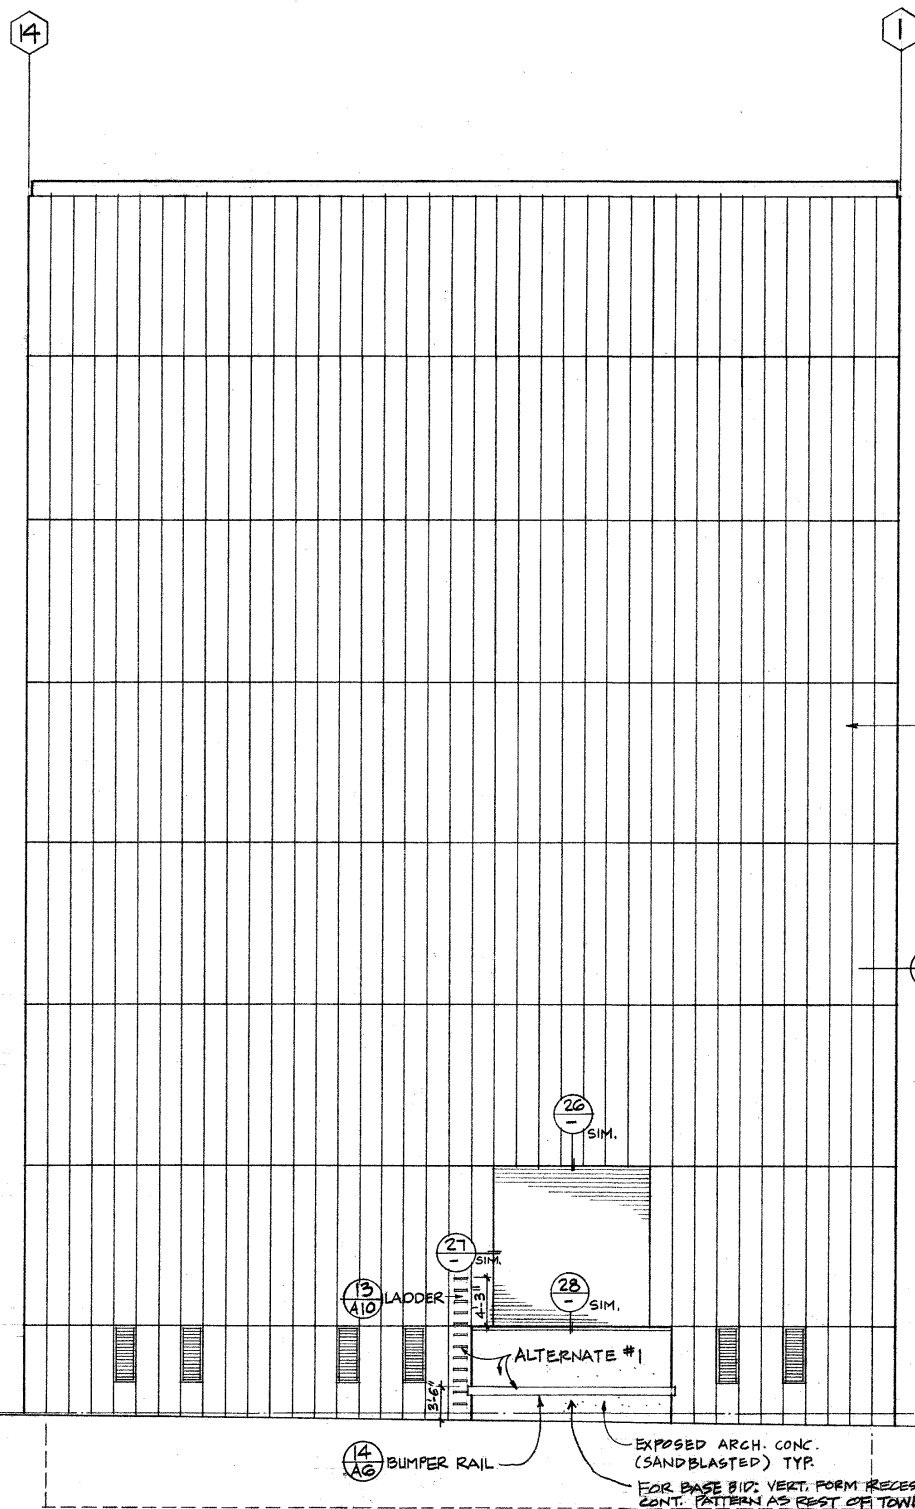


3 EAST ELEVATION
1/8" = 1'-0"

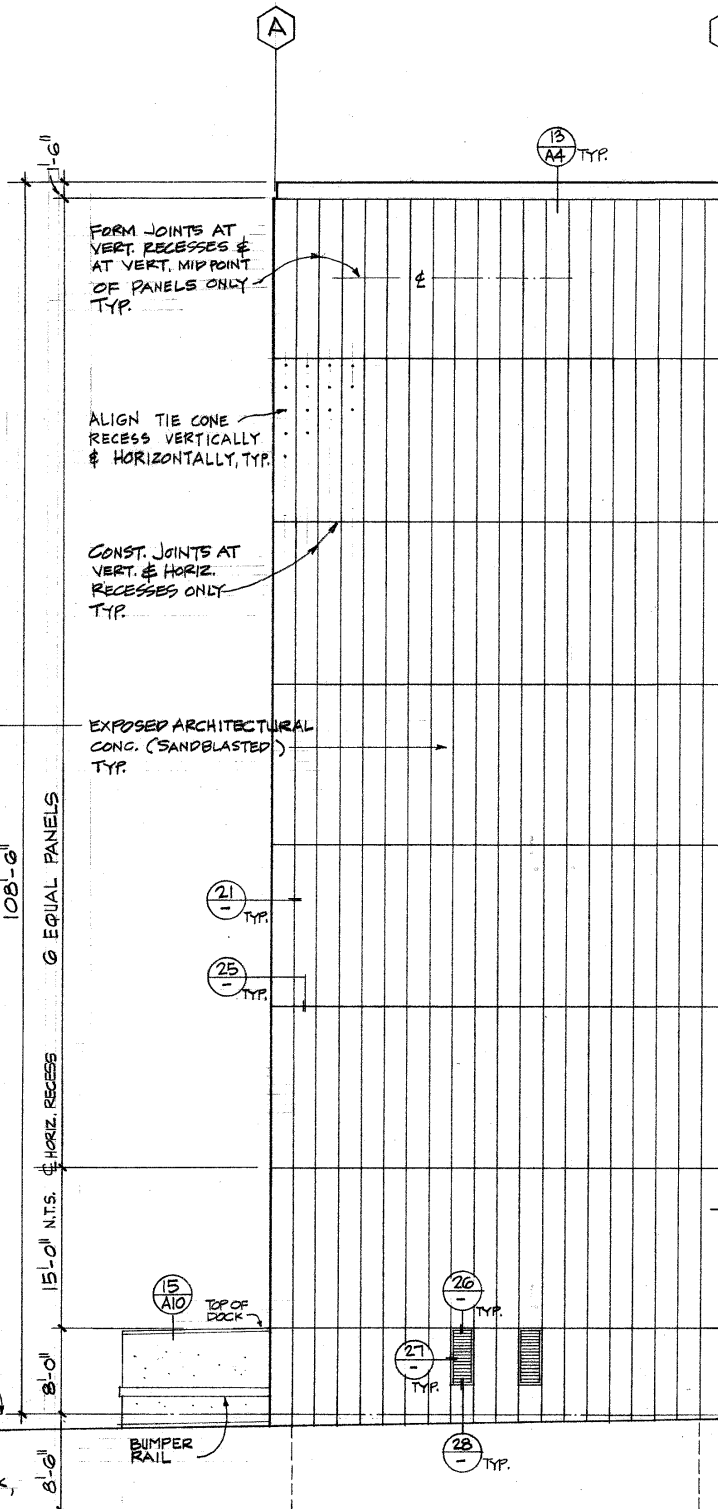


19 NORTH ELEVATION
1/8" = 1'-0"

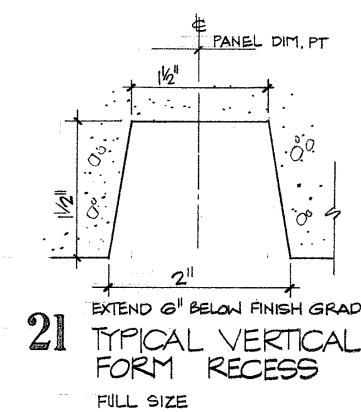


21 TYPICAL VERTICAL FORM RECESS
FULL SIZE

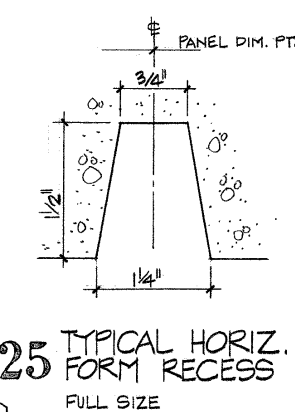


25 TYPICAL HORIZ. FORM RECESS
FULL SIZE

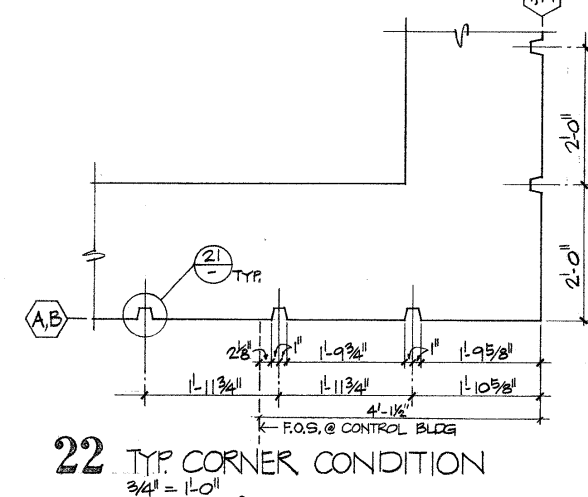


22 TYP. CORNER CONDITION
3/4" = 1'-0"

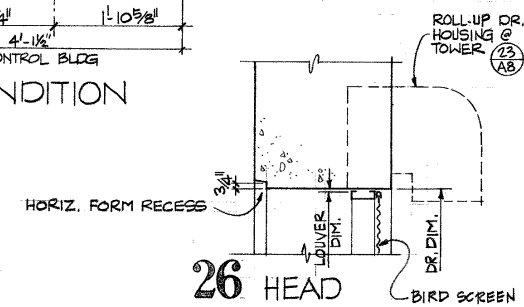

26 HEAD

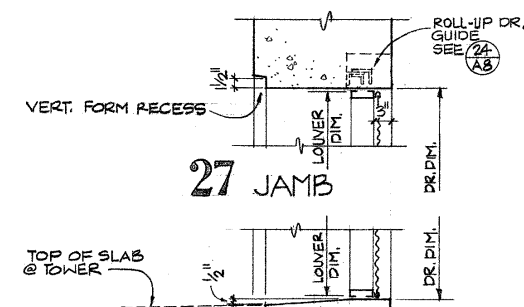


27 JAMB

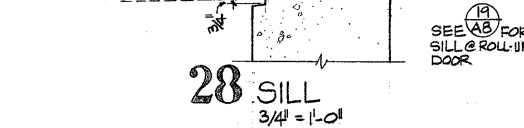


28 SILL
3/4" = 1'-0"


ANSHIEN & ALLEN		NATIONAL AERONAUTICS AND SPACE ADMINISTRATION	
ALLEN • PARKER • RICHARDSON • STROTZ ARCHITECTS / PLANNERS		AMES RESEARCH CENTER MOFFETT FIELD, CALIFORNIA 94035	
461 BUSH STREET • SAN FRANCISCO CALIFORNIA 94108 • PHONE (415) 391-7100		ADDITION TO BUILDING N-243 VERTICAL MOTION SIMULATOR BUILDING EXTERIOR ELEVATIONS, DETAILS	
DESIGN ENGINEER	CHECKED	INDEX	MATERIAL
APPROVED	APPROVED	APPROVED	APPROVED
DATE	DATE	DATE	DATE
2-28-75	2-28-75	2-28-75	2-28-75
A 243-02-A5		A 243-02-A5	

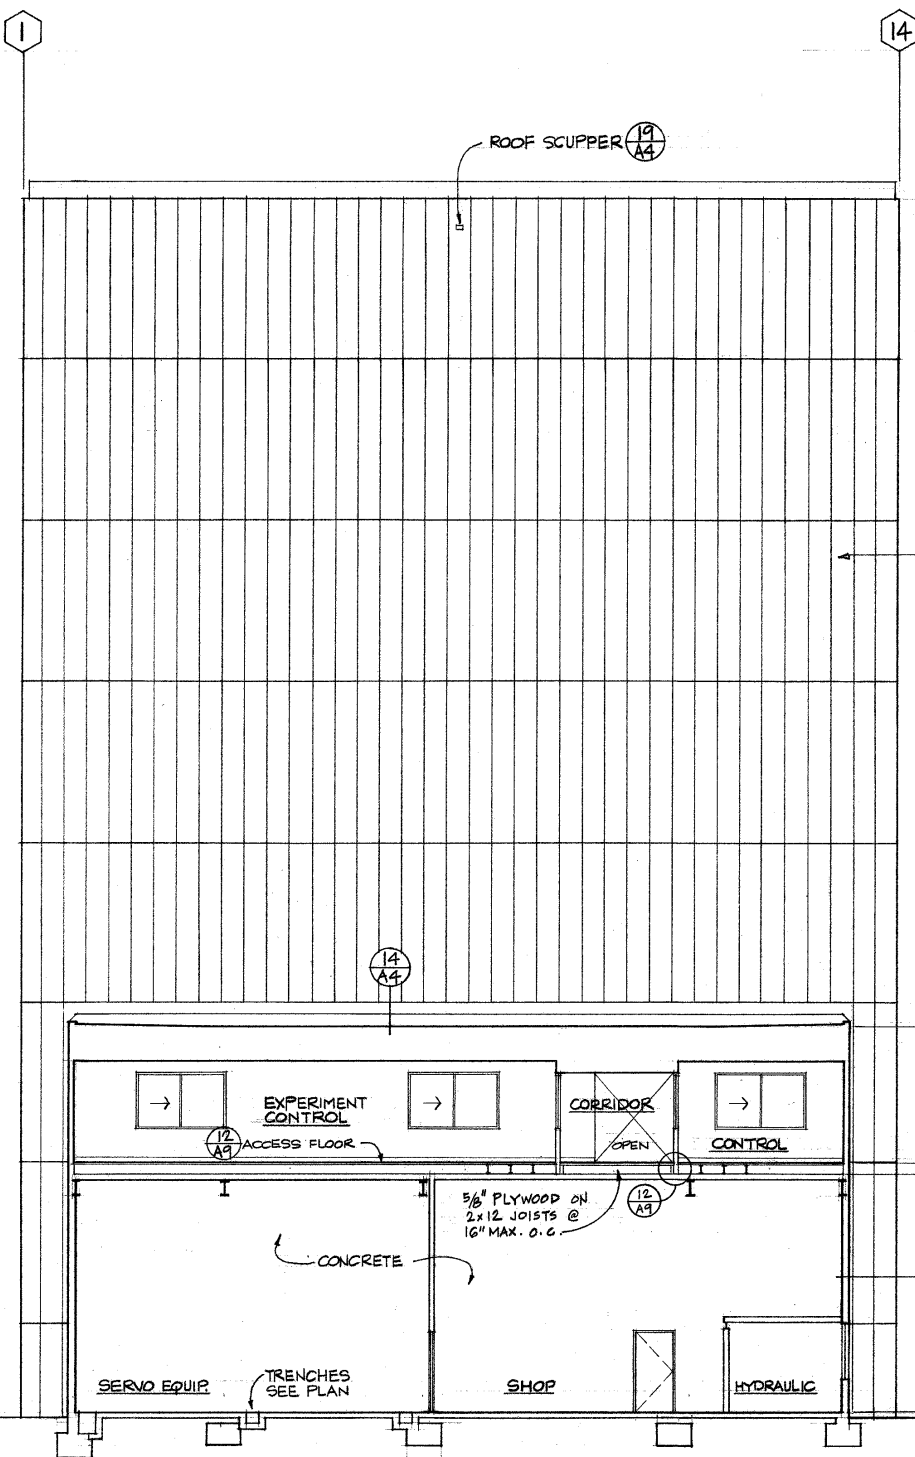


3 WEST ELEVATION
1/8" = 1'-0"

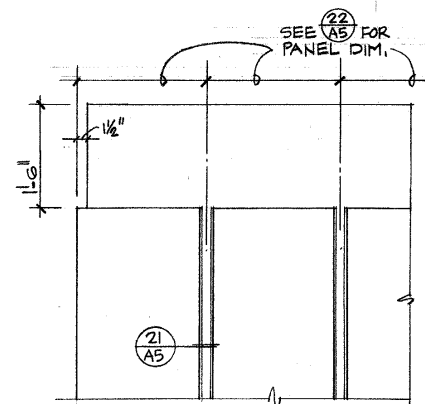

13 ELEVATION
3/4" = 1'-0"

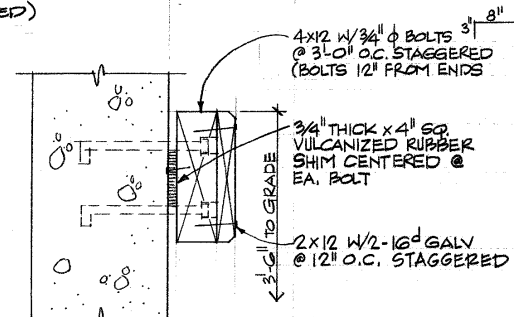


14 WOOD BUMPER @ LOADING DOCK
1/2" = 1'-0"

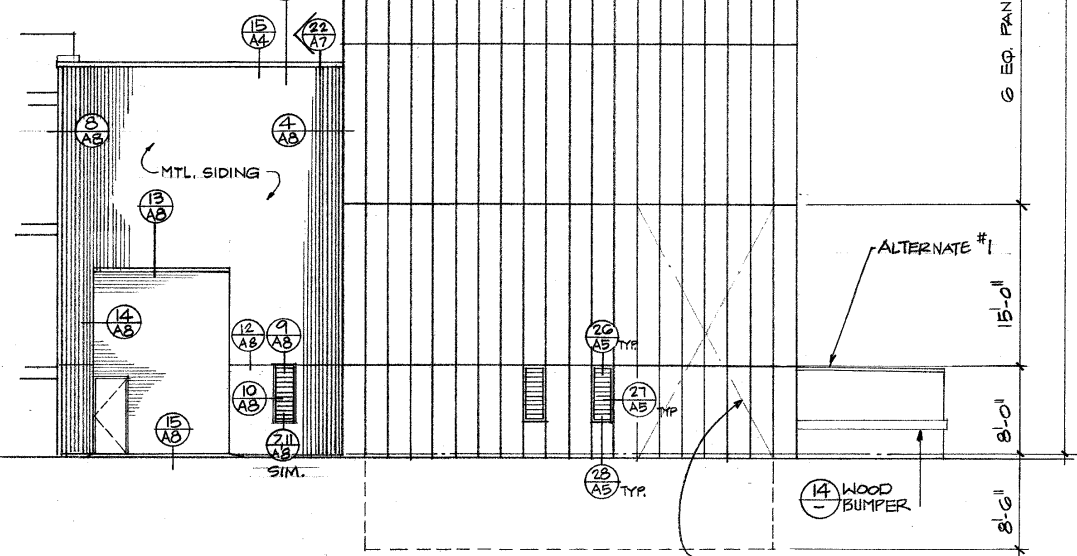


19 SOUTH ELEVATION
1/8" = 1'-0"


ANSHEN & ALLEN		NATIONAL AERONAUTICS AND SPACE ADMINISTRATION	
ALLEN • PARKER • RICHARDSON • STROTZ ARCHITECTS / PLANNERS		AMES RESEARCH CENTER MOFFETT FIELD, CALIFORNIA 94035	
461 BUSH STREET • SAN FRANCISCO CALIFORNIA 94108 • PHONE (415) 391-7100		ADDITION TO BUILDING N-243 VERTICAL MOTION SIMULATOR BUILDING EXTERIOR ELEVATIONS, DETAILS	
DESIGN ENGINEER	CHECKED	INDEX	MATERIAL
296			2-28-75
APPROVED	ASSN. DIR. NO.	SCALE	243-02-AG

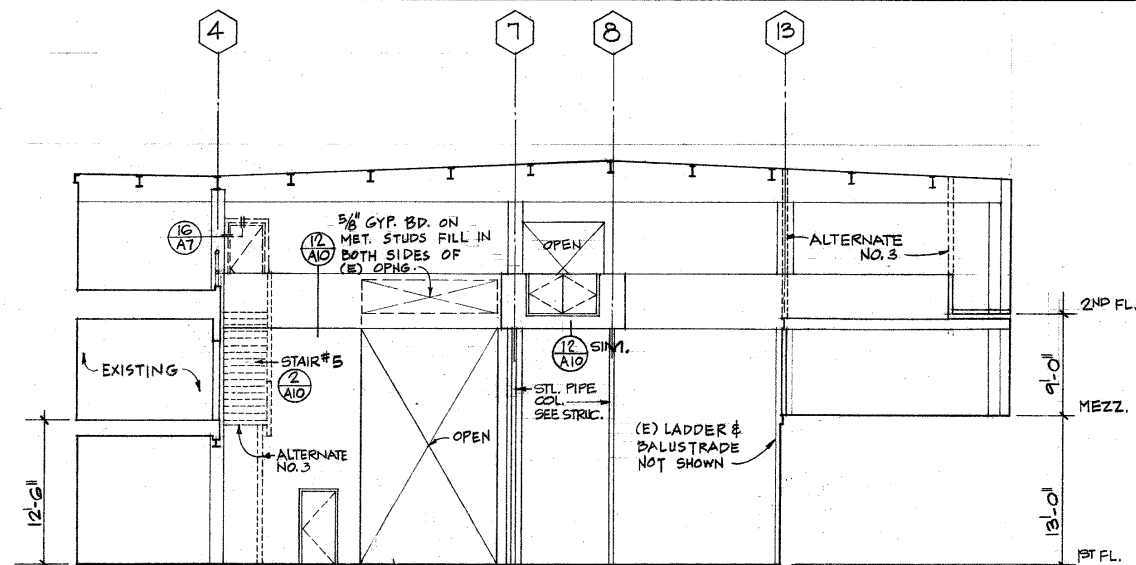


1 SECTION
1/8" = 1'-0"

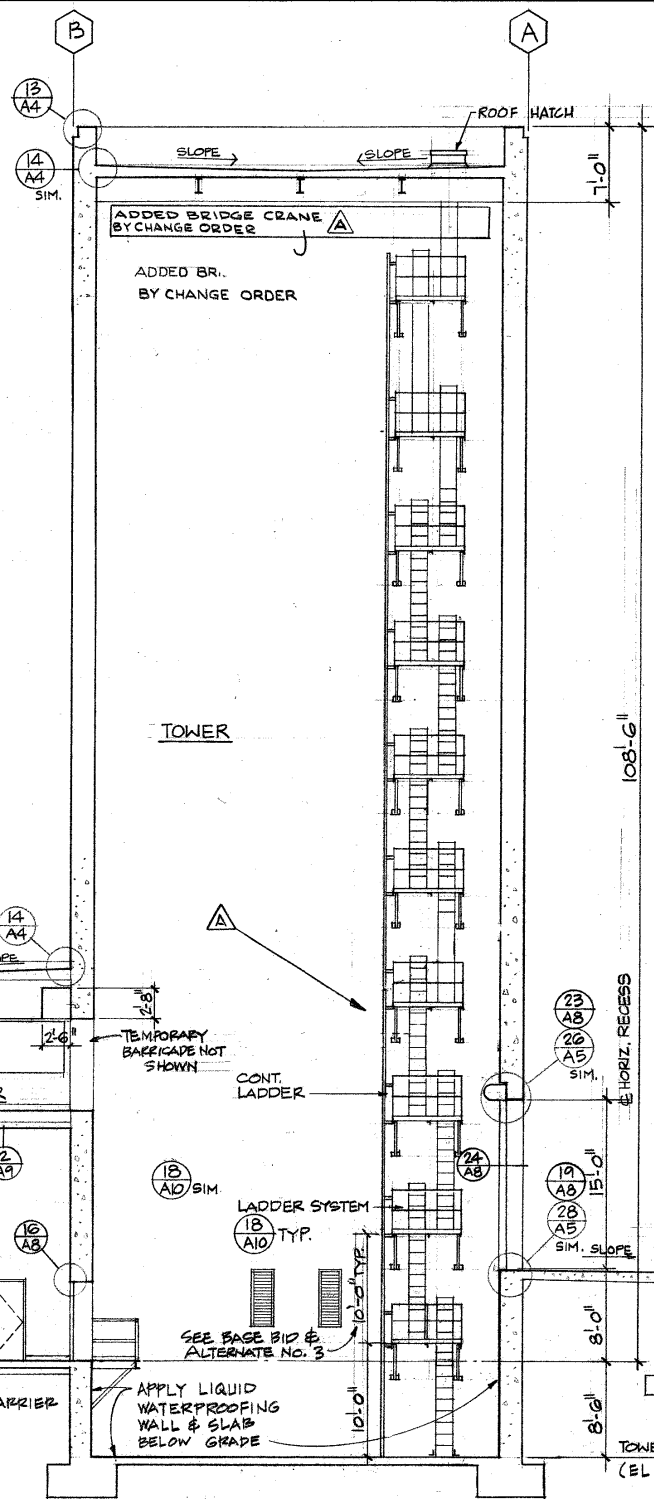


22 SECTION
1/2" = 1'-0"

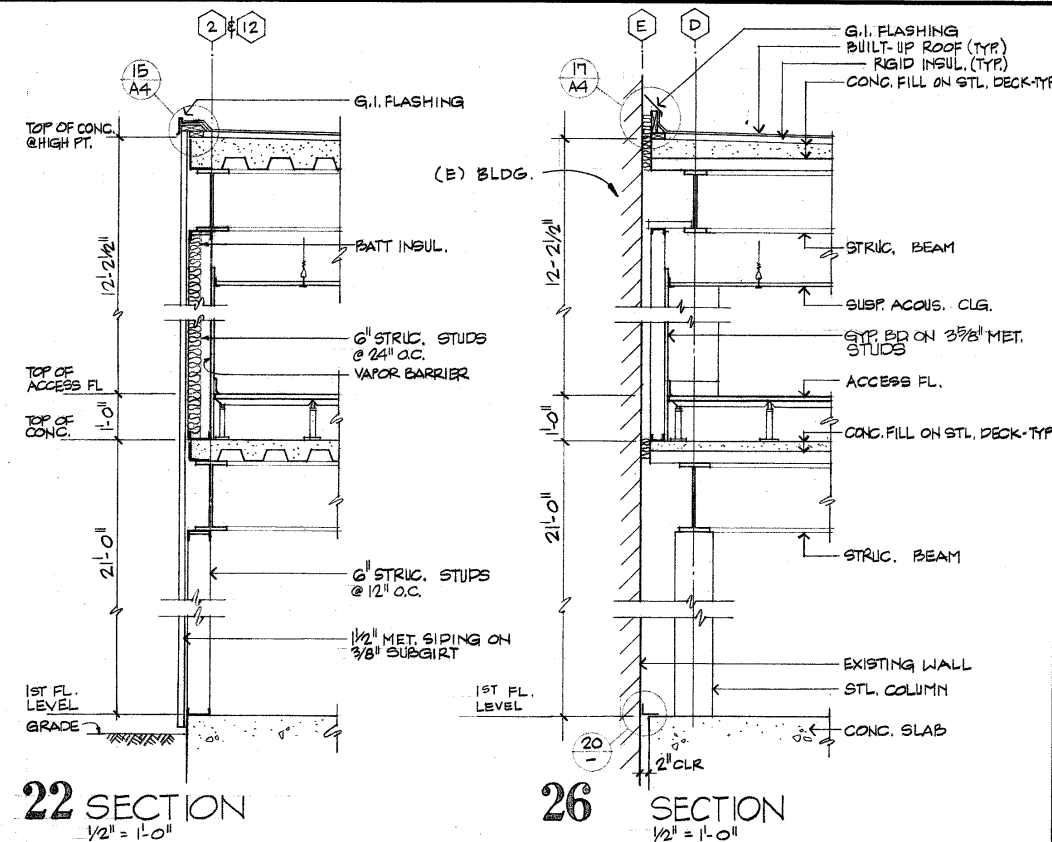


26 SECTION
1/2" = 1'-0"

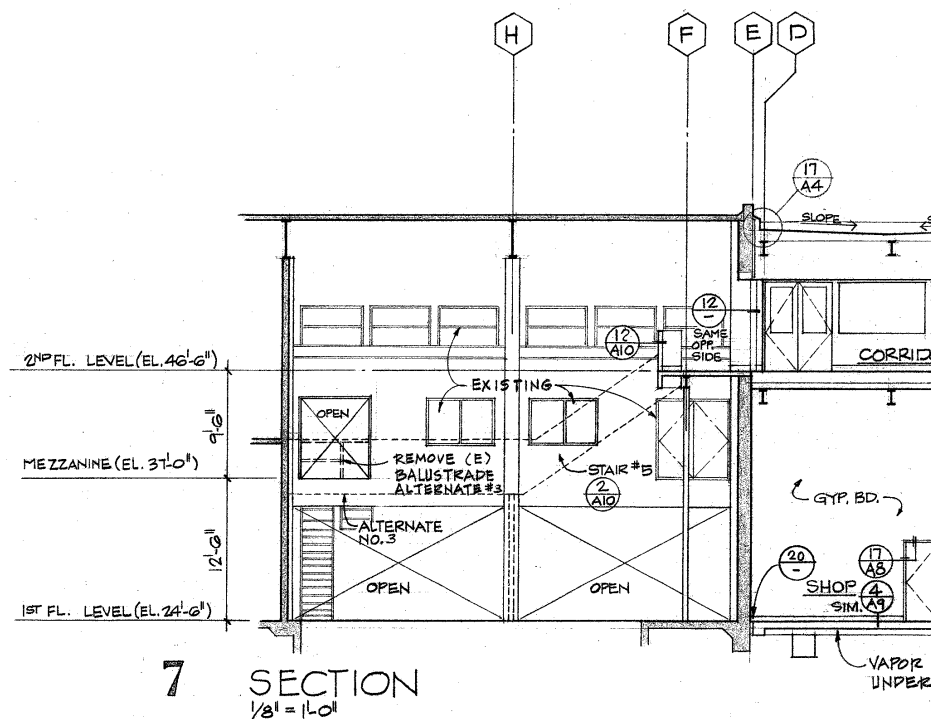


7 SECTION
1/8" = 1'-0"

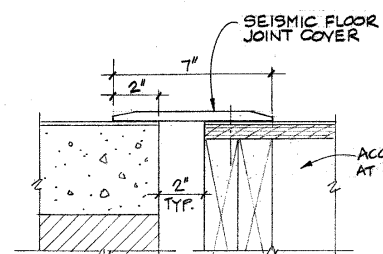


4 SEISMIC FL. JT. COVER
3/4" = 1'-0"

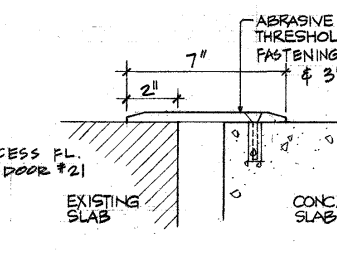


8 FL. JT. COVER
3/4" = 1'-0"

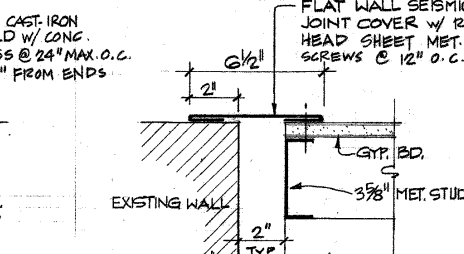

12 WALL JT. COVER
3/4" = 1'-0"

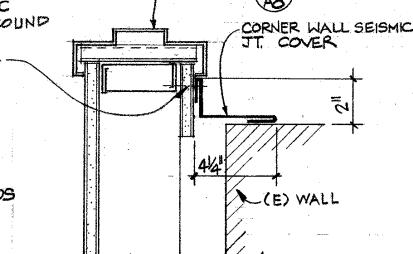

16 WALL JT. COVER
3/4" = 1'-0"

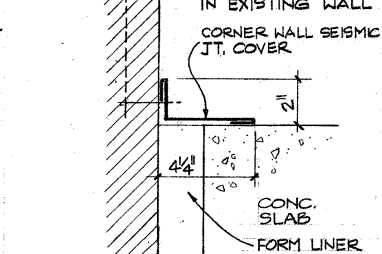

20 WALL-FL. JT. COVER
3/4" = 1'-0"

ANSHIEN & ALLEN
ALLEN · PARKER · RICHARDSON · STROTZ
ARCHITECTS / PLANNERS
461 BUSH STREET · SAN FRANCISCO
CALIFORNIA 94108 · PHONE (415) 391-7100

B 6/8/87 REVISED AS PER ERO. A20523		D.R. <i>Em</i>	
A 3-25-76 REVISION AS SHOWN		AZTEC	
LETTER	DATE	REVISION DESCRIPTION	DRAWN
NATIONAL AERONAUTICS AND SPACE ADMINISTRATION AMES RESEARCH CENTER MOFFETT FIELD, CALIFORNIA 94035			
ADDITION TO BUILDING N-243 VERTICAL MOTION SIMULATOR BUILDING SECTIONS, SEISMIC DETAILS			
DRAWN	CHECKED	INDEX	MATERIAL
DESIGN ENGINEER	BRANCH	2-28-75	PRAC. DES. REV.
APPROVED	ASST. DWS. NO.	SCALE	REV.
243	243	A 243-02-A7	B

243 71502A 17 2-25875

ADDITIONAL IMAGES:

N-244: SPACE PROJECTS FACILITY



**N-244, Aerial photograph, 18 May 1989
(Source: NASA Ames Research
Center, AC89-0234-164)**



**N-244, south facade
(Source: Page & Turnbull)**



**N-244, Newly remodeled mezzanine and Space
Station laboratory module mock-up,
15 February 1994
(Source: NASA Ames Research Center,
AC94-0052-1)**



**N-244, main lobby
(Source: Page & Turnbull)**

Architectural Drawings for N-244

Life Sciences Space Flight Facility, Site Plan

Architect: N/A

Date: 30 October 1990

Sheet: A244-8901-XA1

NASA EDC # 244-8901-XA1

Life Sciences Space Flight Facility, Ground Floor Plan

Architect: N/A

Date: 22 October 1990

Sheet: A244-8901-XA2

NASA EDC # 244-8901-XA2

Life Sciences Space Flight Facility, Second Floor Plan

Architect: N/A

Date: 22 October 1990

Sheet: A244-8901-XA3

NASA EDC # 244-8901-XA3

Life Sciences Space Flight Facility, Third Floor Plan

Architect: N/A

Date: 22 October 1990

Sheet: A244-8901-XA4

NASA EDC # 244-8901-XA4

Life Sciences Space Flight Facility, North and South Elevations

Architect: N/A

Date: 29 October 1990

Sheet: A244-8901-XA6

NASA EDC # 244-8901-XA6


Life Sciences Space Flight Facility, West Elevation and Building Section

Architect: N/A


Date: 22 October 1990

Sheet: A244-8901-XA7

NASA EDC # 244-8901-XA7

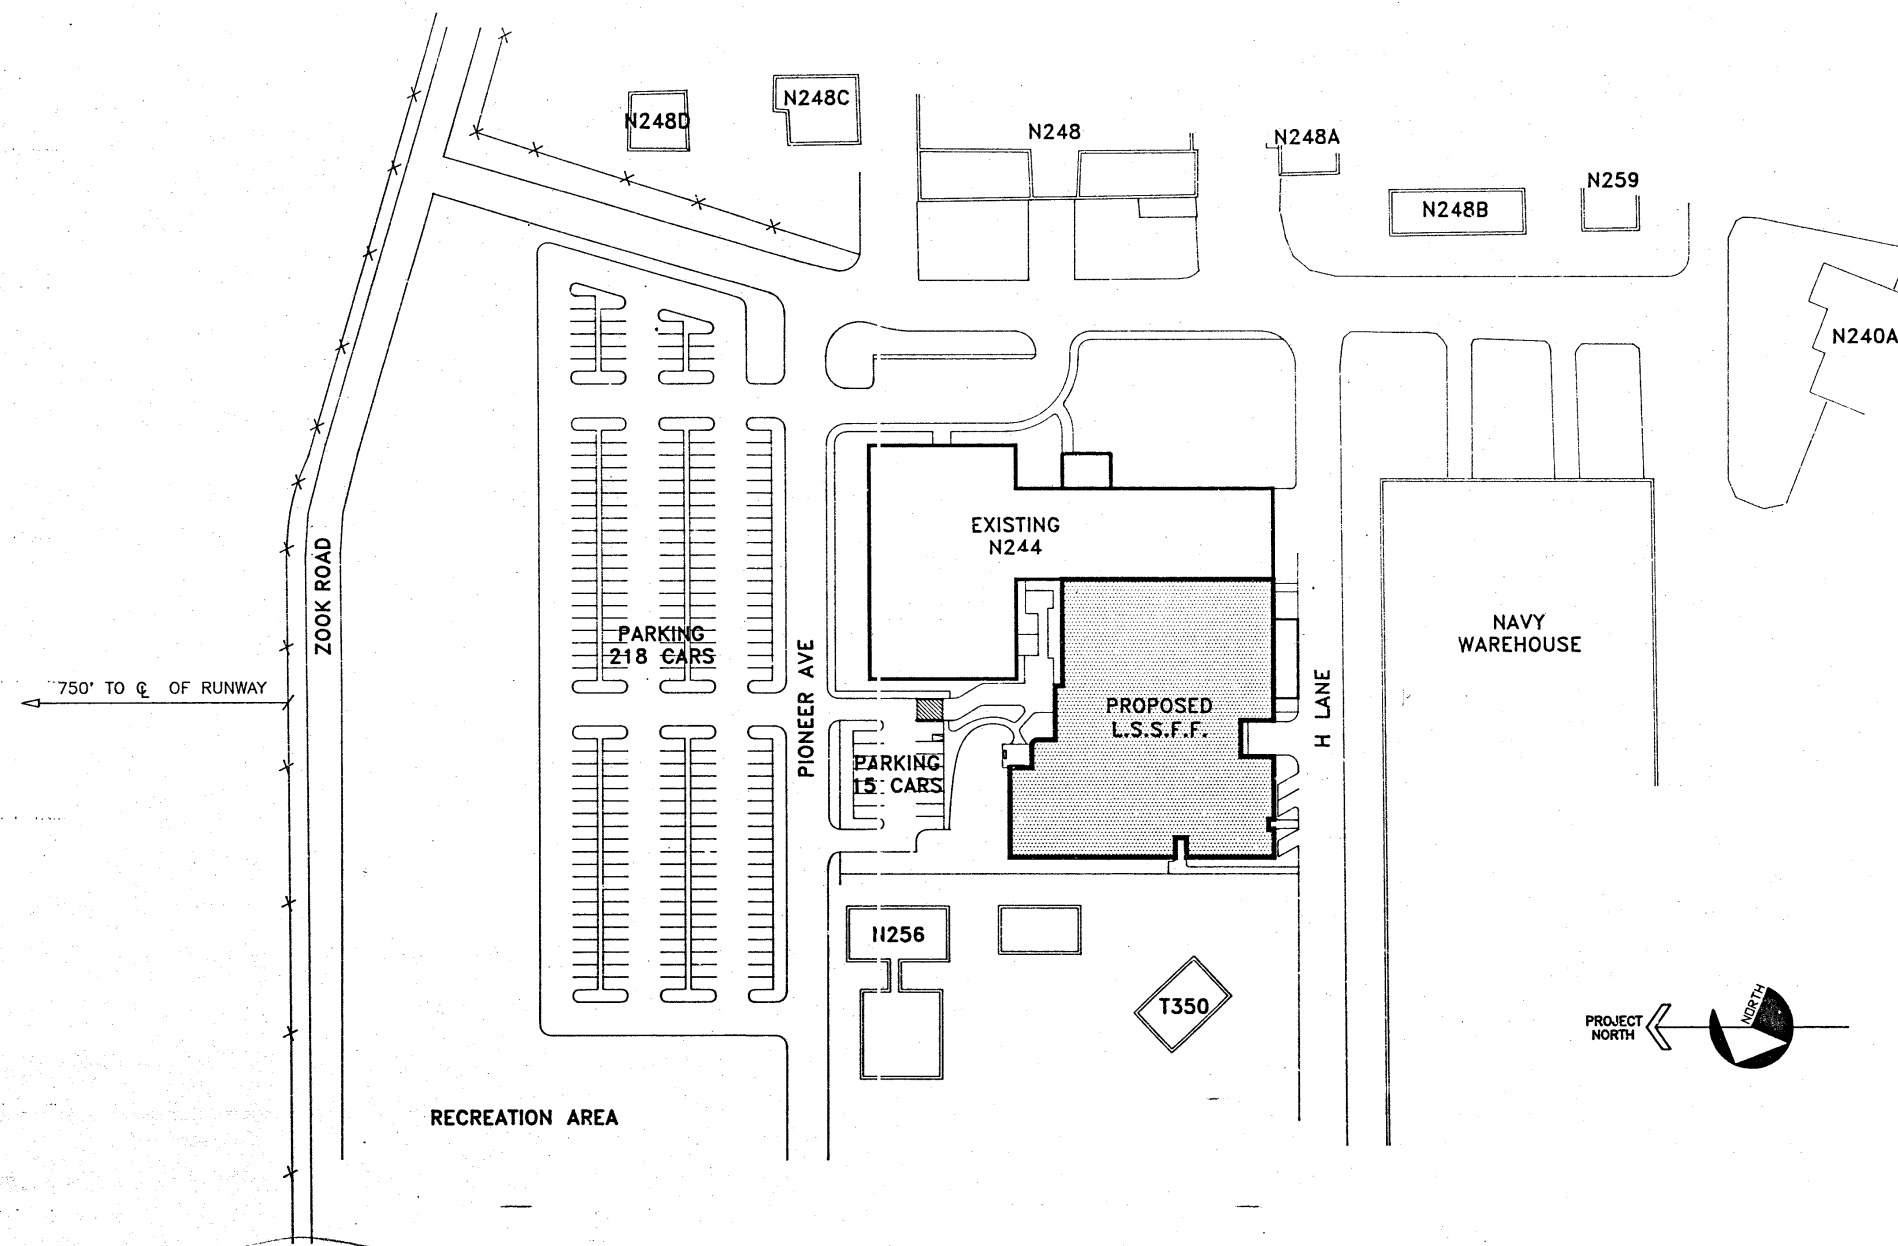

PROPOSED L.S.S.F.F. SITE PLAN

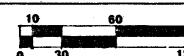

LETTER	DATE	REVISION DESCRIPTION	DRAWN	APP.
NATIONAL AERONAUTICS AND SPACE ADMINISTRATION AMES RESEARCH CENTER MOFFETT FIELD, CALIFORNIA				
LIFE SCIENCES SPACE FLIGHT FACILITY SITE PLAN				
DRAWN JME	CHECKED JME	DATE 10-30-90	SHEET UNLESS NOTED	
DESIGNED VS	ENGINEER EEF/BE	DATE 10-30-90	SCALE 1" = 60'-0"	
APPROVED <i>[Signature]</i>		A 244-8901-XA1		

PIONEER AVENUE

EXISTING
N244

EXISTING
N244

HIGH BAY

RELOCATION
OF
EXISTING
TOWER

NEW
COOLING
TOWER

SERVICE
AREA

AIR LOCK SPACE

AIR LOCK

MECH
ROOM

H LANE

STORAGE,
INTEGRATION,
& STAGING

MACHINE
SHOP

ELECTRONICS
LAB.

BONDED
STORES

SHIPPING/RECEIVING
& INSPECTION

LOBBY

STORAGE

ELEC

TELE

M

J

W

ANIMAL

HOLDING

AREA

BIO LAB

BIO LAB

DOCUMENTATION

OFFICES

STORAGE

ELECT
VAULT

GROUND FLOOR PLAN

SCALE: 1/16" = 1'-0"




PROJECT
NORTH




NAVY BUILDING LINE

LETTER	DATE	REVISION DESCRIPTION	DRAWN	APP.
NATIONAL AERONAUTICS AND SPACE ADMINISTRATION AMES RESEARCH CENTER MOFFETT FIELD, CALIFORNIA				
LIFE SCIENCES SPACE FLIGHT FACILITY GROUND FLOOR PLAN				
DRAWN JME	CHECKED VS	DESIGNED EEF/REC	DATE 10-22-90	LIMITS UNLESS NOTED
APPROVED <i>[Signature]</i>	DATE 11/16/90	SCALE 1/16" = 1'-0"	A244-8901-XA2	

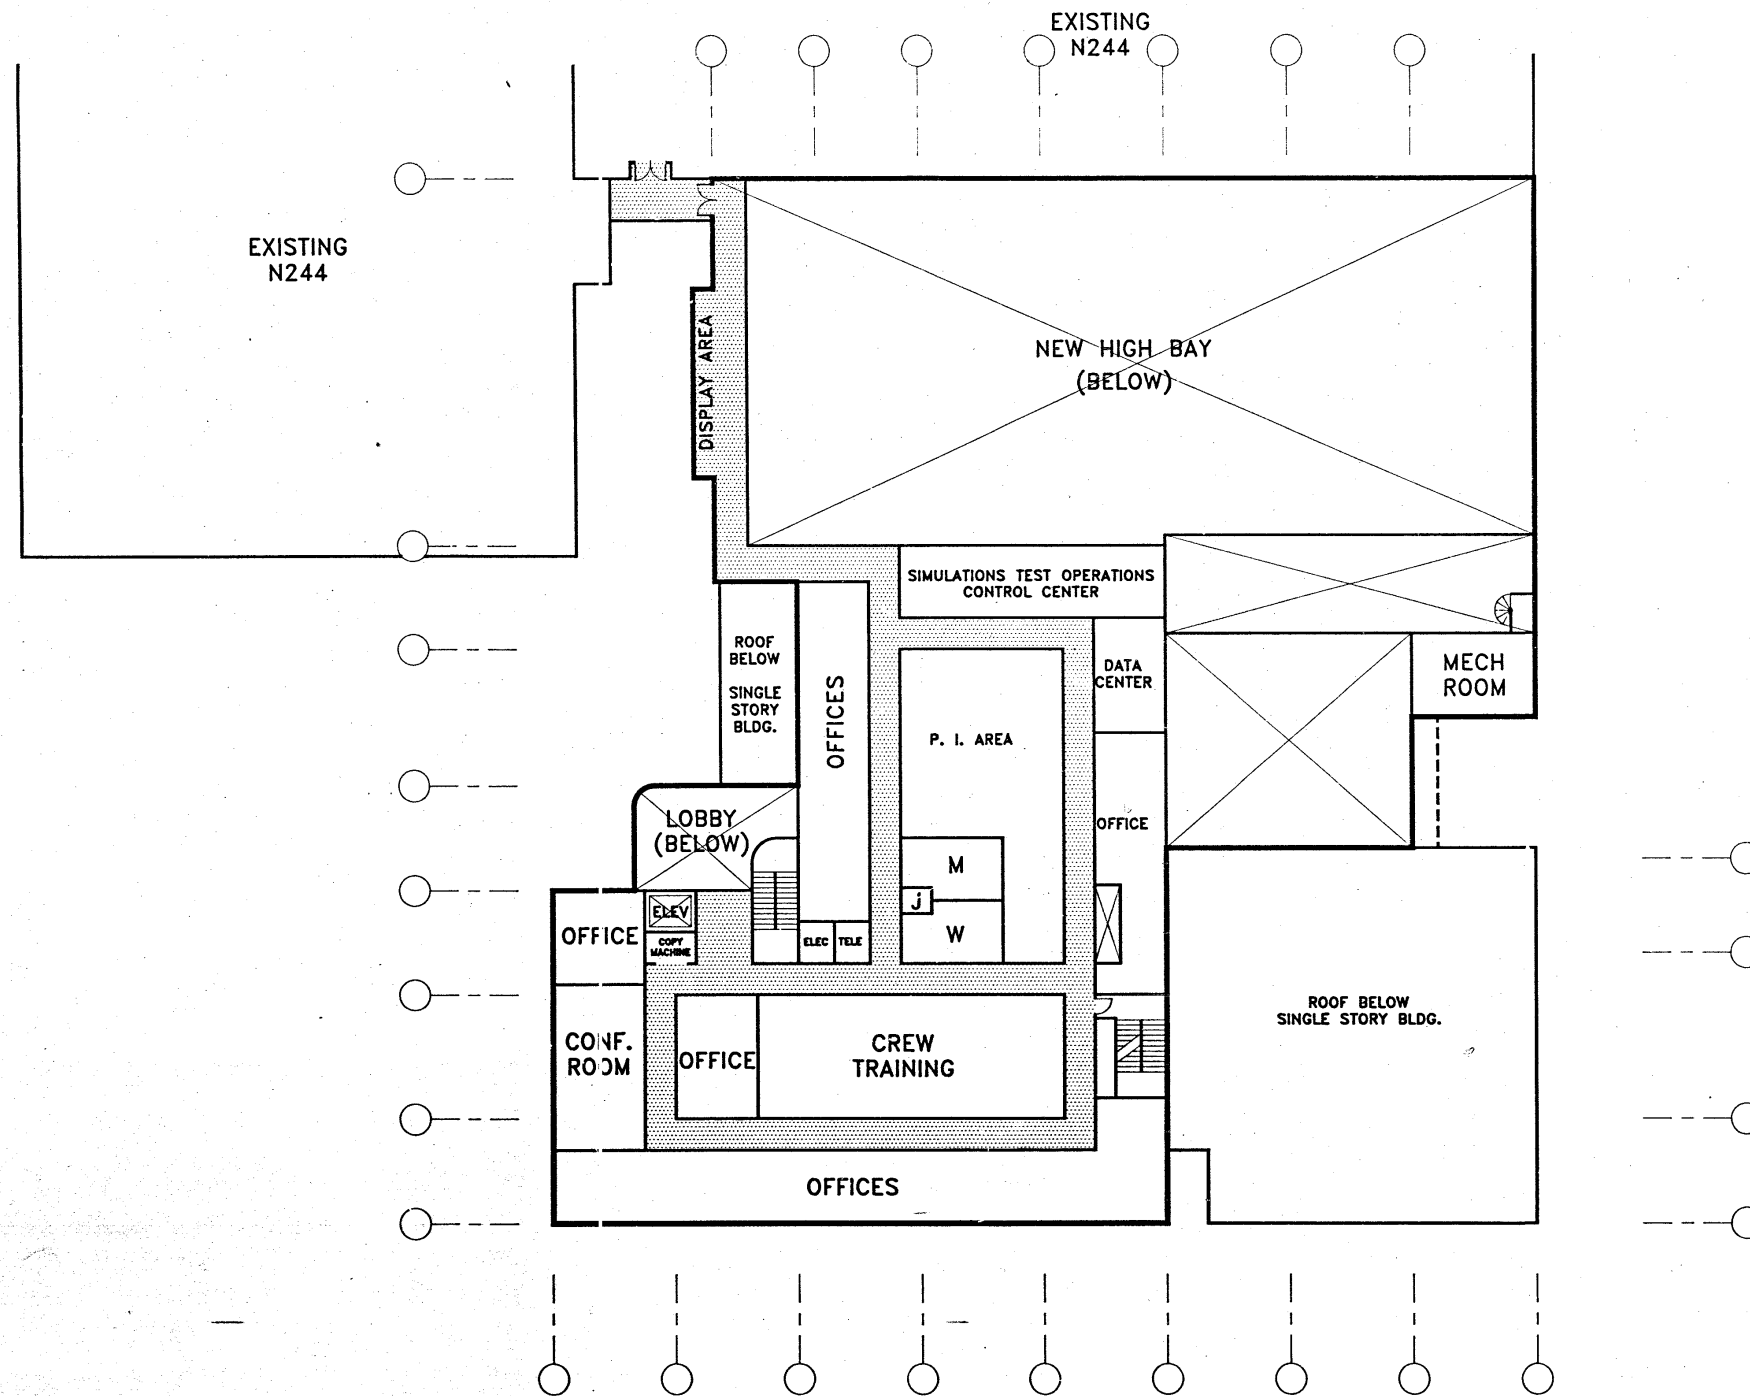


SECOND FLOOR PLAN

SCALE: 1/16" = 1'-0"

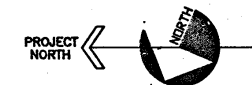


LETTER	DATE	REVISION DESCRIPTION	DRAWN	APP.
NATIONAL AERONAUTICS AND SPACE ADMINISTRATION AMES RESEARCH CENTER MOFFETT FIELD, CALIFORNIA				
LIFE SCIENCES SPACE FLIGHT FACILITY SECOND FLOOR PLAN				
DRAWN JME	DESIGNED SP2	ENGINEER	REVISION	LIMITS UNLESS NOTED
DESIGN ENGINEER VS	BRANCH EEF/REC	10-22-90	PLAC.	SEC.
APPROVED <i>[Signature]</i>	ASST. DIR. NO.	SCALE 1/16"=1'-0"	A 244-8901-XA3	

LETTER	DATE	BY/ISSN DESCRIPTION		ISSN	APP.
NATIONAL AERONAUTICS AND SPACE ADMINISTRATION AMES RESEARCH CENTER MOFFETT FIELD, CALIFORNIA					
LIFE SCIENCES SPACE FLIGHT FACILITY THIRD FLOOR PLAN					
DRAWN JME	CHECKED SPZ	INDEX	INITIAL	LIMITS UNLESS NOTED	
RECD CHECKED VS	RECD EEF/FBC	10-22-90		FNAC	REC.
APPROVED [Signature]	AERL ENG. NO. 1/16" SCALE 1/16" = 1'-0"	A 244-8901-1XA4		REV.	

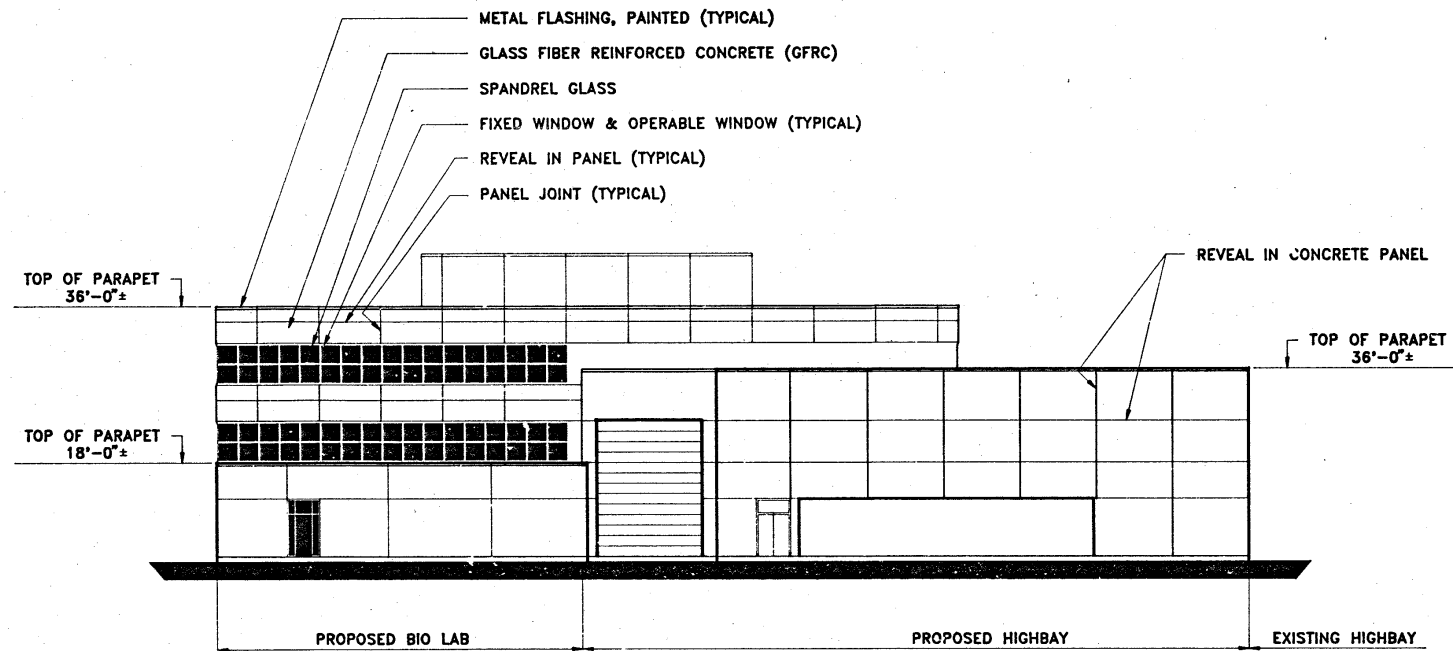


SOUTH ELEVATION

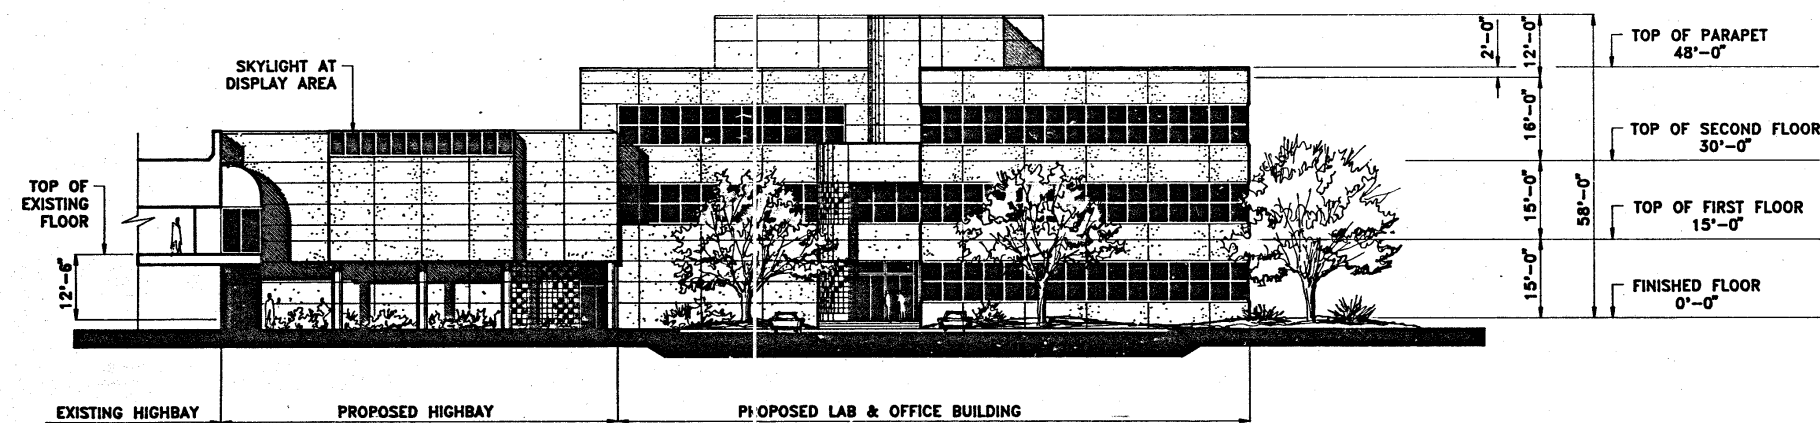


NORTH ELEVATION


LETTER	DATE	REVISION DESCRIPTION	DRAWN	APP.
NATIONAL AERONAUTICS AND SPACE ADMINISTRATION AMES RESEARCH CENTER MOFFETT FIELD, CALIFORNIA				
LIFE SCIENCES SPACE FLIGHT FACILITY NORTH AND SOUTH ELEVATIONS				
DRAWN JME	CHECKED VS	DESIGNED EEF/BEK	DATE 10-29-90	LIMITS UNLESS NOTED
APPROVED <i>[Signature]</i>	APPROVED <i>[Signature]</i>	SCALE 1/16"=1'-0"	A 244-8901-XA6	

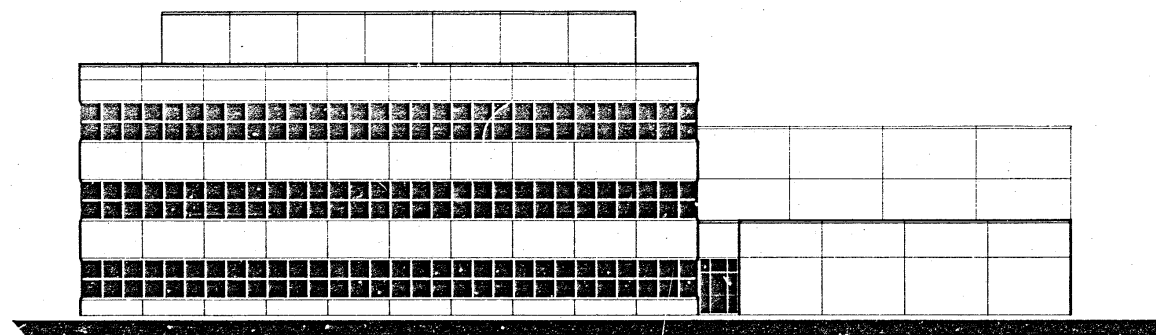

WEST ELEVATION

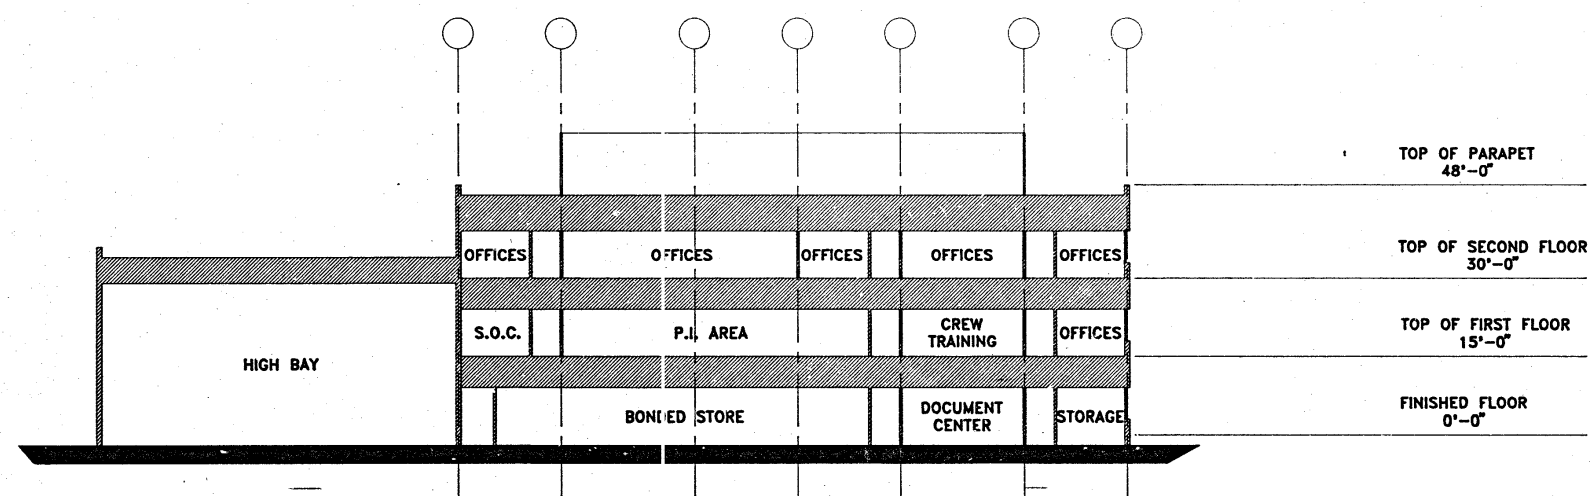

BUILDING SECTION

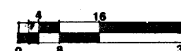

LETTER	DATE	REVISION DESCRIPTION	DRAWN	APP.
NATIONAL AERONAUTICS AND SPACE ADMINISTRATION AMES RESEARCH CENTER MOFFETT FIELD, CALIFORNIA				
LIFE SCIENCES SPACE FLIGHT FACILITY WEST ELEVATION AND BUILDING SECTION				
DRAWN FMC	CHECKED SP	INDEX	LIMITS (CHECK NOTES)	
DESIGN ENGINEER VS	BRANCH EEF/BEC	DATE 10-30-90	PMG	REC.
APPROVED W.F.C.	SCALE 1/16"=1'-0"	A 244-8901-XA7		

Additional Images:

N-258: NASA Advanced Supercomputing Facility




**N-258 under construction, 9 August 1985
(Source: NASA Ames Research Center,
A85-5016-1)**



**N-258, Aerial photograph, 12 June 1986
(Source: NASA Ames Research Center,
AC86-5018-19)**



**N-258, NAS Origin 2000 Computer System -
512 Processor ("LOMAX") station,
30 September 1999
(Source: NASA Ames Research
Center, AC99-0195-2)**

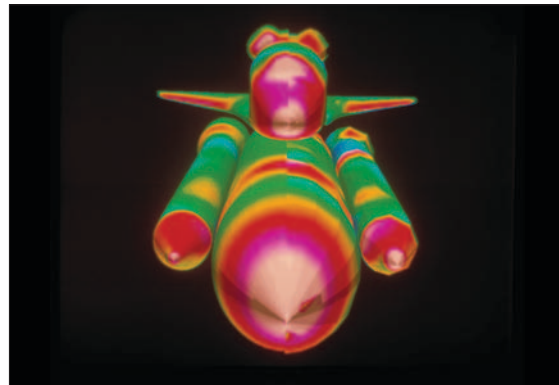

**N-258, NAS CGI Space Shuttle Launch
configuration showing surface pressure
comparison
(Source: NASA Ames Research
Center, AC88-0149-2.1)**

Architectural Drawings for N-258

Numerical Aerodynamic Simulation Facility, Site Plan

Architect: Hunt & Company, Architects

Date: 24 April 1985

Sheet: A258-8401-A1

NASA EDC # 258-8401-A1

Numerical Aerodynamic Simulation Facility, Plan, Level 1

Architect: Hunt & Company, Architects

Date: 24 April 1985

Sheet: A258-8401-A6

NASA EDC # 258-8401-A6

Numerical Aerodynamic Simulation Facility, Plan, Level 2

Architect: Hunt & Company, Architects

Date: 24 April 1985

Sheet: A258-8401-A7

NASA EDC # 258-8401-A7

Numerical Aerodynamic Simulation Facility, Exterior Elevations

Architect: Hunt & Company, Architects

Date: 24 April 1985

Sheet: A258-8401-A17

NASA EDC # 258-8401-A17

Numerical Aerodynamic Simulation Facility, Building Sections

Architect: Hunt & Company, Architects

Date: 24 April 1985

Sheet: A258-8401-A18

NASA EDC # 258-8401-A18

Numerical Aerodynamic Simulation Facility, Building Sections

Architect: Hunt & Company, Architects


Date: 24 April 1985

Sheet: A258-8401-A19

NASA EDC # 258-8401-A19

SITE PLAN
AREA 'A'

SITE PLAN
AREA 'B'

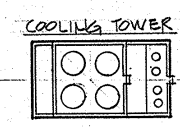

SITE PLAN
AREA 'B'

SITE PLAN
AREA 'C'

VALVE BOX
SEE MECH.
DWG.

ADD SCREEN WALL

NAS FACILITY

(N) NEW MOFFETT BLVD


(N) MOFFETT BLVD

2 EIGHT AVE
SEE TOPOGRAPHIC
SURVEY

ALTERNATE #3

(N) 8TH AVENUE

FACE OF CURB

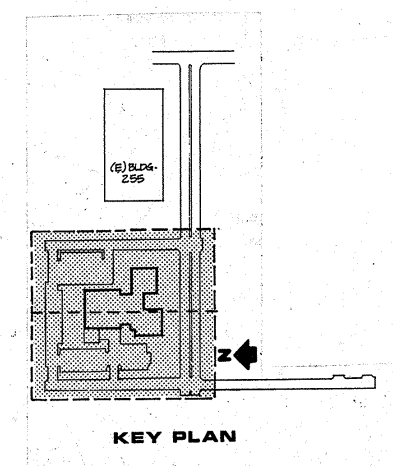

**ECO NO. A 21517
RECORD DRAWING**

To the best of our knowledge, this Drawing has been cross-referenced to appropriate reference documents denoting revisions made during construction.

Mark	PCM	Field Clarification	C drawing
APD	93		C65

HCO ARCHITECTS WGR 11/5/87



HUNT & COMPANY, ARCHITECTS
STRUCTURAL ENGINEER
H.J. BRUNNER ASSOCIATES
MECHANICAL ENGINEER
KENNEDY/JENKS ENGINEERS
ELECTRICAL ENGINEER
SWF CONSULTING ENGINEERS
LANDSCAPE ARCHITECT
THEODORE OSBUNDSON & ASSOCIATES
CIVIL ENGINEER
KENNEDY/JENKS ENGINEERS
INSTRUMENTATION ENGINEER
KENNEDY/JENKS ENGINEERS

LETTER	DATE	REVISION DESCRIPTION	DRAWN	APP.
EJB	4-24-88	INDEX		
EJB	11-19-84	BRANCH		
F. Roulas	11-19-84	ASST. DWG. NO.		
R. M. Mabley	11-19-84	SCALE		


**NATIONAL AERONAUTICS AND SPACE ADMINISTRATION
AMES RESEARCH CENTER
MOFFETT FIELD, CALIFORNIA**

NUMERICAL AERODYNAMIC SIMULATION FACILITY

SITE PLAN

258-8401-AI

U.S. GOVERNMENT PRINTING OFFICE: 1981-790-093

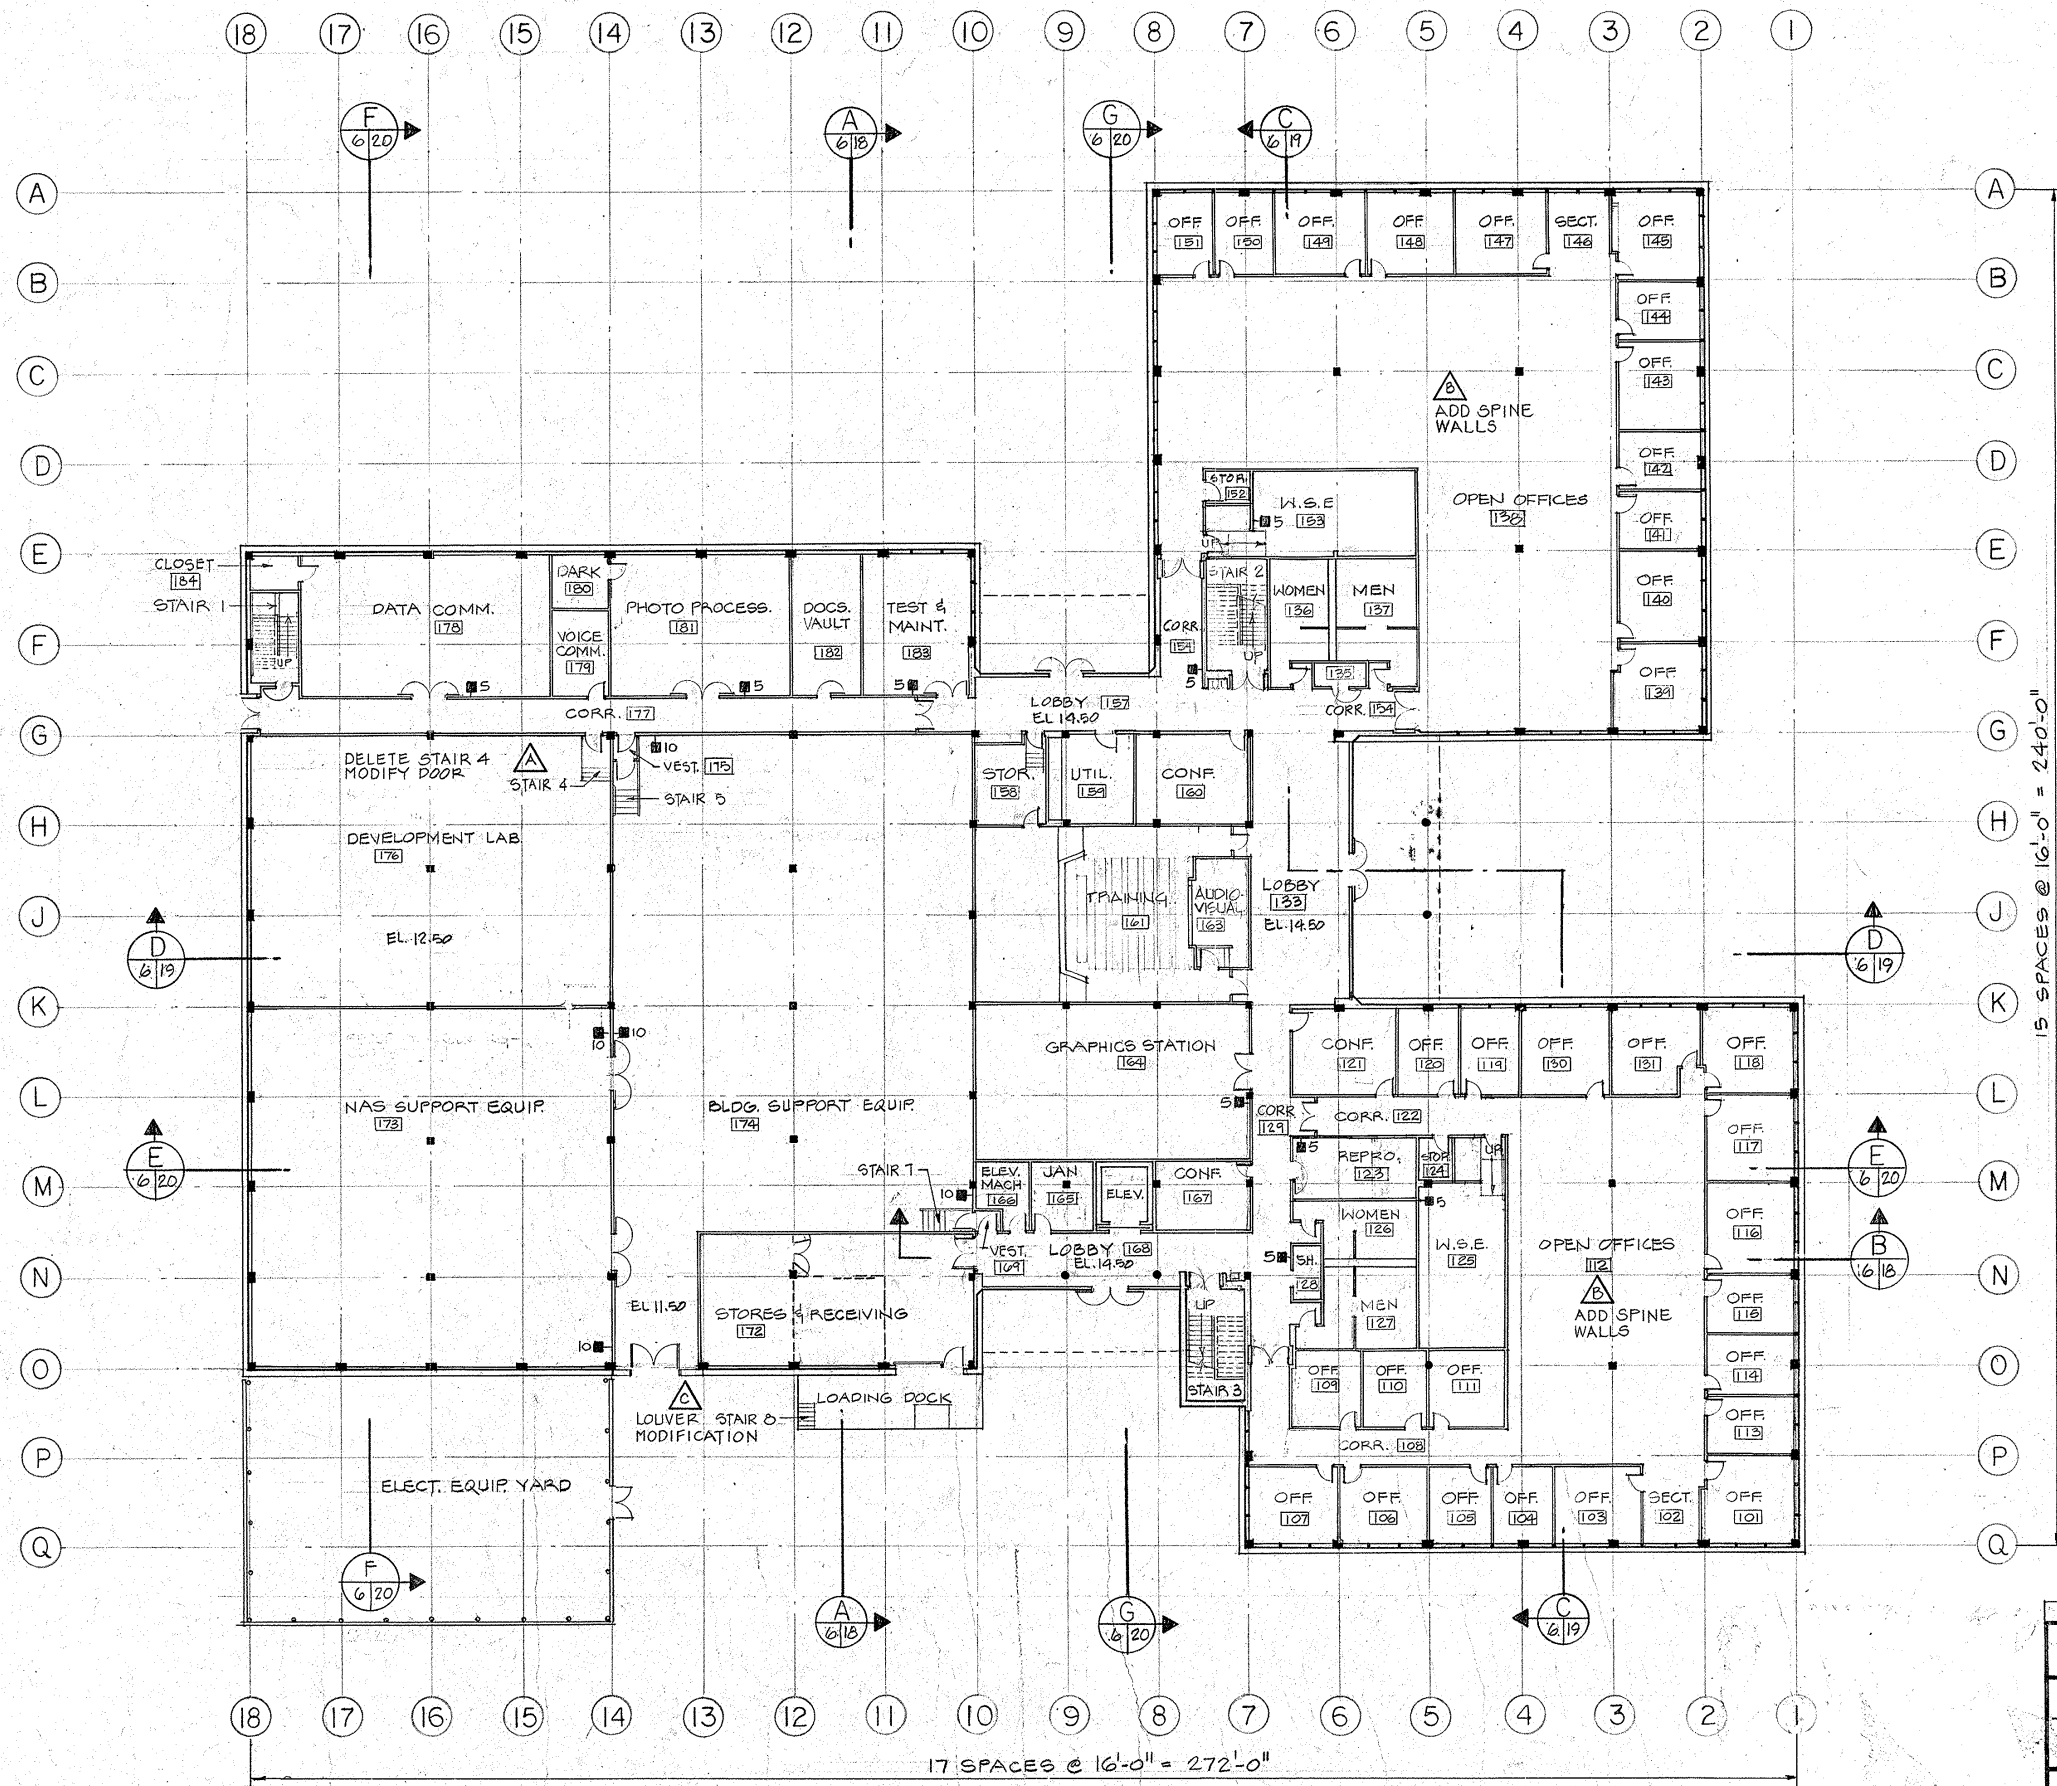

- LEGEND:**
- FIRE EXTINGUISHER CABINETS/BRACKETS
 - SEMI-RECESSED CABINET FOR 5 LB EXTINGUISHER, SEE 11-6/59
 - BRACKET FOR 10-LB EXTINGUISHER

**ECO NO. A 21517
RECORD DRAWING**

To the best of our knowledge, this Drawing has been cross-referenced to appropriate reference documents denoting revisions made during construction.

Mark	PCM	Field Clarification	C drawing
	20		C-14, 15, 16, 17
	16		C-54, 55, 56
	94		C-66


HUNT & COMPANY, ARCHITECTS
W. G. Hunt 03228
 STRUCTURAL ENGINEER
 H. J. BRUNNEN ASSOCIATES
 MECHANICAL ENGINEER
 KENNEDY/JENKS ENGINEERS
 ELECTRICAL ENGINEER
 BWF CONSULTING ENGINEERS
 LANDSCAPE ARCHITECT
 THEODORE OSBUNDSON & ASSOCIATES
 CIVIL ENGINEER
 KENNEDY/JENKS ENGINEERS
 INSTRUMENTATION ENGINEER
 KENNEDY/JENKS ENGINEERS



LETTER	DATE	REVISION DESCRIPTION	DRAWN	APP.
NATIONAL AERONAUTICS AND SPACE ADMINISTRATION AMES RESEARCH CENTER MOFFETT FIELD, CALIFORNIA				
NUMERICAL AERODYNAMIC SIMULATION FACILITY				
PLAN, LEVEL 1				
DRAWN JJK	CHECKED EJB	INDEX 4-24-85	MATERIAL	LIMITS UNLESS NOTED
DESIGN ENGINEER EJB	BRANCH <i>R. J. [Signature]</i>		FRAC.	DEC.
APPROVED <i>[Signature]</i>	ASST. DIR. NO. 11-19-84	SCALE 1/8" = 1'-0"	REV.	

U.S. GOVERNMENT PRINTING OFFICE: 1982 589-900

PLAN, LEVEL 1

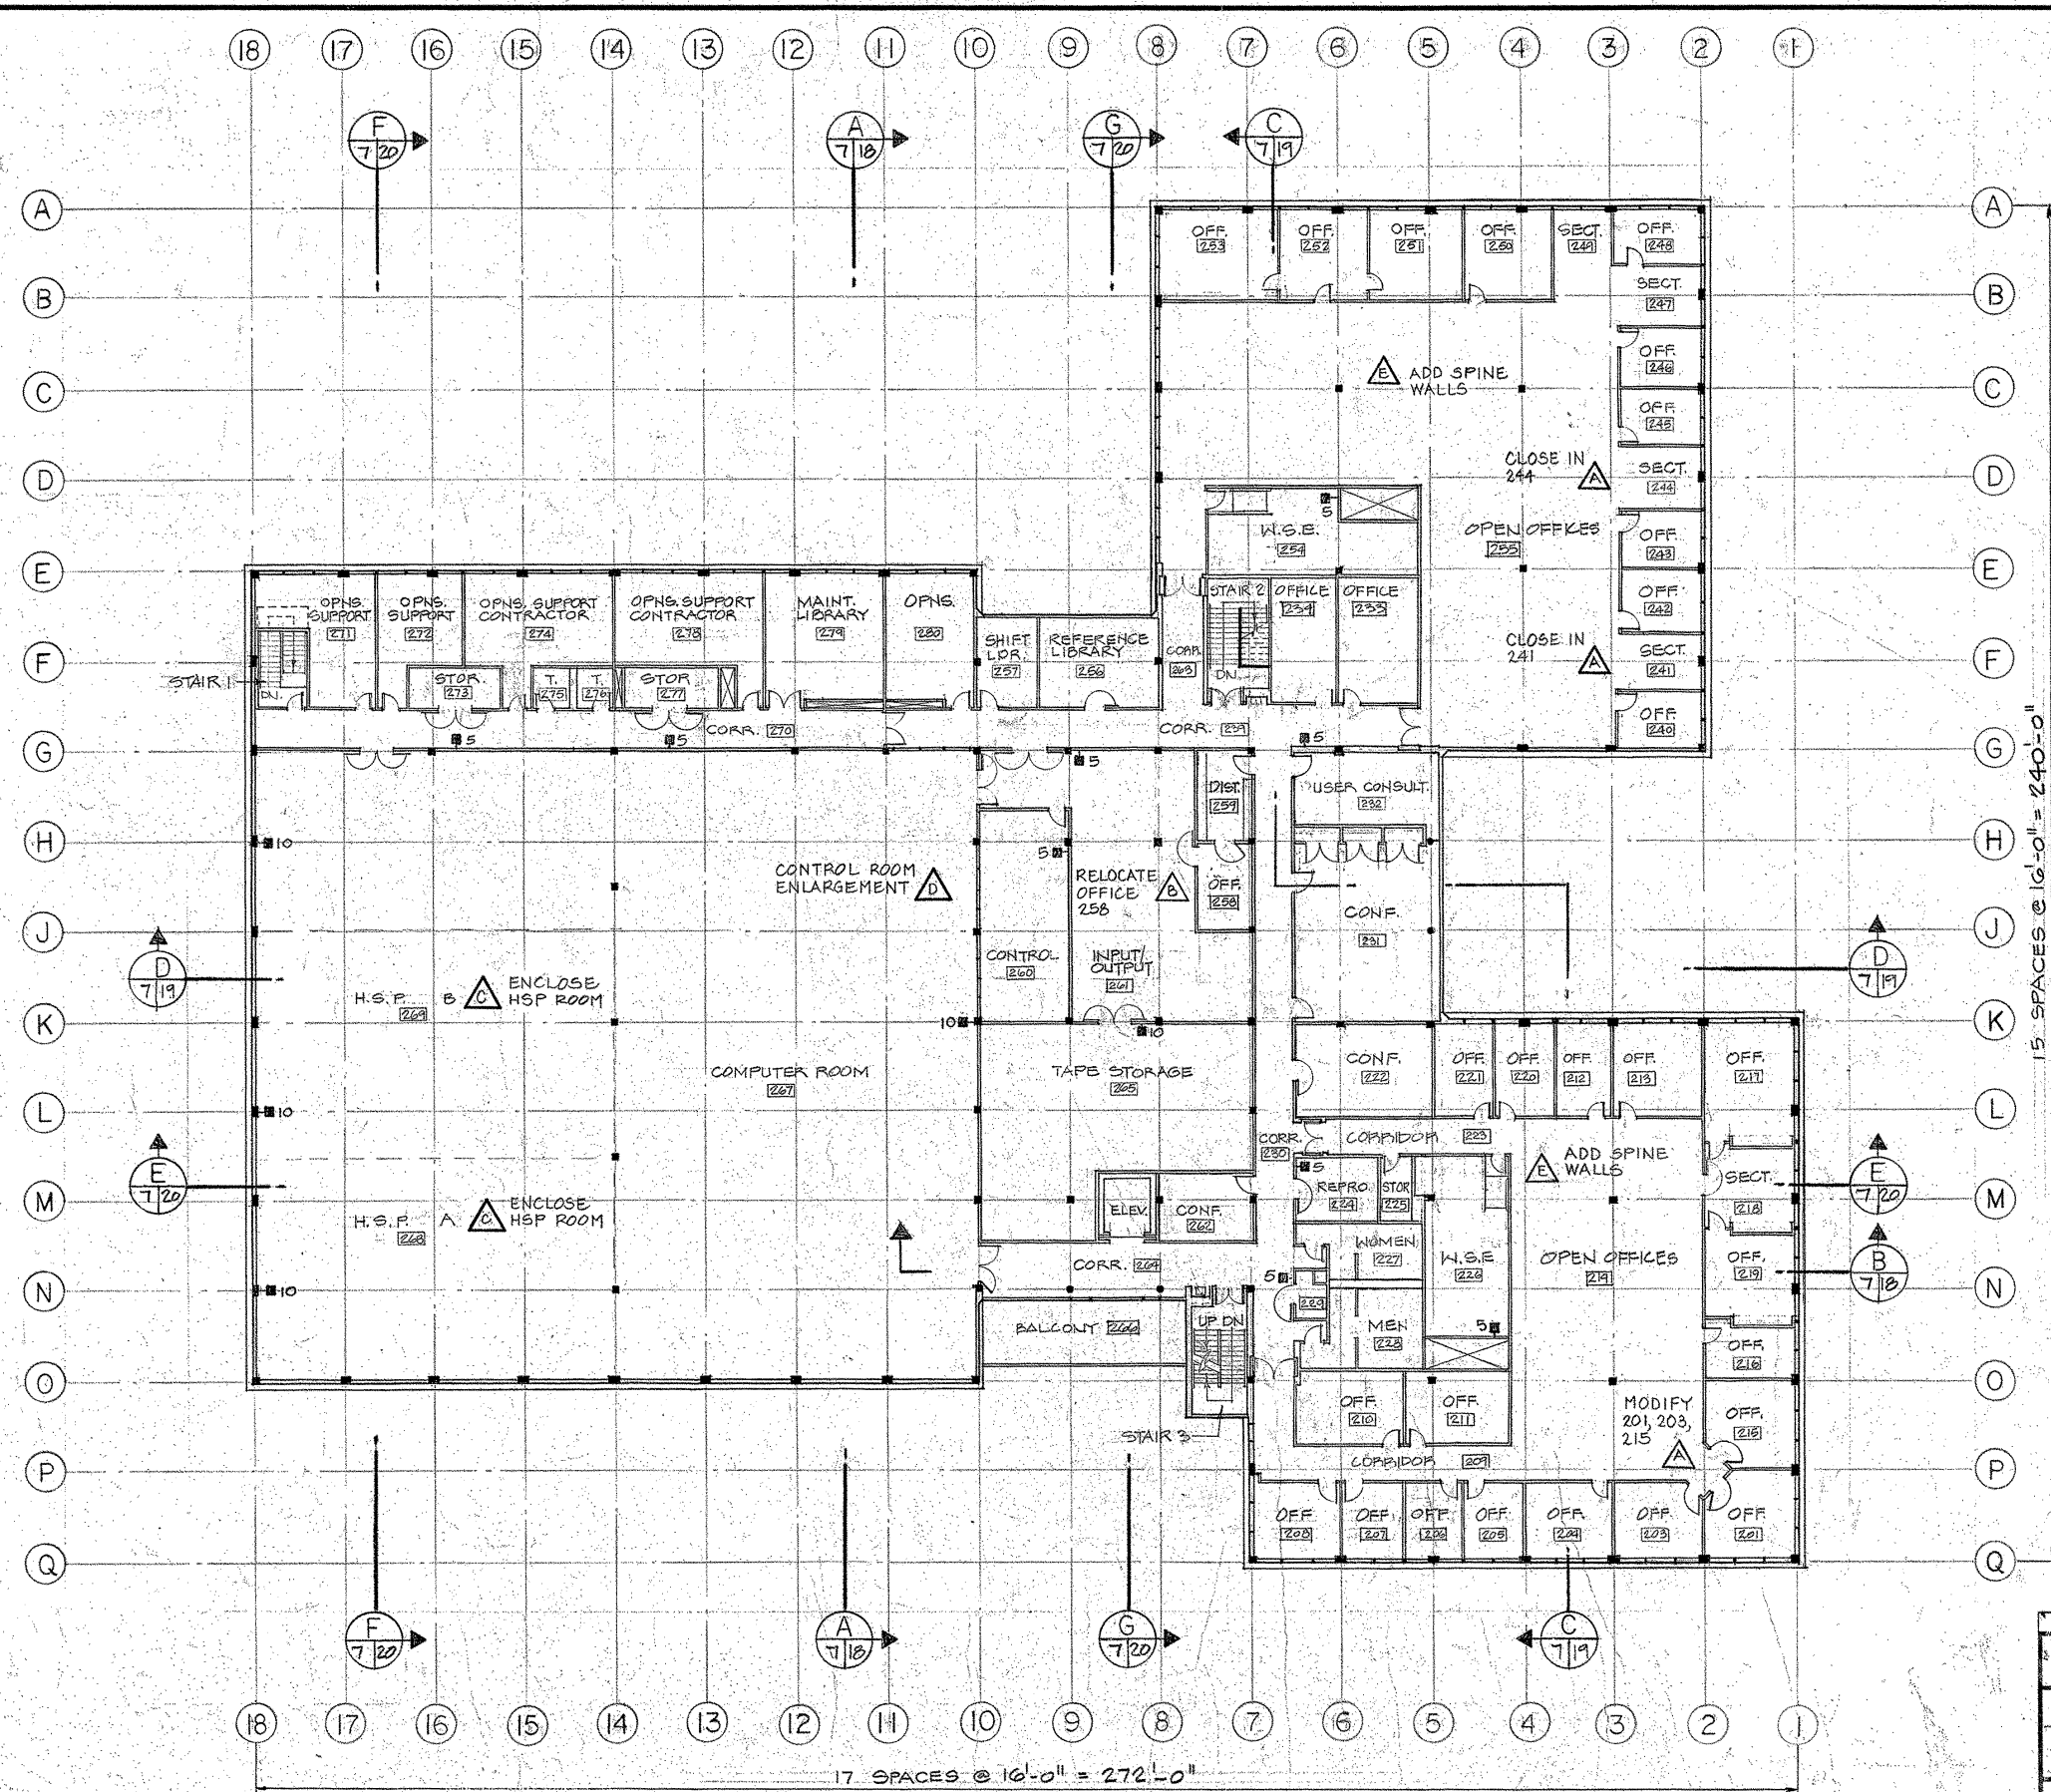


LEGEND:
FIRE EXTINGUISHER CABINETS/BRACKETS
5 SEMI-RECESSED CABINET FOR 5 LB EXTINGUISHER
10 BRACKET FOR 10LB EXTINGUISHER

ECO NO. A 21517 RECORD DRAWING			
To the best of our knowledge, this Drawing has been cross-referenced to appropriate reference documents denoting revisions made during construction.			
Mark	PCM	Field Clarification	C Drawing
22			C-20, 21
52			C-31, 32, 33, 34
55			C-37, 38
59A			C-41, 42
76			C-54, 55, 56

HCO ARCHITECTS 11/5/87

- HUNT & COMPANY, ARCHITECTS**
STRUCTURAL ENGINEER
H.J. BRUNNEN ASSOCIATES
MECHANICAL ENGINEER
KENNEDY/JENKS ENGINEERS
ELECTRICAL ENGINEER
BWF CONSULTING ENGINEERS
LANDSCAPE ARCHITECT
THEODORE OSMUNDSON & ASSOCIATES
CIVIL ENGINEER
KENNEDY/JENKS ENGINEERS
INSTRUMENTATION ENGINEER
KENNEDY/JENKS ENGINEERS

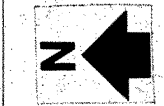

LETTER	DATE	REVISION DESCRIPTION	DRAWN	APP.
NATIONAL AERONAUTICS AND SPACE ADMINISTRATION AMES RESEARCH CENTER MOFFETT FIELD, CALIFORNIA				
NUMERICAL AERODYNAMIC SIMULATION FACILITY				
PLAN, LEVEL 2				
DRAWN JJK	CHECKED EJB	INDEX 4-29-85	MATERIAL	LIMITS UNLESS NOTED
DESIGN ENGINEER EJB	BRANCH R. H. Brown	ASSN. DWG. NO. 11-19-84	FRAC.	DEC.
APPROVED F. Koubla	SCALE 1/4" = 1'-0"		REV.	
258-8401-A7				

U.S. GOVERNMENT PRINTING OFFICE: 1982 589-905





PLAN, LEVEL 2

**ECO NO. A 21517
RECORD DRAWING**

To the best of our knowledge, this Drawing has been cross-referenced to appropriate reference documents denoting revisions made during construction.

Mark	PCM	Field Clarification	C drawing
△	58		C-40
△	81		C-37
△	94		C-66
△		FC99	

HCO ARCHITECTS *WAP* 11/5/87

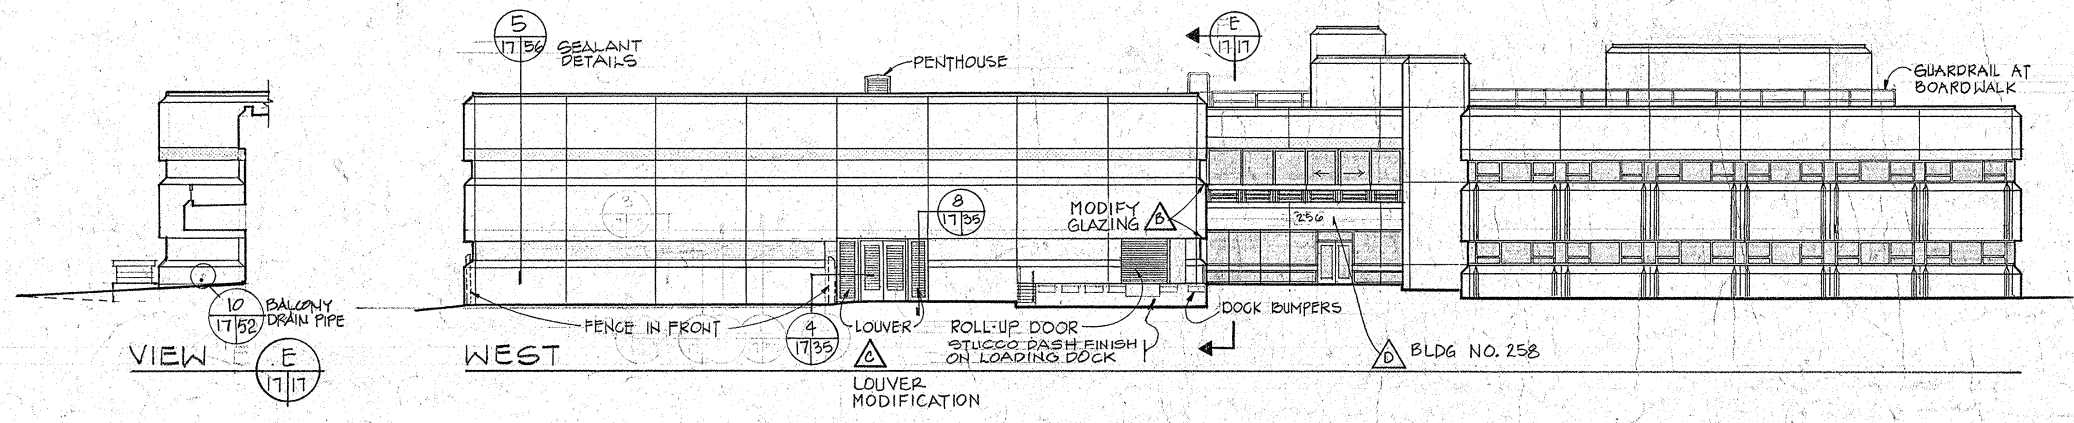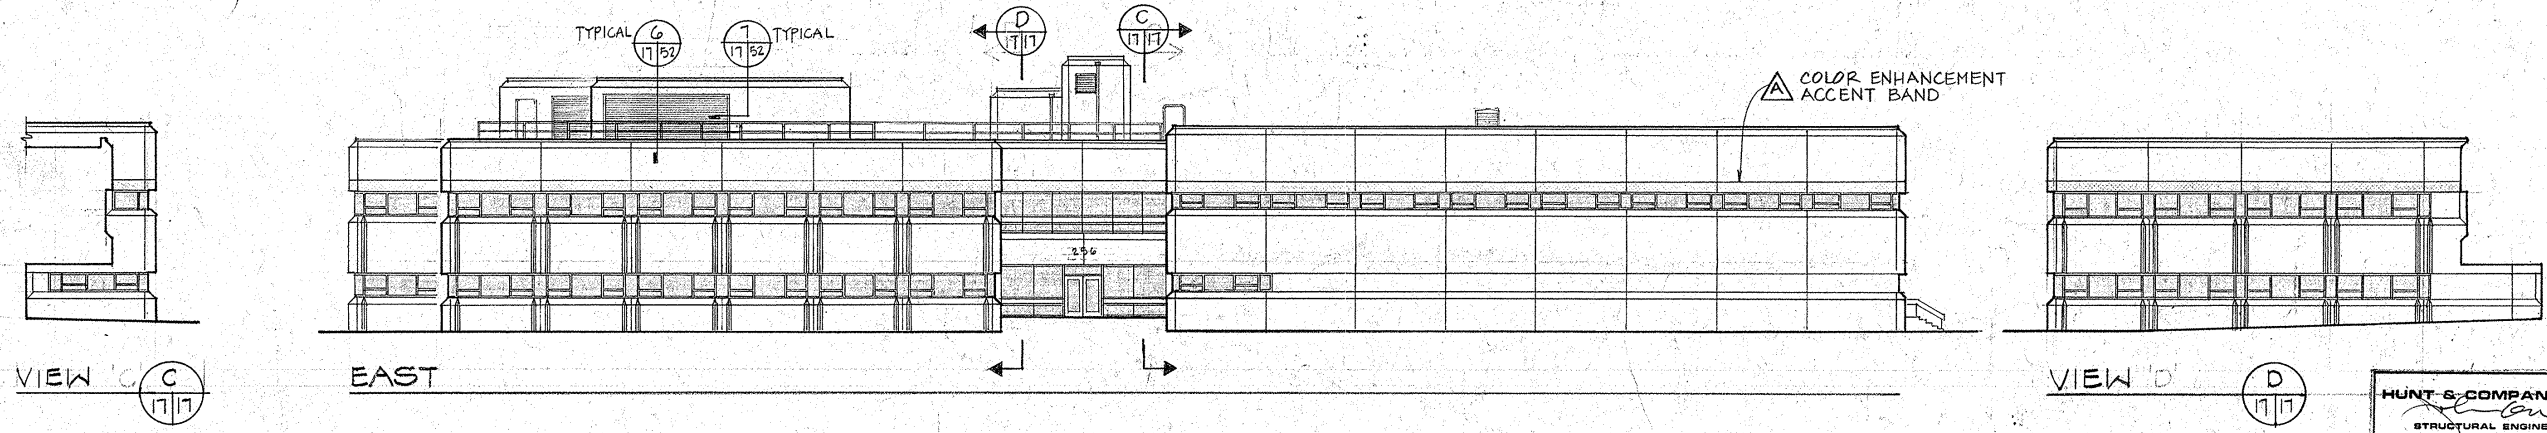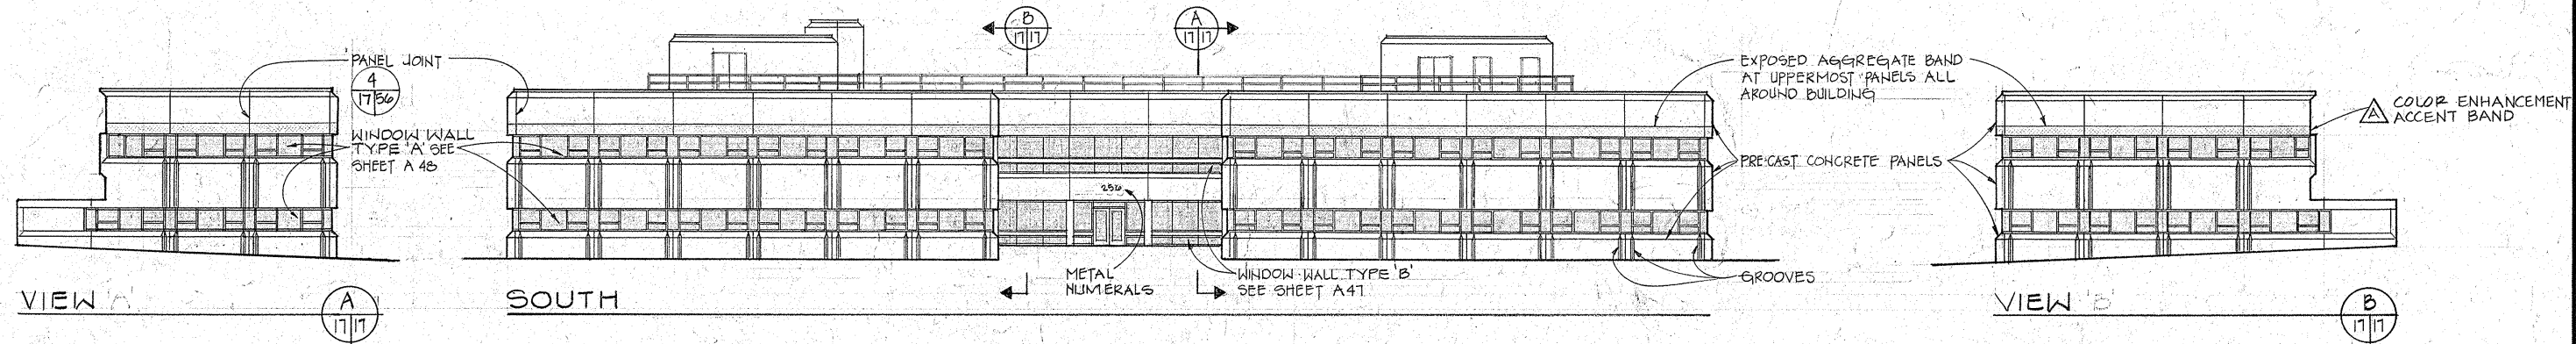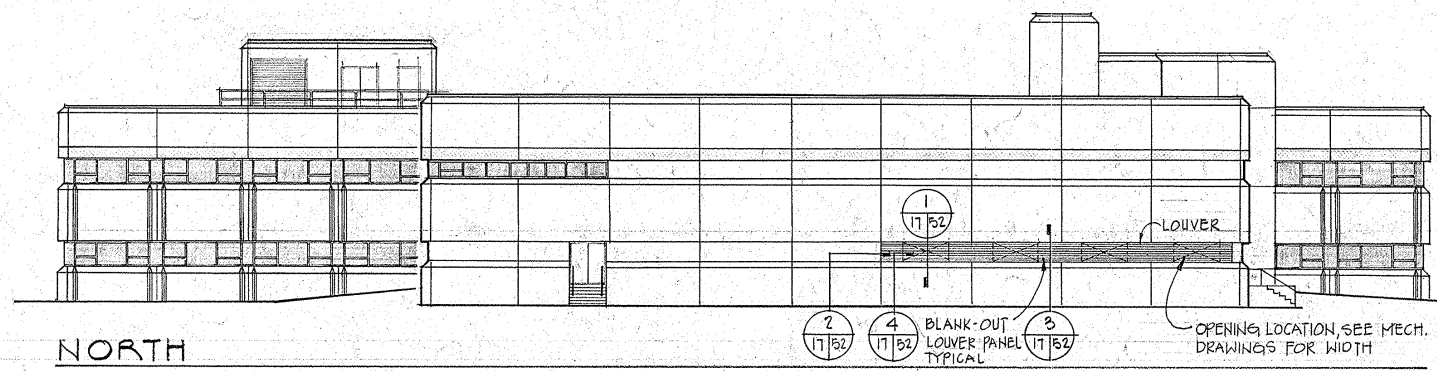


- HUNT & COMPANY, ARCHITECTS**
Wells 03228
- STRUCTURAL ENGINEER
- H.J. BRUNNIER ASSOCIATES
 - MECHANICAL ENGINEER
- KENNEDY/JENKS ENGINEERS
 - ELECTRICAL ENGINEER
- BWF CONSULTING ENGINEERS
 - LANDSCAPE ARCHITECT
- THEODORE OSBUNDSON & ASSOCIATES
 - CIVIL ENGINEER
- KENNEDY/JENKS ENGINEERS
 - INSTRUMENTATION ENGINEER
- KENNEDY/JENKS ENGINEERS


LETTER	DATE	REVISION DESCRIPTION	DRAWN	APP.
NATIONAL AERONAUTICS AND SPACE ADMINISTRATION AMES RESEARCH CENTER MOFFETT FIELD, CALIFORNIA				
NUMERICAL AERODYNAMIC SIMULATION FACILITY				
EXTERIOR ELEVATIONS				
DRAWN KPF DESIGN ENGINEER EJB APPROVED F. Paula APPROVED B. J. Miley	CHECKED EJB INDEX 4-24-85 BRANCH R. H. Brown ASSN. DWG. NO. 11-19-84 SCALE 1/8" = 1'-0"	MATERIAL LIMITS UNLESS NOTED FRAC. DEC. ANG. REV.	A 258-8401-A7D	

U.S. GOVERNMENT PRINTING OFFICE: 1981-790-093

ORIGINAL ELEVATIONS

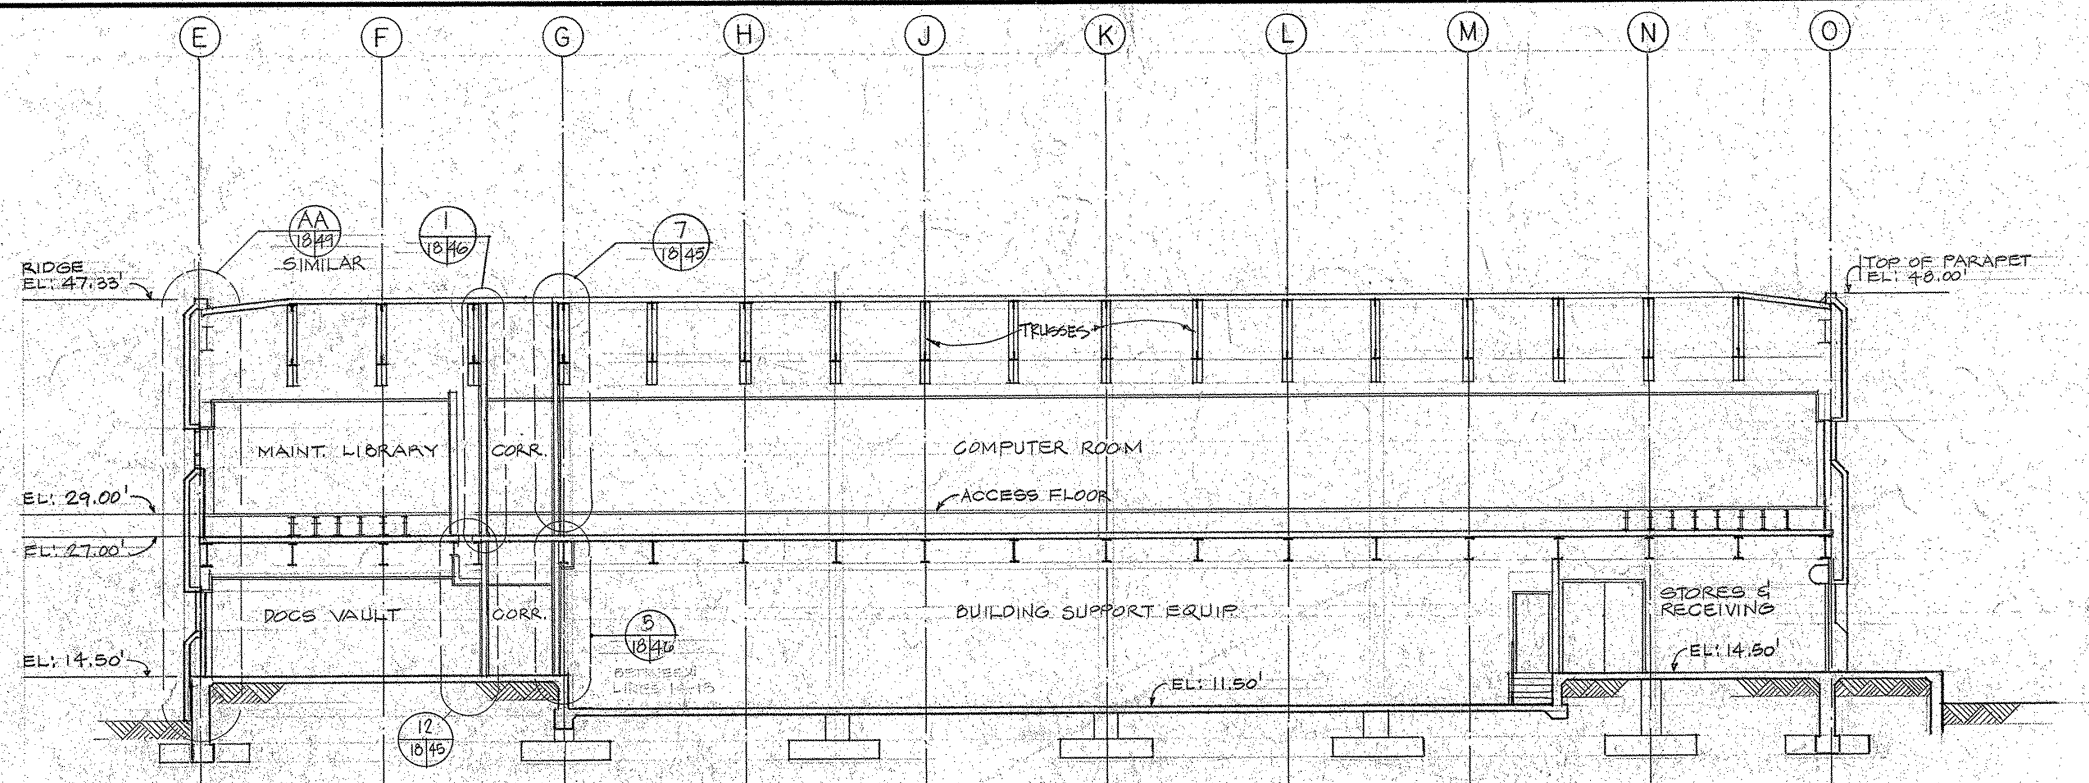

SECTION

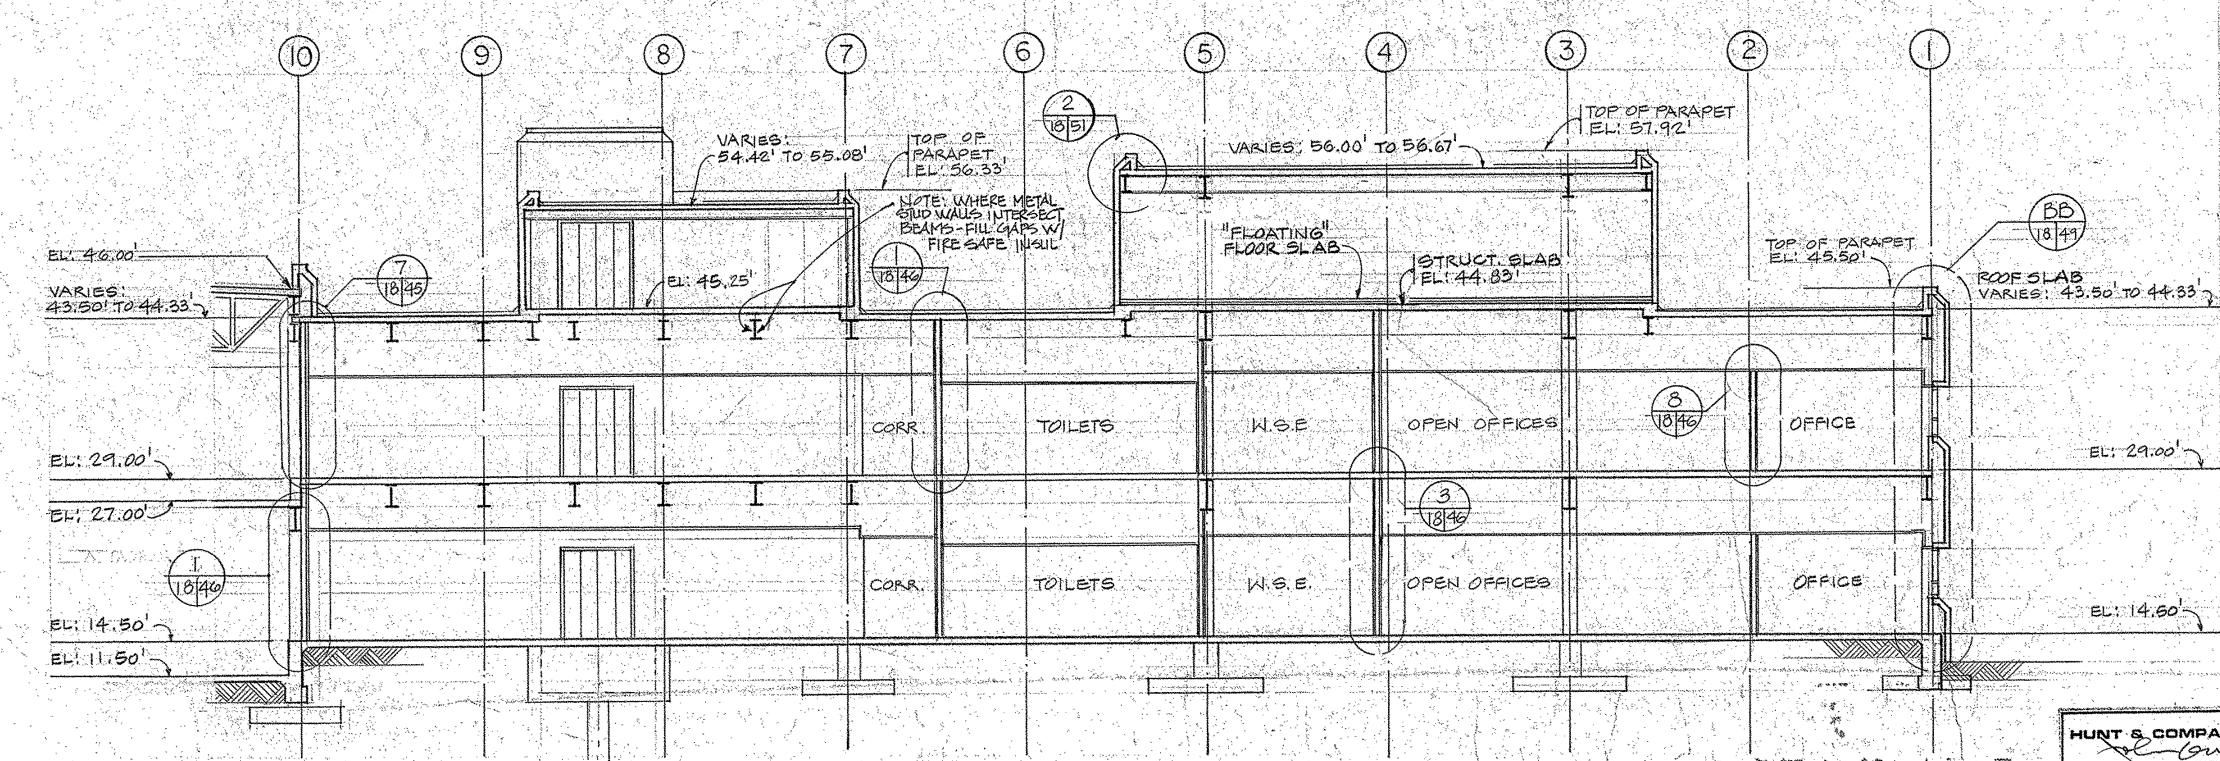

SECTION

**ECO NO. A 21517
RECORD DRAWING**

To the best of our knowledge, this Drawing has been cross-referenced to appropriate reference documents denoting revisions made during construction.

Mark	PCM	Field Clarification	C drawing
A	PD		

HUNT & COMPANY, ARCHITECTS
 STRUCTURAL ENGINEER
 H.J. BRUNNEN ASSOCIATES
 MECHANICAL ENGINEER
 KENNEDY/JENKS ENGINEERS
 ELECTRICAL ENGINEER
 BWF CONSULTING ENGINEERS
 LANDSCAPE ARCHITECT
 THEODORE OSBUNDSON & ASSOCIATES
 CIVIL ENGINEER
 KENNEDY/JENKS ENGINEERS
 INSTRUMENTATION ENGINEER
 KENNEDY/JENKS ENGINEERS

LETTER	DATE	REVISION DESCRIPTION	DRAWN	APP.
A	11/15/87			



**NATIONAL AERONAUTICS AND SPACE ADMINISTRATION
AMES RESEARCH CENTER
MOFFETT FIELD, CALIFORNIA**

NUMERICAL AERODYNAMIC SIMULATION FACILITY

BUILDING SECTIONS

DRAWN	CHECKED	INDEX	MATERIAL	LIMITS UNLESS NOTED
EJB	EJB	4-24-88		
DESIGN ENGINEER	BRANCH			
EJB	R.H. Brown			
APPROVED	ASSN. CHIEF			
F. Brown	11-19-84			
1/8" = 1'-0"				

258-8401-A18

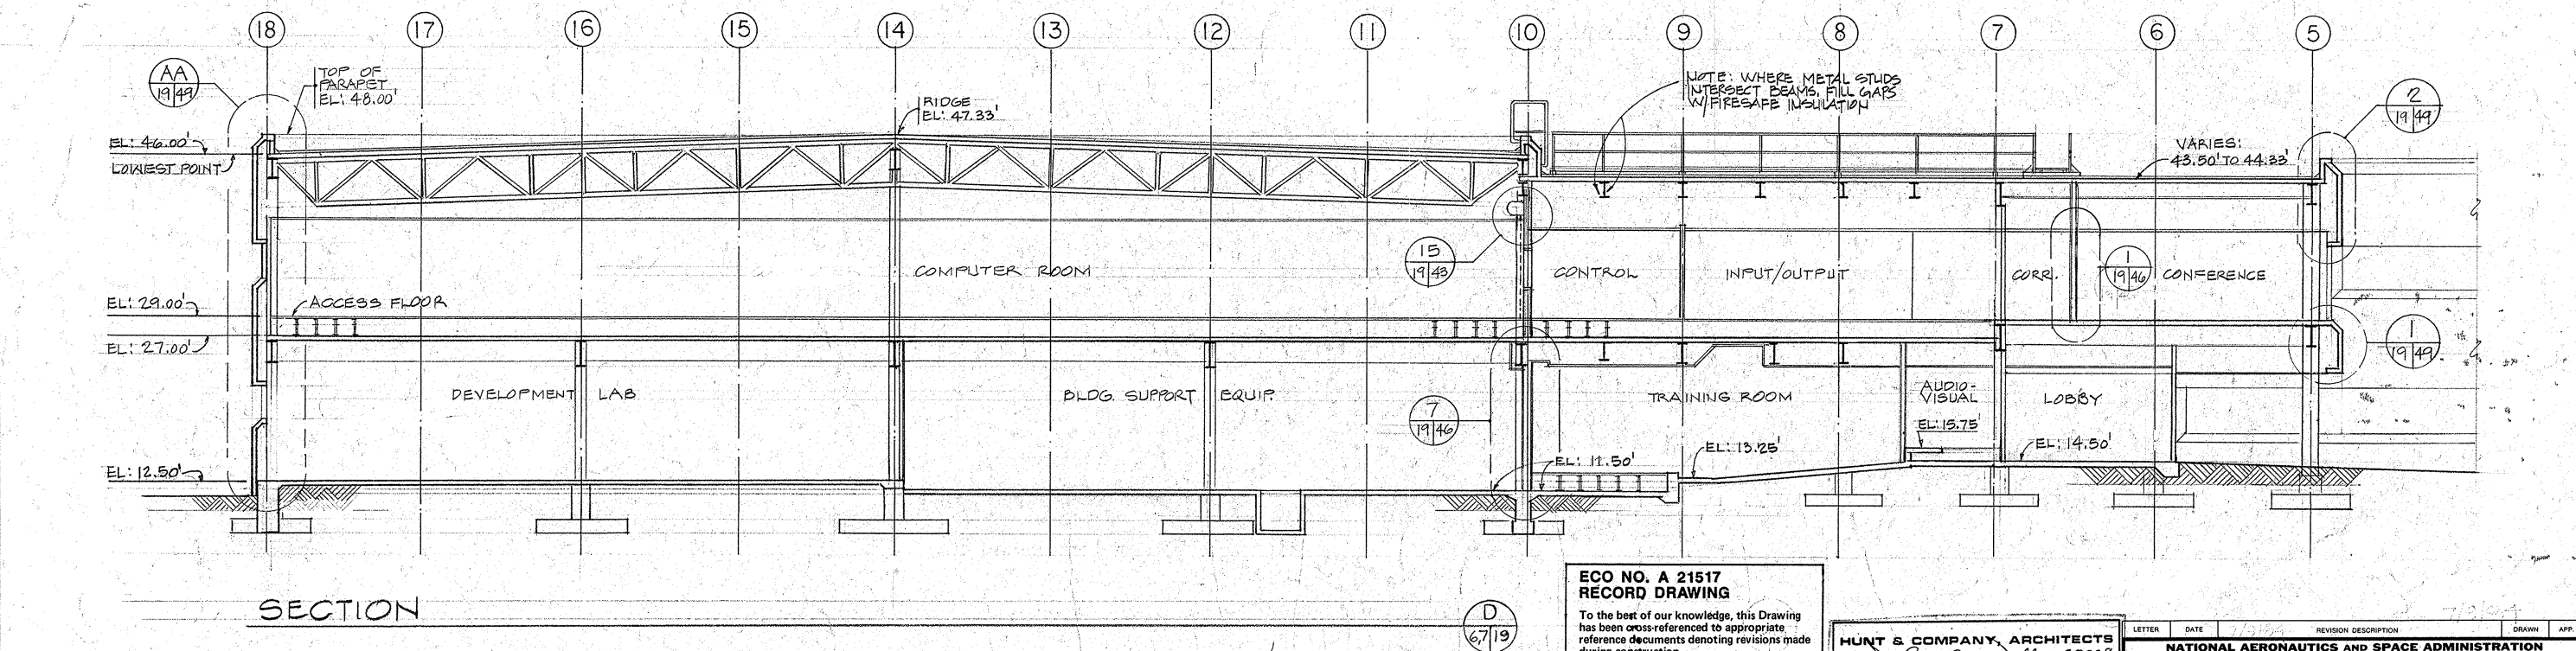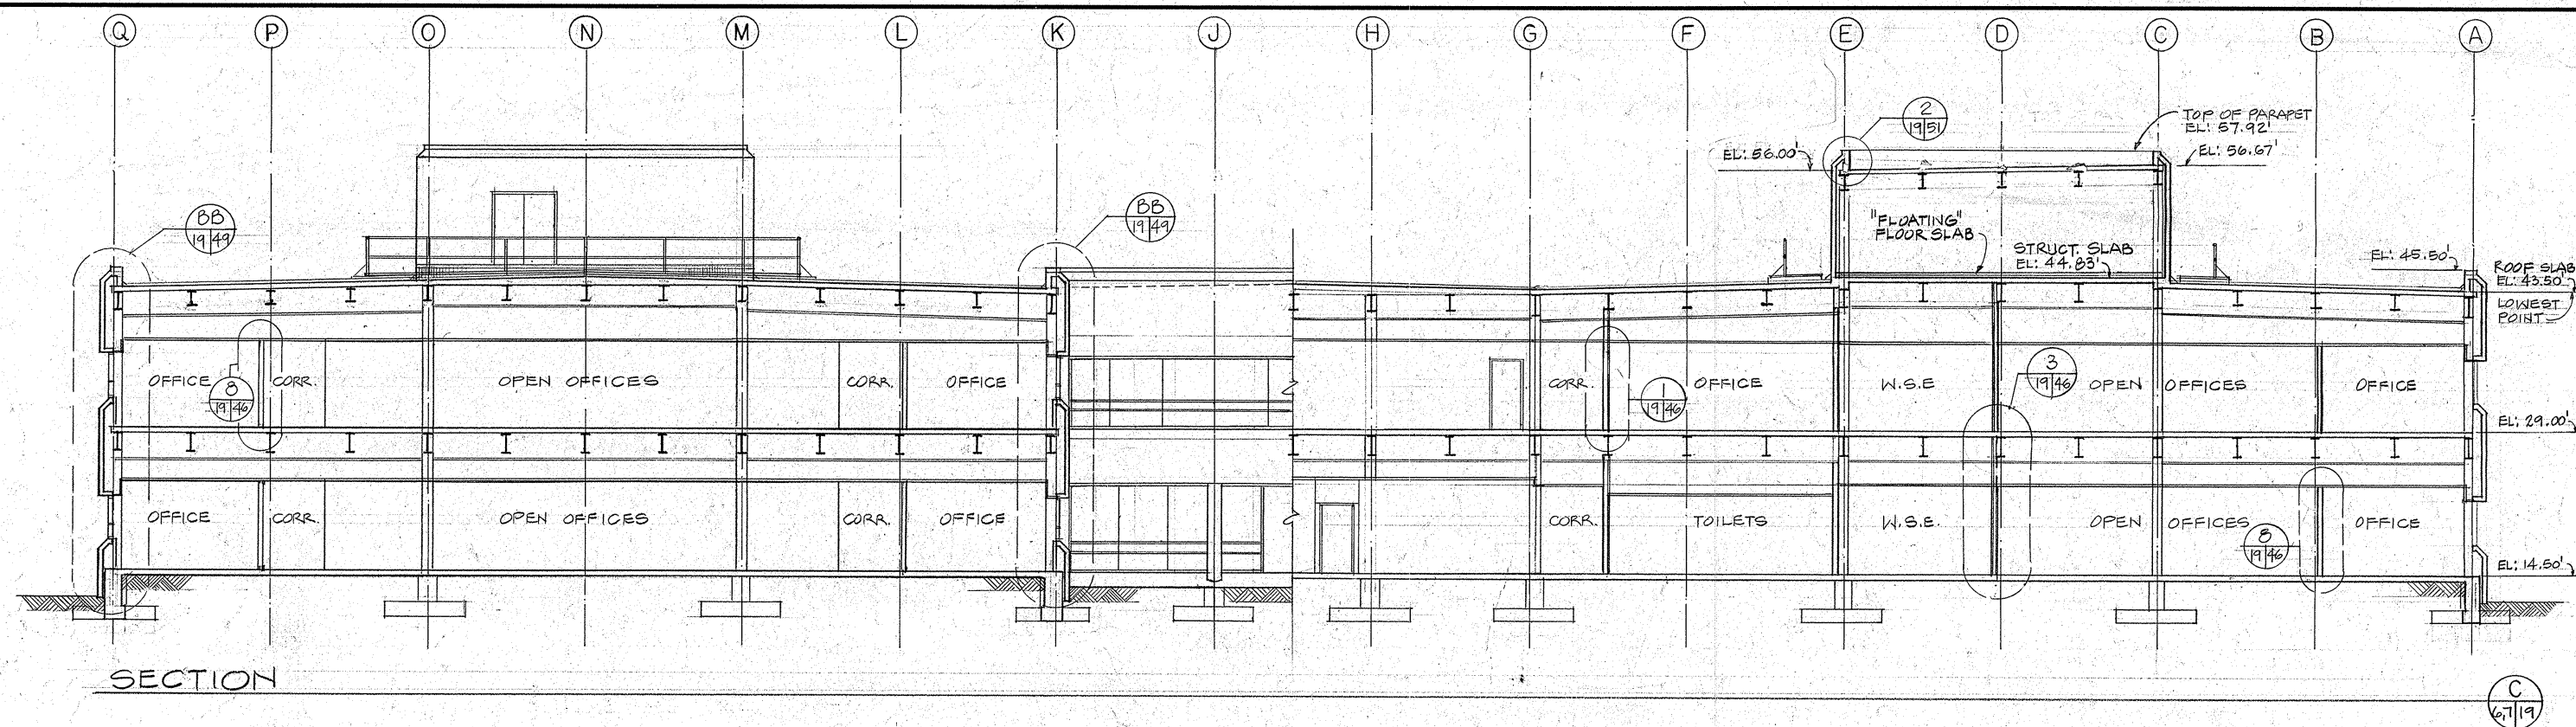

ECO NO. A 21517
RECORD DRAWING

To the best of our knowledge, this Drawing has been cross-referenced to appropriate reference documents denoting revisions made during construction.

Mark	PCM	Field Clarification	C Drawing
A	PS		

HCD ARCHITECTS 11/5/87

HUNT & COMPANY, ARCHITECTS
STRUCTURAL ENGINEER
H.J. BRUNNER ASSOCIATES
MECHANICAL ENGINEER
KENNEDY/JENKS ENGINEERS
ELECTRICAL ENGINEER
BWP CONSULTING ENGINEERS
LANDSCAPE ARCHITECT
THEODORE OSMUNDSON & ASSOCIATES
CIVIL ENGINEER
KENNEDY/JENKS ENGINEERS
INSTRUMENTATION ENGINEER
KENNEDY/JENKS ENGINEERS

LETTER	DATE	REVISION DESCRIPTION	DRAWN	APP.
NATIONAL AERONAUTICS AND SPACE ADMINISTRATION AMES RESEARCH CENTER MOFFETT FIELD, CALIFORNIA NUMERICAL AERODYNAMIC SIMULATION FACILITY BUILDING SECTIONS				
DRAWN EJB	CHECKED EJB	INDEX 4-24-88	MATERIAL	LIMITS UNLESS NOTED
DESIGN ENGINEER EJB	BRANCH R. P. Brown	ASSN. DWG. NO. 11-19-84	FRAC.	DEC.
APPROVED F. Rouba	SCALE 1" = 1'-0"	REV.	A 258-8401-A19	

**NASA, 25th Shuttle Anniversary,
The Impact of High-End Computing on the Space Shuttle Program**



The Impact of High-End Computing on the Space Shuttle Program

High-end computing and computational fluid dynamics (CFD) have played a key role in improving and enhancing Shuttle performance, reliability, and safety for more than two decades. The NASA Advanced Supercomputing (NAS) Division has been developing CFD-based high-fidelity design and analysis tools, which are being employed to help analyze today's problems, as well as guiding design decisions for future vehicles. The following captures some of the high-level, Shuttle-related events supported by the NAS Division and its supercomputing resources.



The Cray XMP supercomputer, used to facilitate the design of the two-duct hot gas manifold, was the NAS Division's first supercomputer—with one processor and a processing capability of 0.21 Gigaflops or roughly 210 million operations per second. (Photo courtesy of NAS Division)

Hot Gas Manifold Redesign


The Space Shuttle Main Engine (SSME), designed in the 1970s, is still the most sophisticated reusable rocket engine in the world today. Since its initial design, NASA has continued to increase reliability and safety of Shuttle flight through a series of enhancements, including major design changes to the hot gas manifold and turbopump.

The original three-duct hot gas manifold in the powerhead, considered the backbone of the SSME, was replaced by two enlarged ducts. The new two-duct design, facilitated with the use of Cray XMP and Cray T3E supercomputers, and CFD techniques developed by NAS researchers, enhanced overall engine performance and reliability. CFD analyses showed that the two-duct design reduced pressure gradients within the system, and lowered temperatures in the engine during operation, which reduces stress on the turbopump and main injector.

After undergoing extensive testing, the newly designed powerhead made its first flight on Discovery's 20th mission (STS-70) in July 1995, and has been used in all subsequent Shuttle missions.



Pictured here is the redesigned two-duct hot gas manifold hardware (new powerhead design), which is considered the backbone of the Shuttle engine, and consists of the main injector and two preburners, or small combustion chambers, in addition to various propellant and oxidizer pumps, ducts, and lines. (Photo courtesy of Rocketdyne)

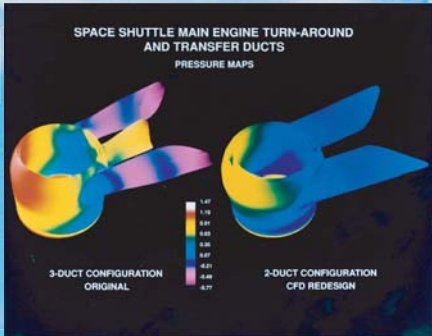


Shown here is a side-by-side comparison of the CFD analyses of the two- and three-duct hot gas manifold designs. White/red represents high pressure, while the blue coloring represents lower pressures. This redesign was the first instance of CFD having an impact in the area of rocket propulsion, and because high-end computing and CFD were so new at the time, code development and analysis were being conducted simultaneously. (Image generated by NASA Ames and Rocketdyne engineers)

Advanced Turbopumps and Flowliners

Since 1985, NASA researchers have been working to provide and enhance a computational framework for design and analysis of the entire fuel supply system of a liquid rocket engine (the Space Shuttle Main Engine's liquid oxygen and liquid hydrogen turbopumps, for example), including high-fidelity unsteady flow analysis.

This effort decreases design costs, improves performance and reliability, and provides developers with information such as transient flow phenomena at startup, impact of non-uniform flows, and impact on the structure. Beginning in 2002, the computational framework was used to investigate the root cause of cracks in the Shuttle engine's fuel-line. In 2004, following the Columbia Shuttle accident, NASA CFD researchers participated in a NASA Engineering and Safety Center-sponsored independent technical assessment investigation of the Shuttle's fuel-line cracks. These results were combined with other analyses and then presented to the Shuttle Program as part of the agency's Return to Flight efforts.

Various computational models have also been developed, and time-accurate computations carried out using this framework to characterize various aspects of the flow field surrounding the flowliner.

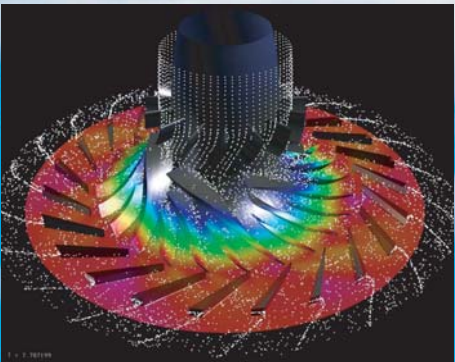

A snapshot of particle traces and pressure contours resulting from the flow through the Space Shuttle Main Engine's impeller and diffuser. (Image generated by Tim Sandstrom/David Ellsworth, NASA Ames Research Center)

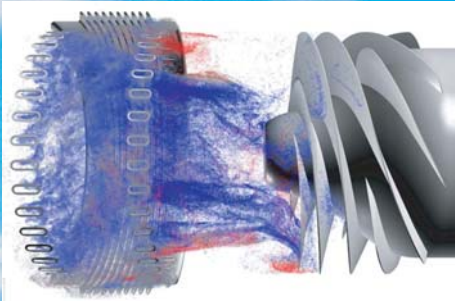


Illustration of unsteady interaction between the backflow and the flow in the bellows cavity—considered one of the major contributors to high-frequency cyclic loading. (Image generated by Tim Sandstrom/David Ellsworth, NASA Ames Research Center)



The Impact of High-End Computing on the Space Shuttle Program

Shuttle Ascent Analysis


OVERFLOW, a computational fluid dynamics program developed in the early 1990s for solving complex flow problems such as designing launch and reentry vehicles, has been applied to a number of Space Shuttle Launch Vehicle and Space Shuttle Orbiter issues over the past two decades. This CFD application has led to an overall better understanding of the aerodynamic loads on the Space Shuttle, and has served as the primary tool for verifying wind tunnel-derived aerodynamic loads during ascent including Orbiter wing, payload bay door, and vertical tail loads.

Following the Shuttle flight STS-27R during which damage was incurred (launched and landed in December 1988), OVERFLOW was used to perform debris analysis. CFD results, which showed that only isolated potential debris sources existed on the vehicle, led to the determination that insulation and ice were the cause of the damage. This analysis has had a huge positive impact on the Space Shuttle Program, leading to increases in safety of flight by minimizing hazardous debris sources; reducing inspection time; minimizing damage on the next flight; and reducing changes to thermal protection system application procedures.

Throughout the 1990s, OVERFLOW was used to support the Shuttle Aerodynamic Loads Verification Program through CFD analysis of the Shuttle Launch Vehicle ascent aerodynamic loads environment. OVERFLOW solutions were used in conjunction with the flight data system, and provided data in areas not covered by flight instruments, yielding a cost savings of approximately \$10M.



This image illustrates the OVERFLOW solution of the Space Shuttle Launch Vehicle flowfield at a Mach number of 1.25. The vehicle surface is color-coded by the pressure coefficient, and the color contours in the flowfield and plumes represent the local Mach number. (Image generated by Reynaldo Gomez, NASA Johnson Space Center)

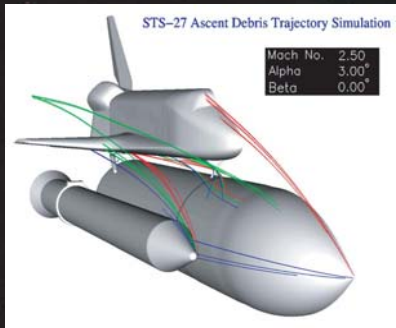

Example of results obtained during analysis of debris trajectories done during flight STS-27R. Here, the flight conditions are at Mach 2.5 and the free stream angle of attack. (Image generated by Reynaldo Gomez, NASA Johnson Space Center)

Shuttle Reentry Analysis


In 1984, NASA Ames CFD researchers obtained the first ever Navier-Stokes solution on an entire reentry vehicle using a Cray XMP supercomputer. Numerical results for turbulent flow around the complete configuration of the Shuttle Orbiter (including canopy wing, orbital maneuvering system pods, and vertical tail) at a low supersonic free-stream Mach number of 1.4 and a zero degree angle of attack was obtained by segmenting the flow field into four regions. Segmentation was advantageous in that it maximized the number of gridpoints, thus increasing resolution or detail of the numerical model. These numerical results, which showed good agreement with experimental data, paved the way for the more elaborate CFD analyses conducted following the Shuttle Challenger accident in January 1986.




*First ever Navier-Stokes solution of the complete configuration of the Shuttle Orbiter. Calculated at Mach 1.4 and zero degree angle of attack. (Image generated by G. Bancroft and F. Merritt, Applied Computational Fluids Branch, NASA Ames Research Center)

Columbia (STS-107) Accident Investigation

In response to the Columbia tragedy of February 1, 2003, the NAS Division employed state-of-the-art CFD codes to simulate steady and unsteady flow fields around Columbia during ascent. Simulation results prompted the use of a higher velocity and kinetic energy in foam impact testing done under the Columbia Accident Investigation Board, which showed massive damage to the Orbiter wing reinforced carbon-carbon panels and damaged T-seals due to foam impact. Simulations also provided insight into the mechanism of debris shedding from the bipod ramp region. Each moving-body simulation required 1,000-5,000 processor hours running on a 1,024-processor SGI Origin supercomputer. Over a very short time period, more than 450 full simulations were run using about 600,000 processor hours.

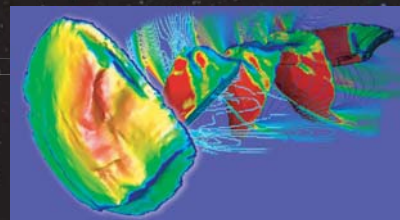

This image shows an unsteady Cart3D simulation used to predict the trajectory of a piece of tumbling foam debris released during ascent. The colors represent surface pressure. (Image generated by Scott Murman, NASA Ames Research Center)

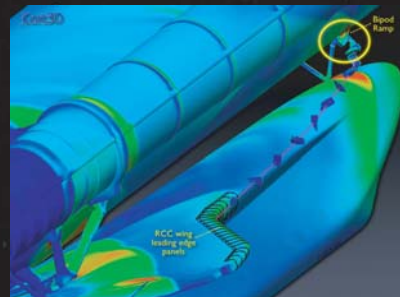

Show here: foam shedding from the bipod ramp region and its path to impact reinforced carbon-carbon panels on the Orbiter wing. (Image generated by Michael Afrosimis, NASA Ames Research Center)


Discovery (STS-114) Mission Support

During the Discovery mission (summer 2005), NAS Division researchers were on stand-by to provide debris transport analysis support using the NASA Ames-developed debris-transport software running on the 10,240-processor SGI Altix supercomputer, Columbia. Several incidences throughout the mission required NAS resources:

- Evaluation of the potential threat from ice forming on one of the solid rocket boosters/external tank (SRB/ET) aft attach struts on launch day. The ice was a result of liquid nitrogen leaking from the ground umbilical connector plate on the ET. Debris simulations were run on Columbia and reported to NASA Johnson within 90 minutes. The threat never materialized, as the final ice inspection from Kennedy reported that no ice was present on this structure.

- Analyses of ice/frost ramp foam debris that were shed 155 seconds into the mission. Within several hours from being tasked by NASA Johnson to analyze the threat of a potential hit on the starboard wing of the Orbiter, NAS researchers delivered an analysis of a complete set of debris simulations indicating that this debris would not cause damage. This conclusion was reinforced by a detailed examination of the on-orbit inspection results, which showed that this debris did not cause any damage to Orbiter tiles or reinforced carbon-carbon panels.

- Analyses of a torn 20 x 3 inch panel of the Advanced Flexible Reusable Surface Insulation blanket located under the commander's window on the Discovery Orbiter using both the debris-transport analysis software and wind tunnel tests. Results indicated that elemental erosion was the primary failure mode, and large debris fragments were unlikely which would have resulted in another extravehicular activity).

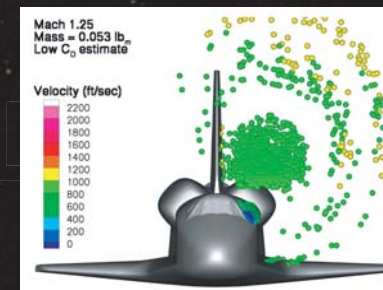


An example of the CFD-based debris-transport analysis conducted on the torn Advanced Flexible Reusable Surface Insulation blanket, showing probable impact locations for debris of a certain size at a certain flight condition (velocity). Results from CFD analyses were used to establish flow conditions (for example, Mach number and angle-of-attack) for wind tunnel test conducted to gather more extensive information about the torn blanket. (Image generated by Reynaldo Gomez, NASA Johnson Space Center)





Post-flight photo of the torn 20 x 3 inch panel of the Advanced Flexible Reusable Surface Insulation blanket located under the commander's window on the Discovery Shuttle. (Image courtesy of NASA Orbiter Ops and Project Mgmt Office)

The Columbia supercomputer, named to honor the downed crew of the Columbia Shuttle, is a 10,240-processor SGI Altix system with a 51.9 trillion-per-second processing capability. Columbia is currently the agency's main supercomputing resource for NASA missions, and is slated to support the upcoming Shuttle launch, STS-121 in summer 2006. (Photo courtesy of NAS Division)

NASA Advanced Supercomputing Facility, Network Roadmap

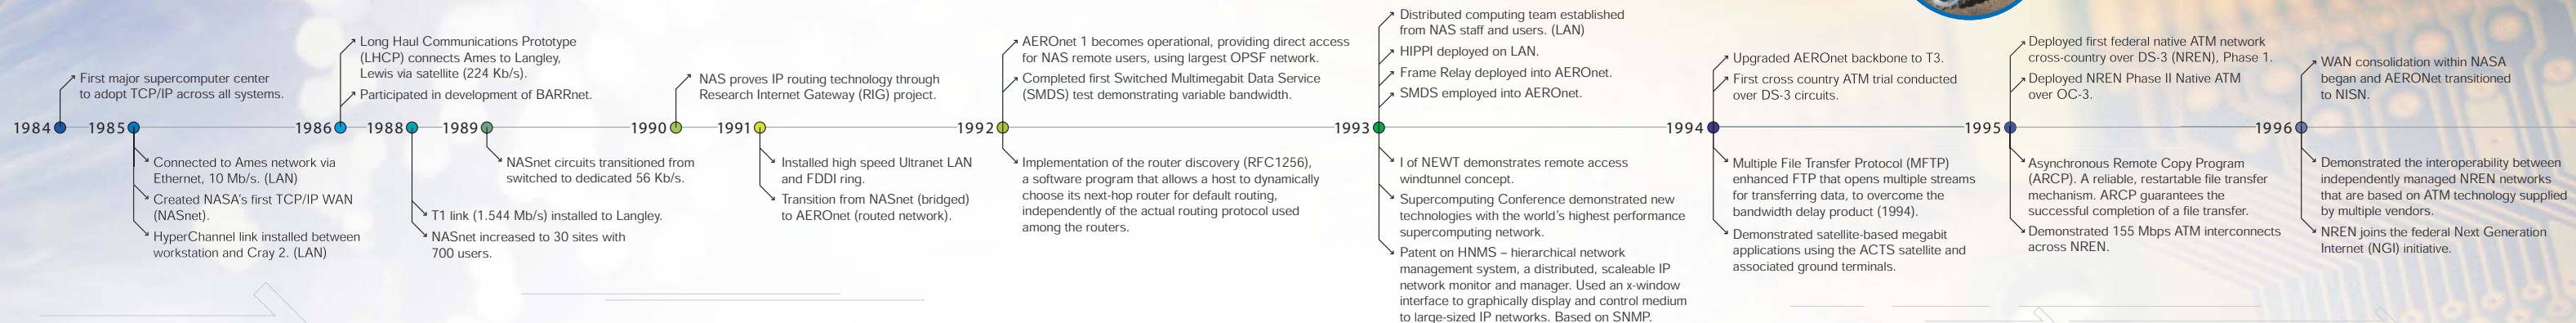

NETWORK ROADMAP TIMELINE

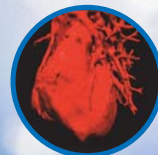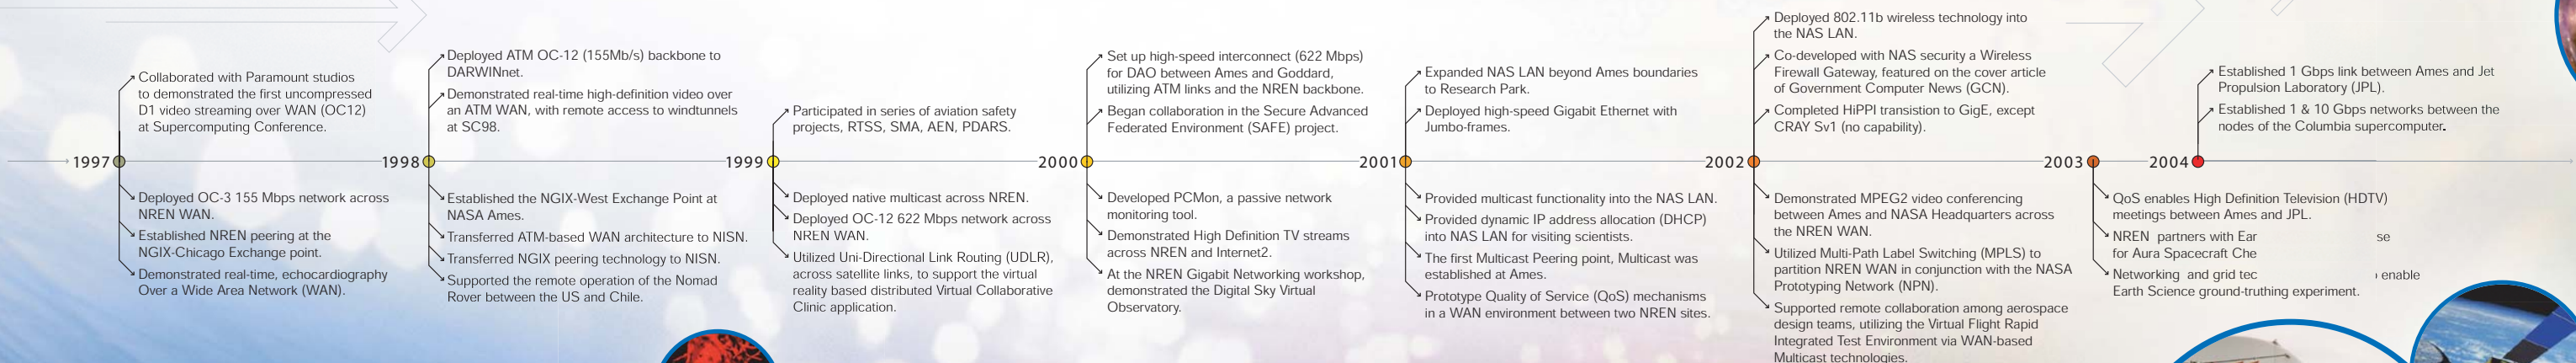

NAS A ADVANCED SUPERCOMPUTING (NAS) FACILITY TIMELINE



www.nasa.gov
www.nas.nasa.gov



1987 • *von Karman*
Convex 3820 • 8 CPUs
Peak Performance: 1.92 GFLOPS



1994 • *Babbage*
IBM SP-2 • 128 CPUs
Peak Performance: 34.05 GFLOPS



1998 • *Steger*
SGI Origin 2800 • 256 CPUs • 300 MHz
Peak Performance: 128.00 GFLOPS



2004 • *Columbia*
SGI Altix 3700 • 10,240 CPUs • 1.5 GHz
Peak Performance: 61.44 TFLOPS



1987 • *Pierre*
Thinking Machines CM-2 • 1,024 CPUs
Peak Performance: 14.34 GFLOPS



1990 • *LaGrange*
Intel iPSC/860 • 128 CPUs
Peak Performance: 7.68 GFLOPS



1993 • *Boltzmann*
Thinking Machines CM5 • 128 CPUs
Peak Performance: 16.38 GFLOPS



1996 • *Newton*
Cray J90 • 36 CPUs
Peak Performance: 7.20 GFLOPS




2001 • *Chapman*
SGI Origin 3800 • 1,024 CPUs • 600 MHz
Peak Performance: 1.23 TFLOPS



2004
Cray X1 • 16 CPUs • 800 MHz
Peak Performance: 51.20 GFLOPS



1985 • *Navier* – 1987 • *Stokes (pictured)*
Cray 2 • 4 CPUs
Peak Performance: 1.95 GFLOPS

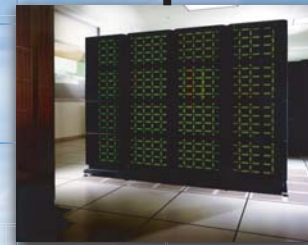

1993 • *Grace*
Intel Paragon • 208 CPUs
Peak Performance: 15.60 GFLOPS



1999 • *Lomax*
SGI Origin 2800 • 512 CPUs • 400 MHz
Peak Performance: 409.60 GFLOPS



2003 • *Kalpana*
SGI Altix 3000 • 512 CPUs • 1.3GHz
Peak Performance: 2.66 TFLOPS



1985
Cray X-MP 12 • 1 CPUs
Peak Performance: 0.21 GFLOPS



1988 • *Reynolds*
Cray Y-MP • 8 CPUs
Peak Performance: 2.54 GFLOPS



1993 • *von Neumann*
Cray C90 • 16 CPUs
Peak Performance: 15.36 GFLOPS



1997 • *Turing*
SGI Origin 2000 • 24 CPUs • 195 MHz
Peak Performance: 9.36 GFLOPS



2001 • *Bright*
Cray SV1ex • 32 CPUs • 500 MHz
Peak Performance: 64.00 GFLOPS



1993 • *Eagle*
Cray C90 • 8 CPUs
Peak Performance: 7.68 GFLOPS

1984 1985 1986 1987 1988 1989 1990 1991 1992 1993 1994 1995 1996 1997 1998 1999 2000 2001 2002 2003 2004 2005

Between 1985 and 2004, the NAS Facility increased its peak computing speed by 260,000 times

1 gigaflop = 1 billion floating point operations/second • 1 teraflop = 1 trillion floating point operations/second

**Letter from Keith Venter, Facility Historic Preservation Officer, NASA Ames,
to Milford Wayne Donaldson, FAIA, State Historic Preservation Officer, 12 July 2006**

July 12, 2006

Mr. Milford Wayne Donaldson, FAIA, State Historic Preservation Officer
Office of Historic Preservation
Department of Parks and Recreation
P.O. Box 942896
Sacramento, CA 94296-0001

Re: Historic Resources Associated with the Space Shuttle Program

Dear Mr. Donaldson,

NASA Headquarters, in conjunction with the National Parks service, has begun a review of historic resources that have been associated with the Space Shuttle Program. The objective of this process is to identify resources that may qualify for listing on the National Register of Historic Places as the Space Shuttle program approaches the end of its era. The Space Shuttle program was initiated on January 1972 by President Richard Nixon and ushered in the era of reusable space flight vehicles that were designed to assist in the building of the Space Station. The historic values of this program, like the Apollo-era program, which preceded it, are embodied in the buildings, structures and objects within the NASA centers that contributed to the Space Shuttle program.

Attached you will find a document called Evaluating Historic Resources Associated with the Space Shuttle Program: Criteria of Eligibility for Listing in the National Register of Historic Places. Ames Research Center, as well as other NASA installations, plans on using the criteria contained in this document to screen Space Shuttle era buildings and objects at the Center that may have potential for eligibility to the NRHP.

Ames Research Center plans to have a draft report by early October 2006 for SHPO review. We would greatly appreciate an expedited review of the draft report.

Sincerely,

Keith Venter
Facility Historic Preservation Officer
Ames Research Center

Attachment: *Evaluating Historic Resources Associated with the Space Shuttle Program: Criteria of Eligibility for Listing in the National Register of Historic Places.*

**CoF Project Initiation Form –
N234A Steam Vacuum System (SVS) Vacuum Ejector and Boiler Control System**

CoF Project Initiation Form

Proposed Project Title: N234A Steam Vacuum System (SVS) Vacuum Ejector and Boiler Control System			
Date: 04/19/05	Proposed FY: 2007	Bldg. No. N234A	Prelim. Cost Estimate: \$1.587M
Category: (Choose PD or MS, then indicate Discrete or Minor)	Program Direct:	Discrete:	Minor:
	Mission Support: X	Discrete:	Minor:
Org. Code: TSF	Advocate: Joseph Hartman	User: (If not Advocate)	Cost Estimator:
M/S: 229-4	Ext: 4-5269		

Project Identification

Summary Project Description:

Explain what facility or environmental related work needs to be done at an overview level.

The Steam Vacuum System (SVS) is comprised of a vacuum ejector system and steam-generating boiler. The vacuum ejector system is a large-capacity pumping system driven by five stages of series-connected steam ejectors and is used to create the vacuum conditions required by Arc Jet Complex operations. As the mass flow requirement of the test facility's arc jet increases, the vacuum pressure the SVS maintains must also increase and the stages are ramped back, accordingly, in series. Higher vacuum conditions, at lower flow rates, require more stages to be activated.

The steam flow required for ejector operation is provided by a Babcock and Wilcox M-type express boiler that has been modified to burn natural gas. The boiler is capable of producing 210,000 pounds of saturated steam per hour at a pressure of 425 psig. After leaving the boiler, the steam is passed through a pressure-reducing valve. The output at the downstream side of the valve is superheated steam at 265 psig. The system's pumping capability is obtained by injecting this superheated steam flow through the ejector nozzles into the converging-diverging diffuser of the ejector. The high velocity jets of steam issuing from the nozzles entrain the arc jet gas, and the velocity of the mixture is then converted into pressure in the diffusers.

The current PLC, flowrate/level controllers, and ejector pressure controllers are working on borrowed time. The PLC in use that starts, stops, and controls all active safety mechanisms is nearly 23 years old. The hardware to maintain the system is no longer produced and must be acquired through third party module refurbishers. The laptop interface providing program

CoF Project Initiation Form

editing and diagnostics is 15 years old and unreliable. Unfortunately a laptop of this vintage is the only type capable of running the PLC's software, and few reliable laptops of its age exist which can replace it. The flowrate/level controllers maintain fuel, air, and water flowrates to the boiler's burners and steam drum. The current controllers are nearly 10 years old and are no longer supported by the manufacturer. They also require a vintage computer for graphing and reprogramming the control curves. Communications with two of the controllers has become intermittent and it is expected that the remaining controllers will exhibit similar problems. The controllers at the vacuum ejector panel allow operators to modulate the steam pressures to the ejectors for optimum performance. At 26 years of age the controllers cannot be reliably tuned, which leads to wide swings past their set points. Pump down times are increased when these swings cause the uncontrolled dumping of non-motive steam by the ejectors. It takes additional time for the ejector system to pump out and condense this extra steam. This, in turn, delays testing

Justification:

Should include justification for urgency and impact to Center Mission. Give specific reference to enterprises or programs/projects where possible.

The SVS is an integral part of the Arc Jet Complex, which simulates the reentry conditions for thermal protective materials. It provides the necessary vacuum condition to ignite the arc jet and pumping action to maintain test chamber vacuum during arc jet operation. Without its continued operation, the Arc Jet Complex would not be able to operate.

Current mission testing for the Arc Jet Complex includes:

- In-Space Propulsion Program (ISP)
- X-37 prototype reusable launch vehicle program
- Space Shuttle Return to Flight (RTF) Testing
- Space Shuttle External Tank (ET) Program
- Mars Scientific Laboratory (MSL) Program

Without the continued operation of the SVS these programs could not be performed at the Arc Jet Complex.

Project Scope, Elements:

This project will consist of the following elements:

- 1) Replacement and reprogramming of the PLC rack and modules
- 2) Replacement and reprogramming of the flowrate/level controllers
- 3) Replacement of the steam ejector controllers
- 4) Replacement of the West side blower valve actuator
- 5) Replacement of boiler and blower indicators
- 6) Replacement and relocation of current to pressure transducers
- 7) Shakedown and validation testing of the boiler and ejector control systems.

CoF Project Initiation Form

Cost Estimate Information, Miscellaneous Supporting Materials:

Breakdown should match scope, and elements from above and include an estimate for design.

The cost estimate below is preliminary. An engineering study has yet to be conducted to refine the projected cost and scope details.

PLC Hardware	\$0.098M
Flowrate/Level Controllers	\$0.042M
Steam Ejector Controllers	\$0.046M
Blower Shutter Valve Actuator	\$0.017M
Current to Pressure Transducers	\$0.028M
Boiler and Blower Indicators	\$0.042M
Labor: Design	\$0.156M
Installation	\$0.460M
IST	\$0.387M
Documentation	\$0.039M
Construction Management	\$0.012M
Contingency	<u>\$0.259M</u>
Construction Total	\$1.587M

CoF Project Initiation Form

ENVIRONMENTAL CHECKLIST

Part A:

1. Will this activity result in changes of potable water use greater than 851,000 gallons/year
2. Will this activity result in a change in employment levels greater than 620 people?
3. Will there be any construction or other activity north of Allen Road (flood plain and wetlands areas)?
4. Will there be any action which could or will affect any threatened or endangered species (north Allen Road)?
- 5) Will there be any action affecting areas of historical (Moffett Shenandoah Plaza area, Hanger One) or archaeological significance (directly west of the OARF)?

Yes	No	Maybe
	X	
	X	
Part B:

- 1) Discharge of any substances into the air, surface or ground water, sanitary sewer, or soils.
- 2) Removal of vegetation or destruction of wildlife habitat or grading activities.
- 3) Acquisition, use, generation, storage, or disposal of any toxic or hazardous substances.
- 4) Generation of hazardous, toxic, or radiological wastes.
- 5) Generation of ionizing or non-ionizing radiation.
- 6) Generation of high noise levels (above 80 dBa).
- 7) Activities resulting in changes of greater than 2,200,000 KWH of electricity, or 3,130,000 CF of natural gas per year for Ames' energy consumption.
- 8) Use of pesticides, including insecticides, herbicides, fungicides, and rodenticides.
- 9) Construction or modification of a sewage collection or transmission system.

Yes	No	Maybe
	X	
	X	
**CoF Project Initiation Form -
Arc Jet Complex Data Acquisition Systems Upgrade**

CoF Project Initiation Form

Proposed Project Title: Arc Jet Complex Data Acquisition Systems Upgrade			
Date: 04/20/05	Proposed FY: 09	Bldg. No. N234 & N238	Prelim. Cost Estimate \$1.25M
Category: (Choose PD or MS, then indicate Discrete or Minor)	Program Direct:	Discrete:	Minor:
	Mission Support: X	Discrete:	Minor:
Org. Code: TSF M/S: 229-4	Advocate: Joseph Hartman Ext: 4-5269	User: (If not Advocate)	Cost Estimator:

Project Identification

Summary Project Description:

Explain what facility or environmental related work needs to be done at an overview level.

An upgrade to the Data Acquisition Systems of the Ames Arc Jet Complex is desired to better protect the data systems from the harsh arc jet test environment, improve data quality and measurement accuracy, and increase the efficiency of the technician staff that supports arc jet testing. The data systems need improved protection from the high levels of electromagnetic interference and potential arc strikes onto models and instrumentation, which is created by the partially ionized flow and arc heater power supplies. The upgrade would procure high-precision isolation amplifiers, which can make accurate measurements in such adverse conditions, and integrate them into the data system front-end. The project would also include automated calibration hardware and programming, such that the amplifiers could be maintained at a high accuracy with minimal technician effort.

Justification:

Should include justification for urgency and impact to Center Mission. Give specific reference to enterprises or programs/projects where possible.

During the recent review of NASA's core competencies, Ames Research Center was sited as a key center for Entry, Descent, and Landing Systems, specifically for its expertise in Thermal Protection Systems (TPS) and Technologies. One critical element of this expertise is the Arc Jet Complex whose facilities have provided

CoF Project Initiation Form

materials and systems testing for nearly every NASA spacecraft that has entered an atmosphere, be it that of Earth, Mars, Jupiter, or even Saturn's moon, Titan.

In order to perform hypersonic and TPS testing in the Arc Jet Complex, an arc jet facility uses a stable, high-power, electric arc to heat the gas stream to such extreme temperatures (more than 10,000 °F) that it is partially converted into ionized plasma. Both the electrically conductive plasma and the electromagnetic interference, introduced by the power supplies, one of which is designed to exceed 75 Megawatts of continuous, direct current power, present a significant hazard to the sensitive electronic instruments that are used to make measurements of the materials and models. In the most powerful facility in the complex, the Interaction Heating Facility (IHF), electromagnetic fields on the order of hundreds of volts can be detected when the arc initially strikes. These pulses can be picked up on thermocouples, which provide signals that are only millivolts in strength. Because the arc jet stream has been partially ionized, it is significantly more electrically conductive and can charge a test model to high electric potentials. Component failures were common and could result in repair costs exceeding \$10,000 per month before industrial-quality signal isolators were implemented at the IHF to protect the data system from these high voltages. While it is rare, arc jet facilities can experience an arc strike outside of the heater and even onto the test model. With a power supply operating at several thousand volts, such a strike could result in the destruction of hundreds of thousands of dollars of test equipment and significant delays to TPS testing on the critical-path to a spacecraft launch.

The industrial-quality isolators currently in use in the Arc Jet Complex facilities are merely adequate to provide immediate protection of the data acquisition system, but they limit the ultimate accuracy of the data system and require continual evaluation and adjustment to keep the system sufficiently accurate (0.1% or better). With precision isolation amplifiers, this concern is eliminated with components that typically perform to 0.02% accuracy, far closer to that of the analog-to-digital converters in use. In addition, modern, computer-controlled components allow automated calibration to quickly and easily confirm or improve accuracy. This improved accuracy is required to improve the fidelity of the arc jet simulation and provide increased data quality to critical reentry systems development projects.

Current mission testing that would benefit from the proposed upgrade include:

- In-Space Propulsion (ISP) Program – Aerocapture TPS design and sensors
- X-37 prototype reusable entry vehicle program
- Space Shuttle Return to Flight (RTF) – Repair materials and methods
- Space Shuttle External Tank (ET) Program – Improved insulation foam
- Mars Scientific Laboratory (MSL) Program – Probe entry shell TPS

The proposed facility enhancement will allow the facility to meet the stringent requirements imposed by these and future programs, ensuring continued, high-quality materials testing capability.

CoF Project Initiation Form

Project Scope, Elements:

This project will consist of the following elements:

- 1) Specify and procure precision isolation amplifiers and the auxiliary components (chassis, data acquisition boards, etc.) required to support them.
- 2) Develop software to implement automated calibration of the amplifiers.
- 3) Re-program the data acquisition system software to integrate amplifier calibration, configuration, and use.

The following items will have to be conducted around scheduled arc jet testing and planned to result in the minimal practical downtime:

- 4) Install or modify data acquisition system enclosures to house the new amplifier components.
- 5) Incorporate amplifiers into the data system infrastructure of the Arc Jet Data Acquisition Systems.
- 6) Install components to provide automated calibration of the amplifier units.

CoF Project Initiation Form

Cost Estimate Information, Miscellaneous Supporting Materials:

Breakdown should match scope, and elements from above and include an estimate for design.

The cost estimate below is preliminary. An engineering study has yet to be conducted to refine the projected cost and scope details.

Isolation Amplifiers for IHF, AHF, PTF, and DAF (approx. 50 channels per facility + chassis)	\$750k
Enclosure Components	\$30k
Equipment Installation (Labor)	\$240k
Programming Support (Labor)	\$70k
Management, Overhead, and Contingency	\$160k
<hr/>	
Construction Total	\$1,250k

CoF Project Initiation Form

ENVIRONMENTAL CHECKLIST

Part A:

1. Will this activity result in changes of potable water use greater than 851,000 gallons/year
2. Will this activity result in a change in employment levels greater than 620 people?
3. Will there be any construction or other activity north of Allen Road (flood plain and wetlands areas)?
4. Will there be any action which could or will affect any threatened or endangered species (north Allen Road)?
- 5) Will there be any action affecting areas of historical (Moffett Shenandoah Plaza area, Hanger One) or archaeological significance (directly west of the OARF)?

Yes	No	Maybe
	X	
	X	
Part B:

- 1) Discharge of any substances into the air, surface or ground water, sanitary sewer, or soils.
- 2) Removal of vegetation or destruction of wildlife habitat or grading activities.
- 3) Acquisition, use, generation, storage, or disposal of any toxic or hazardous substances.
- 4) Generation of hazardous, toxic, or radiological wastes.
- 5) Generation of ionizing or non-ionizing radiation.
- 6) Generation of high noise levels (above 80 dBa).
- 7) Activities resulting in changes of greater than 2,200,000 KWH of electricity, or 3,130,000 CF of natural gas per year for Ames' energy consumption.
- 8) Use of pesticides, including insecticides, herbicides, fungicides, and rodenticides.
- 9) Construction or modification of a sewage collection or transmission system.

Yes	No	Maybe
	X	
	X	
**CoF Project Initiation Form -
Steam Vacuum System NOx Emission Reduction System [N238A]**

CoF Project Initiation Form

Proposed Project Title: Steam Vacuum System NO _x Emission Reduction System			
Date: 20 Apr 2005	Proposed FY: 09	Bldg. No. N238A	Prelim. Cost Estimate \$2.40M
Category: (Choose PD or MS, then indicate Discrete or Minor)	Program Direct:	Discrete:	Minor:
	Mission Support: X	Discrete:	Minor:
Org. Code: TSF M/S: 229-4	Advocate: Joseph Hartman Ext: 4-5269	User: (If not Advocate)	Cost Estimator:

Project Identification

Summary Project Description:

Explain what facility or environmental related work needs to be done at an overview level.

The Ames Arc Jet Complex is the largest arc jet facility of its type in the United States. The complex is composed of a number of individual test legs including the Interaction Heating Facility (IHF), the Aerodynamic Heating Facility (AHF), and the Panel Test Facility (PTF). The Ames arc jets provide super-heated air at hypersonic speeds to simulate the high-temperature flows experienced by spacecraft reentering planetary atmospheres. As consequence of heating air at temperatures up to 10,000 K, a significant amount of pollutants in the form of nitrogen oxides (NO_x) are also produced. Left untreated, these NO_x emissions would need to be vented directly to the atmosphere in direct conflict with local, state, and federal air emission regulations. The arc jet facility currently provides a NO_x scrubber system designed to remove these pollutants to levels that meet all required air emission regulations. However, the current system is over 30 years old and nearing the end of its useful life. To ensure interrupted facility operation, a replacement of this system is required within the next few years to ensure that emissions from the facility continue to meet air regulations. This project will design, fabricate, and install a new NO_x emission reduction system to replace the existing aging and deteriorating scrubber system with newer and more maintainable system.

Justification:

Should include justification for urgency and impact to Center Mission. Give specific reference to enterprises or programs/projects where possible.

The Ames Arc Jet Complex was designed and constructed in the late 1960's and early 1970's to validate the thermal performance of reentry thermal protection systems (TPS). It has been used to test the design of virtually every TPS employed on NASA missions for the last thirty years. The Arc Jet Complex continues to be a key facility for the development of current and future spacecraft and supports NASA's key mission goals of planetary and near earth orbit exploration for both manned and unmanned vehicles. Since its initial construction, NASA missions have continued use of the arc jets, which, with the use of the air emission reduction system, allow the facility to meet all required air emission standards. It is anticipated that within the next several years the facility may no longer be able to meet key current and future air emission requirements with the current infrastructure. To ensure continued compliance with local, state, and federal laws, a replacement air emission reduction system described here will be needed.

Current mission testing requirements that require the proposed upgrade include:

- In-Space Propulsion Program (ISP)
- X-37 prototype reusable launch vehicle program
- Space Shuttle Return to Flight (RTF) Testing
- Space Shuttle External Tank (ET) Program
- Mars Scientific Laboratory (MSL) Program

The proposed facility enhancement will allow the facility to continue to meet the requirements imposed by these and future program ensuring NASA's continued materials testing capability.

Project Scope, Elements:

This project will consist of the following elements:

- 1) Development of the necessary emission levels requirements to meet or exceed current and anticipated future legal requirements.
- 2) Identification and conceptual design of possible emission reduction system configuration meeting the requirements in item 1 above.
- 3) Detailed design of the specific emission reduction device including chemical, structural, and mechanical phases in sufficient detail to provide for fabrication of the device.
- 4) Fabrication of the actual emission reduction device.
- 5) Identification and design development of facility modifications required to install, operate, and maintain the emission reduction device. This includes structural, cooling water, electrical, and control modifications.
- 6) Construction modifications of the existing facility in order to accept the new emission reduction device.
- 7) Installation and integration of the emission reduction device into the IHF facility.

- 8) Facility shakedown and validation testing of the new emission reduction device.

Cost Estimate Information, Miscellaneous Supporting Materials:

Breakdown should match scope, and elements from above and include an estimate for design.

	Hours	Amount
Design		
Chemical Design	550	\$79,200
Structural Design	400	\$57,600
Mechanical Design	600	\$86,400
Management	155	\$22,320
Sub Total		\$245,520
Fabrication		\$1,350,000
Construction		
Permitting, Environmental		\$85,000
Site Preparation		\$280,000
Installation		\$410,000
Management		\$69,000
Sub Total		\$759,000
Validation		
Engineering	200	\$28,800
Mechanical Modification	100	\$14,400
Management	30	\$4,320
Sub Total		\$47,520
Total		\$2,402,040

ENVIRONMENTAL CHECKLIST

Part A:

1. Will this activity result in changes of potable water use greater than 851,000 gallons/year
2. Will this activity result in a change in employment levels greater than 620 people?
3. Will there be any construction or other activity north of Allen Road (flood plain and wetlands areas)?
4. Will there be any action which could or will affect any threatened or endangered species (north Allen Road)?
- 5) Will there be any action affecting areas of historical (Moffett Shenandoah Plaza area, Hanger One) or archaeological significance (directly west of the OARF)?

Yes	No	Maybe
	X	
	X	
Part B:

- 1) Discharge of any substances into the air, surface or ground water, sanitary sewer, or soils.
- 2) Removal of vegetation or destruction of wildlife habitat or grading activities.
- 3) Acquisition, use, generation, storage, or disposal of any toxic or hazardous substances.
- 4) Generation of hazardous, toxic, or radiological wastes.
- 5) Generation of ionizing or non-ionizing radiation.
- 6) Generation of high noise levels (above 80 dBa).
- 7) Activities resulting in changes of greater than 2,200,000 KWH of electricity, or 3,130,000 CF of natural gas per year for Ames' energy consumption.
- 8) Use of pesticides, including insecticides, herbicides, fungicides, and rodenticides.
- 9) Construction or modification of a sewage collection or transmission system.

Yes	No	Maybe
	X	
	X	
**CoF Project Initiation Form -
Semi-Elliptical Nozzle for Interaction Heating Facility [N-238]**

CoF Project Initiation Form

Proposed Project Title: Semi-Elliptical Nozzle for Interaction Heating Facility			
Date: 04/18/2005	Proposed FY: 09	Bldg. No. N238	Prelim. Cost Estimate \$3.64 M
Category: (Choose PD or MS, then indicate Discrete or Minor)	Program Direct:	Discrete:	Minor:
	Mission Support: X	Discrete:	Minor:
Org. Code: TSF	Advocate: Joseph Hartman	User: (If not Advocate)	Cost Estimator:
M/S: 229-4	Ext: 4-5269		

Project Identification

Summary Project Description:

Explain what facility or environmental related work needs to be done at an overview level.

The Interaction Heating Facility (IHF) is NASA's largest constricted arc jet facility. The IHF provides super-heated gas at hypersonic speeds to simulate the high-temperature flows experienced by spacecraft entering planetary atmospheres. Candidate thermal protection materials, TPS, in single sample or in assemblies, are tested under simulated heating conditions of hypersonic entry into Earth, Mars, or other planet's atmospheres. Experiments in IHF provide data that is critical to the design and success of human spaceflight programs and to scientific planetary spacecraft missions.

One of the critical elements of the IHF, the semi-elliptical nozzle, provides unique boundary-layer flows over large, 80cm x 80 cm test panels, simulating a portion of TPS acreage on a spacecraft. The nozzle is a highly water-cooled copper assembly that must absorb the high heat fluxes generated by the intensely hot internal gas flows. The thermal design requirements are similar to that of a rocket nozzle, though it is operated in a ground facility in the N238 laboratory. The present nozzle, after about 3 years of service, is showing severe degradation in its shape and strength of materials caused by lack of adequate water cooling. A previous nozzle of exactly similar design also degraded in the same fashion. Fabricating more nozzles using the same design would be futile in that there would be no improvement in safety, reliability, or performance. A new nozzle design is therefore required with an improved water-cooling scheme. The scope of this project is to complete the design

CoF Project Initiation Form

and fabrication of a new semi-elliptical nozzle that will safely operate over a period of 20 years without degrading or warping.

Justification:

Should include justification for urgency and impact to Center Mission. Give specific reference to enterprises or programs/projects where possible.

The IHF arc jet facility was designed and constructed in the early 1970's to validate the thermal performance of reentry thermal protection systems (TPS). It has been used to test and validate the design of virtually every TPS employed on NASA missions for the last thirty years. The IHF facility continues to be a critical facility for the development of current and future spacecraft and supports NASA's key mission goals of planetary and near-earth orbit exploration for both human and robotic space vehicles. Failure of the semi-elliptical nozzle, a key component of the facility, would result in significant down time and delay of acquiring critical test data. The time to build a replacement is approximately 8 to 12 months. A spare nozzle exists now and yet it has demonstrated the same operational problems. Fabricating more spares is not cost efficient and therefore not recommended as a solution.

Since the initial construction of the IHF, NASA mission requirements have expanded to include longer duration tests and higher power levels. Current semi-elliptical nozzle hardware has experienced significant degrading manifested as warping and materials overheating. These have lead to altering the shape of the nozzle through which the test gas flows, and to leaks of high pressure cooling water. The warping is due to excess thermal stress because of inadequate water cooling. Warping degrades the flow quality and has lead to weeping water leaks. The quality and safety of operations are being compromised by these problems. The faulty design of the water cooling passages has been identified as the direct cause of these issues with existing hardware. Designing a new semi-elliptical nozzle using new, copper electroforming technology that will incorporate improved water cooling passages can avoid these issues. This forming technology has already been demonstrated in other NASA ground test facility nozzles. It must be recognized that the design of this type of hardware borders on the limits of convection-cooling techniques close to material limits of temperature and pressure because of the severe high heating loads that the nozzle experiences in normal operation.

The goal is to successfully design and operate the nozzle which can absorb a heat flux of over 6000 W/sq.cm. continuously for hours, survive multiple exposures per day, and have a life expectancy of twenty years. The internal flow contours for the super-heated test gas will not be significantly altered from the present design. The proposed new semi-elliptical nozzle will allow NASA to meet the more stringent testing requirements imposed by present and future programs and to ensure NASA's continued arc-jet testing capability. It will improve operations by eliminating the present high pressure leaks and nozzle warping which compromise the integrity and quality of arc jet testing.

CoF Project Initiation Form

Current mission testing requirements that require the proposed upgrade include:

- In-Space Propulsion Program (ISP)
- X-37 prototype reusable launch vehicle program
- Space Shuttle Return to Flight (RTF) Testing
- Space Shuttle External Tank (ET) Program
- Mars Scientific Laboratory (MSL) Program

Project Scope, Elements:

This project will consist of the following elements:

- 1) Development of the maximum heat flux to be absorbed, and the distribution of heating. This will provide the requirements to adequately cool the nozzle using high pressure cooling water (flow and pressure requirements). Advanced computational tools and engineering correlations will be used to complete this task element.
- 2) Identify and produce conceptual design(s) of cooling passages that meet thermal and structural loads.
- 3) Detailed design of the semi-elliptical nozzle throat including thermal, structural, and mechanical phases in sufficient detail to provide for fabrication of the assembly. Detailed three-dimensional solid models will be generated and analyzed to complete this element.
- 4) Fabrication of the hardware.
- 5) Identification and design development of facility modifications (if any) that are required to install, operate, and maintain the new nozzle. This includes structural, cooling water, electrical, and control modifications.
- 6) Inspection, assembly, test, and final acceptance of the new semi-elliptical nozzle hardware.
- 7) Installation and integration of the nozzle into the IHF arc jet.
- 8) Facility shakedown and validation testing of the new nozzle.

CoF Project Initiation Form

Cost Estimate Information, Miscellaneous Supporting Materials:

Breakdown should match scope, and elements from above and include an estimate for design.

The cost estimate below is a preliminary. An engineering study has yet to be conducted to refine the projected cost and scope details.

Preliminary requirements study	\$0.55 M
Detailed design and shop-ready drawings	\$0.50 M
Manufacturing the nozzle	\$1.75 M
Inspection, Test, and Assembly	\$0.23 M
Construction Management, Contingency	<u>\$0.61 M</u>
Construction Total	\$3.64 M

CoF Project Initiation Form

ENVIRONMENTAL CHECKLIST

Part A:

1. Will this activity result in changes of potable water use greater than 851,000 gallons/year
2. Will this activity result in a change in employment levels greater than 620 people?
3. Will there be any construction or other activity north of Allen Road (flood plain and wetlands areas)?
4. Will there be any action which could or will affect any threatened or endangered species (north Allen Road)?
5. Will there be any action affecting areas of historical (Moffett Shenandoah Plaza area, Hanger One) or archaeological significance (directly west of the OARF)?

Yes	No	Maybe
	X	
	X	
Part B:

- 1) Discharge of any substances into the air, surface or ground water, sanitary sewer, or soils.
- 2) Removal of vegetation or destruction of wildlife habitat or grading activities.
- 3) Acquisition, use, generation, storage, or disposal of any toxic or hazardous substances.
- 4) Generation of hazardous, toxic, or radiological wastes.
- 5) Generation of ionizing or non-ionizing radiation.
- 6) Generation of high noise levels (above 80 dBA).
- 7) Activities resulting in changes of greater than 2,200,000 KWH of electricity, or 3,130,000 CF of natural gas per year for Ames' energy consumption.
- 8) Use of pesticides, including insecticides, herbicides, fungicides, and rodenticides.
- 9) Construction or modification of a sewage collection or transmission system.

Yes	No	Maybe
	X	
	X	
A NEW PERSPECTIVE IN PRESERVATION

PAGE & TURNBULL, INC.

724 Pine Street, San Francisco, California 94108

415.362.5154 / www.page-turnbull.com